

PREPARED FOR:
MIKE MILLER
6517 KINGSBRIDGE DR.
CARY, IL 60013


PLAT OF SURVEY

-OF-

LOT D IN LOCH VISTA CLUB NO. 2 IN THE VILLAGE OF WILLIAMS BAY,
ACCORDING TO THE PLAT THEREOF ON RECORD IN THE OFFICE OF
THE REGISTER OF DEEDS IN AND FOR WALWORTH COUNTY, WISCONSIN.


LYNCH & ASSOCIATES
ENGINEERING CONSULTANTS, LLC.

5482 S. WESTRIDGE DR.
NEW BERLIN, WI 53151
(262) 248-3697

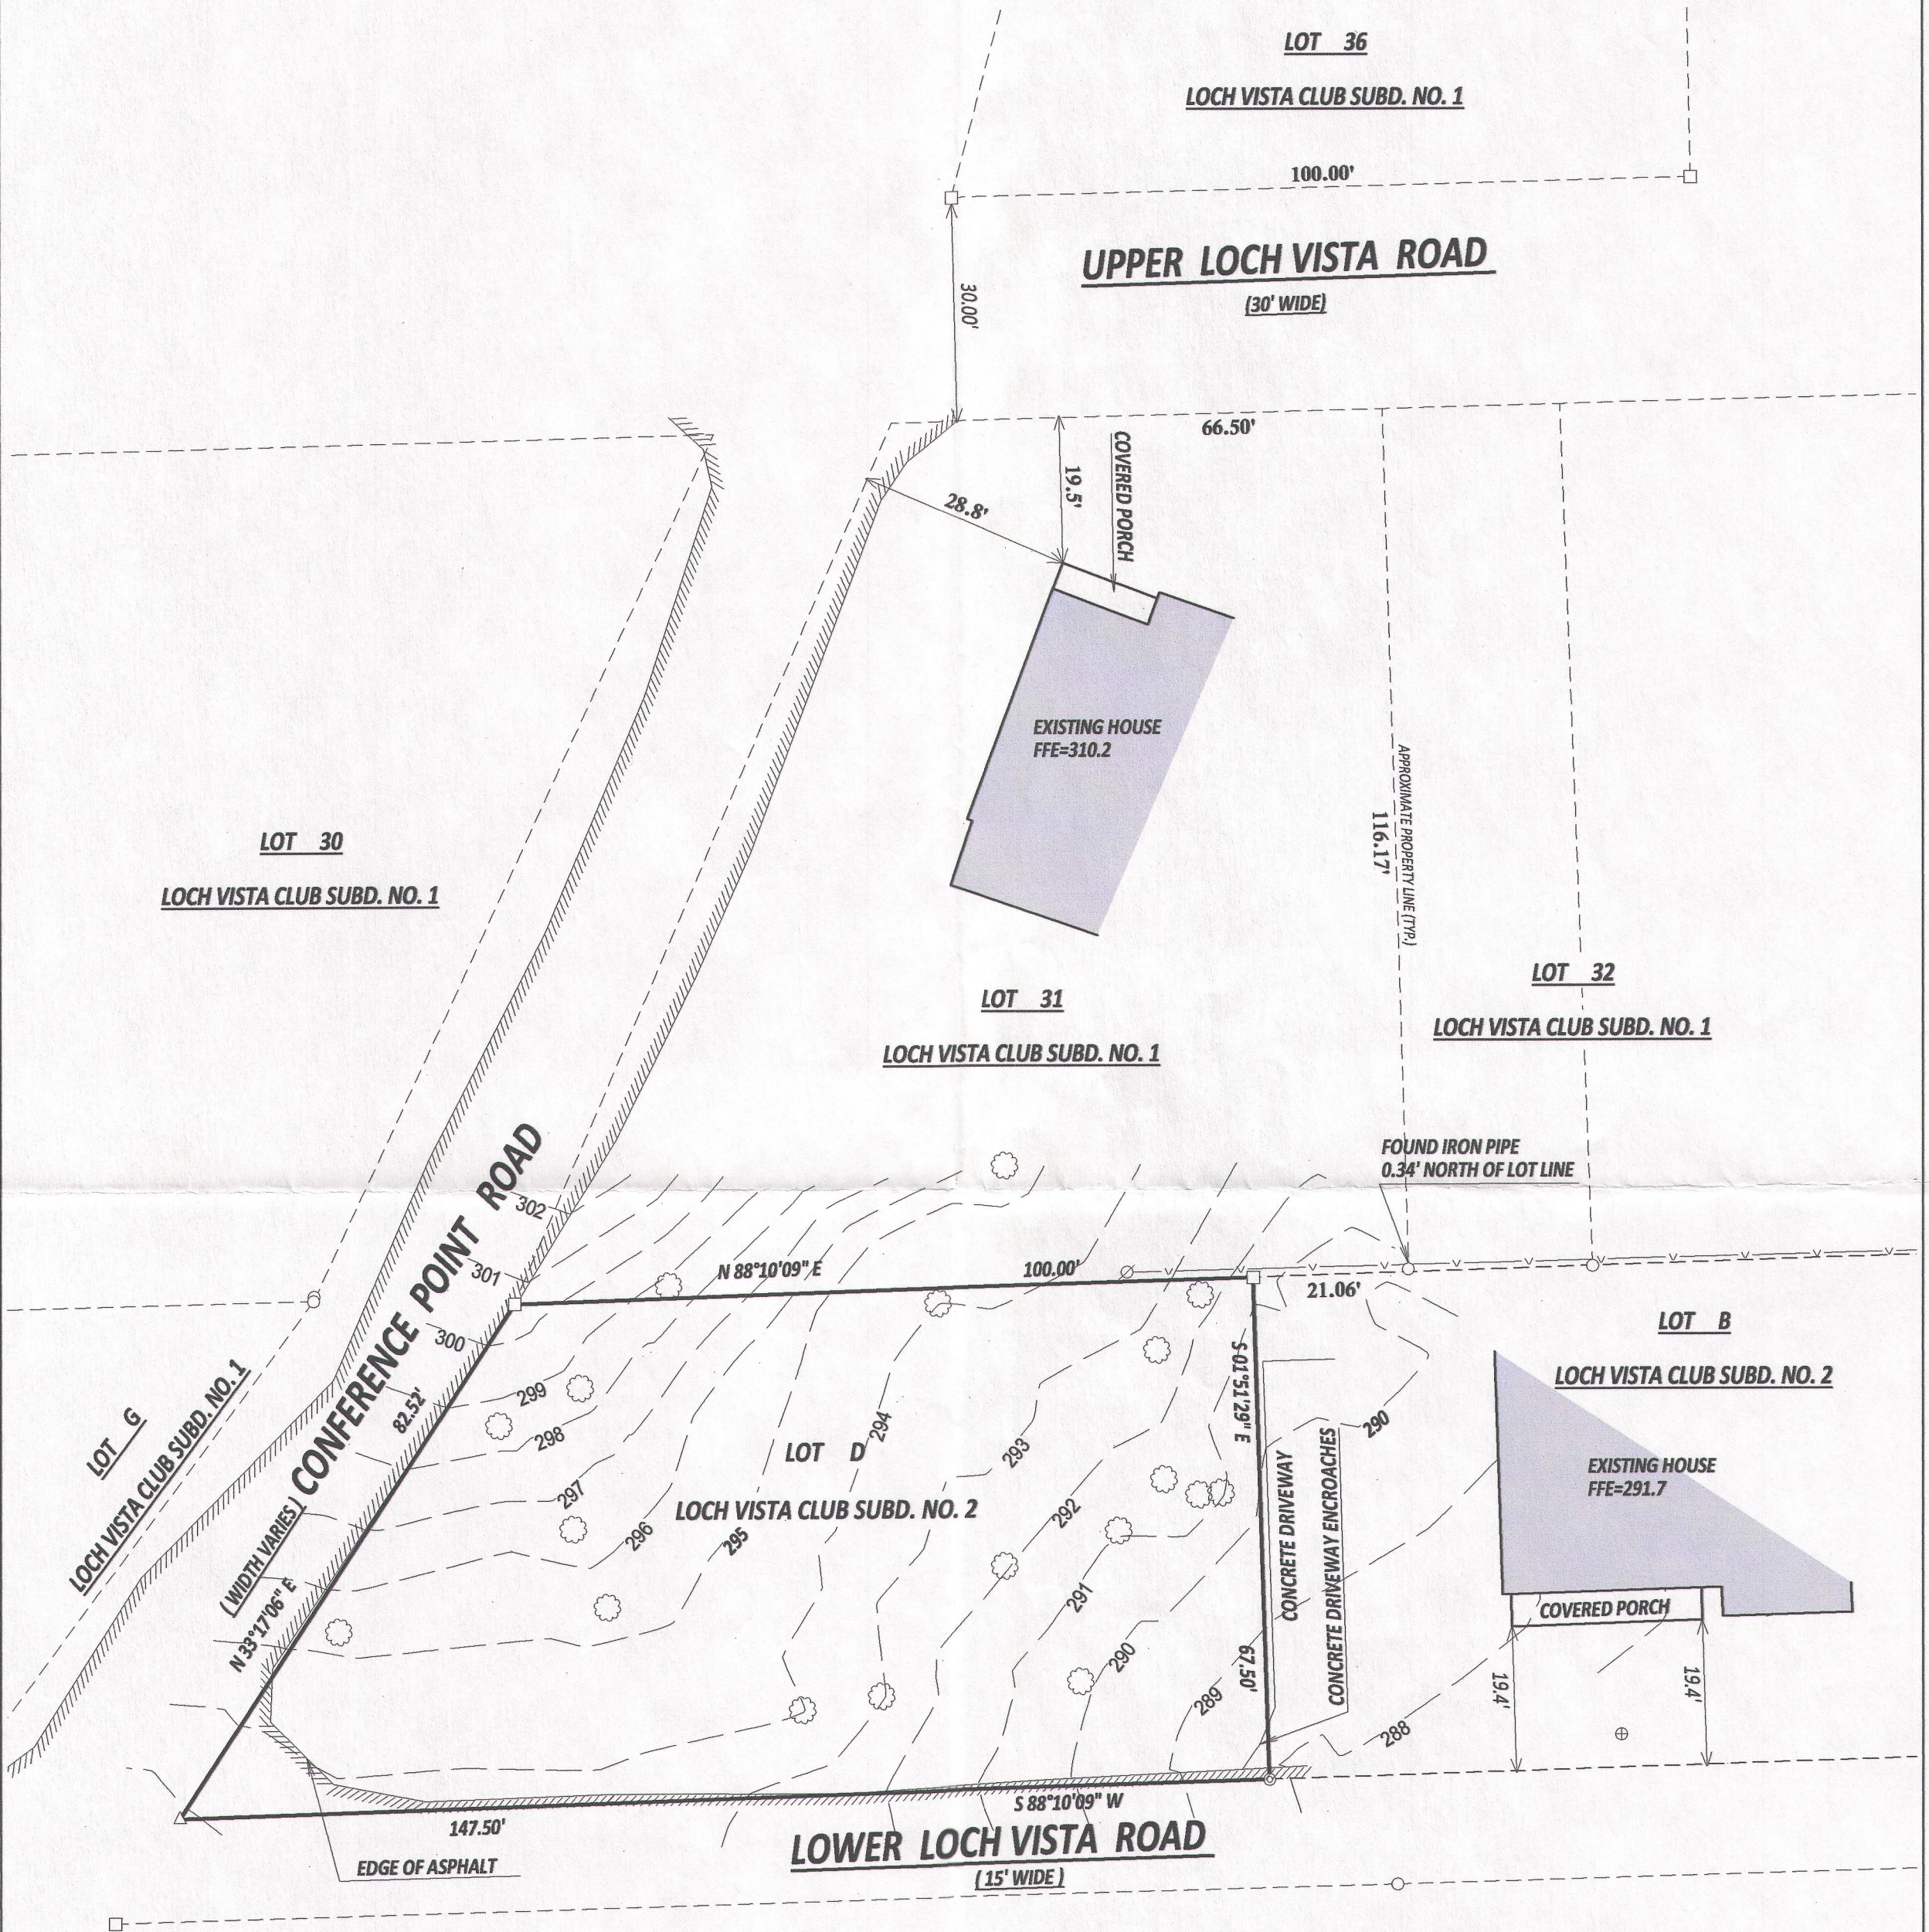

LEGEND

- △ SET P.K. NAIL IN ASPHALT
- ⊗ UTILITY POLE
- ⊕ STEEL ACCESS COVER
- ⊙ FOUND RAILROAD SPIKE
- OVER HEAD UTILITIES
- FOUND 1" IRON PIPE
- FOUND 5/8" IRON BAR
- (xx) RECORDED AS
- ⊙ EXISTING TREE

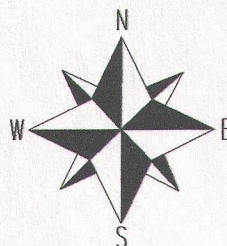

BEARINGS REFERENCED TO THE
RECORD PLAT OF LOCH VISTA CLUB
SUBDIVISION NO. 3



SCALE 1"=20'

NOTE:

No title commitment or results of a title search were provided to this office pertaining to this survey. This Plat Of Survey may not reflect easements of record, encumbrances, restrictions, ownership, title evidence, or other facts that a current and accurate title search may disclose.

I have surveyed the above-described property and the above map is a true representation thereof and shows the size and location of the property, its exterior boundaries, the location and dimensions of all structures thereon, fences apparent easements and roadways and visible encroachments, if any.

This survey is made for the exclusive use of the present owners of the property, and also those who purchase, mortgage, or insure the title thereto within one (1) year from date hereof; and as to them I warrant the accuracy of said survey map.

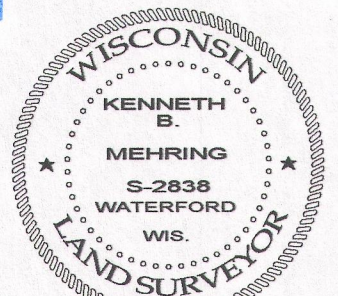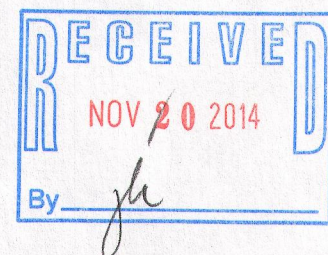

DATED THIS 31st DAY OF OCTOBER, 2014
REVISED THIS 4th DAY OF NOVEMBER, 2014
LAST REVISED THIS 13th DAY OF NOVEMBER, 2014

KENNETH B. MEHRING S - 2838
Wisconsin Registered Land Surveyor
(original if signed in red)