

PREPARED FOR
LINDA TONGE
KEEFE REAL ESTATE
LAKE GENEVA WI


PLAT OF SURVEY

- OF -

LOT 66 OF CEDAR POINT PARK, LOCATED IN THE EAST 1/2
OF FRACTIONAL SECTIONS 6 AND 7, TOWN 1 NORTH, RANGE
17 EAST, VILLAGE OF WILLIAMS BAY, WALWORTH COUNTY,
WISCONSIN.

ALSO LOT 228 OF AFORESIAD SUBDIVISION WHICH, SAID
LOT 66 HAS 1/4 INTEREST.

PATHFINDER SURVEYING INC.
(formerly)
J.K. SURVEYING INC.
P.O BOX 322
LAKE GENEVA, WI. 53147
WWW.PATHFINDERSURVEYING.NET
262-248-8303

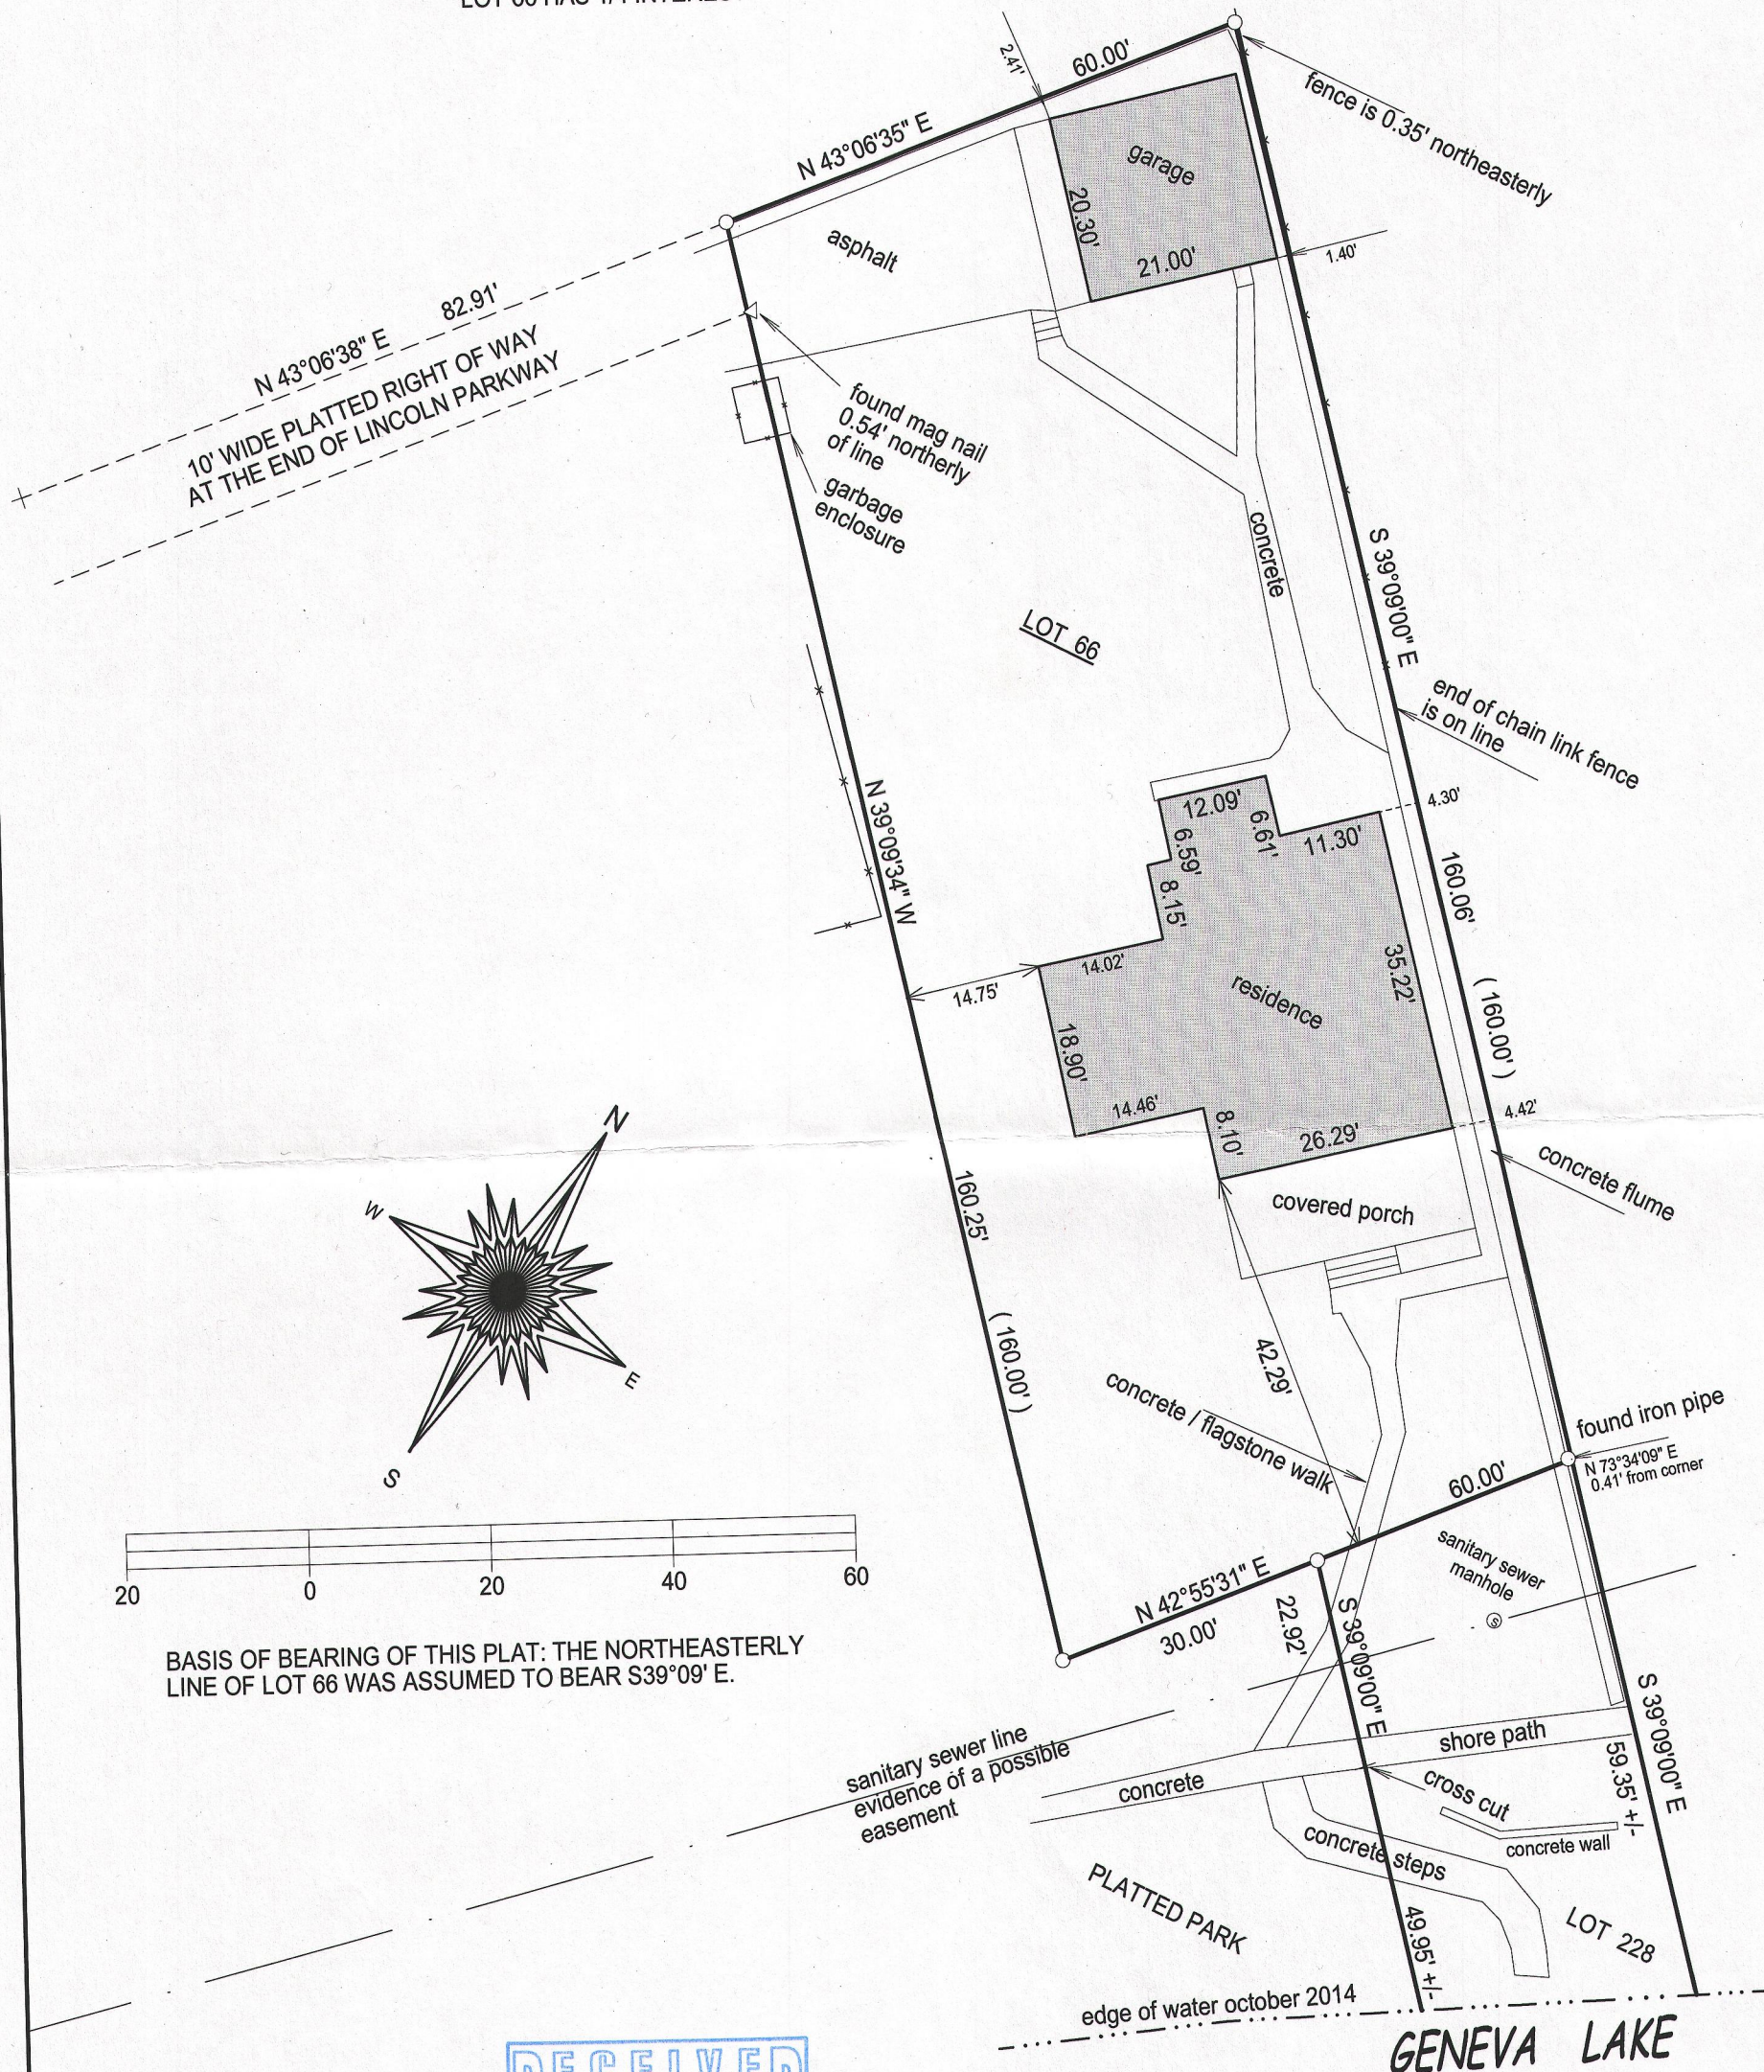


BASIS OF BEARING OF THIS PLAT: THE NORTHEASTERLY
LINE OF LOT 66 WAS ASSUMED TO BEAR S39°09' E.

- () = recorded as
- = found iron bar
- = found iron pipe
- = set iron pipe
- = set iron bar

SCALE 1" = 20'

JOB # 14-247


TAX ID #
WCP00052
WCP00204

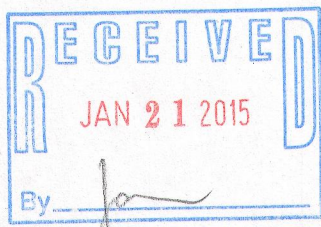

I hereby certify that I have surveyed the above- described property and the
above map is a true representation thereof and shows the size and
location of the property, its exterior boundaries, the location and
dimensions of all structures thereon, fences, apparant easements and
roadways and visible encroachments if any.

This survey is made for the present owners of the property, and those who
purchase, mortgage, or guarantee the title thereto, within one year from
the date hereof.

DATED THIS 14TH DAY OF OCTOBER, 2014.

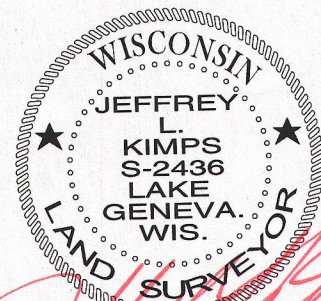

JEFFREY L. KIMPS S - 2436
Wisconsin Registered Land Surveyor
(original if signed in red)

WCP-52
WCP-204

011-2559