
PLAT OF SURVEY

OF

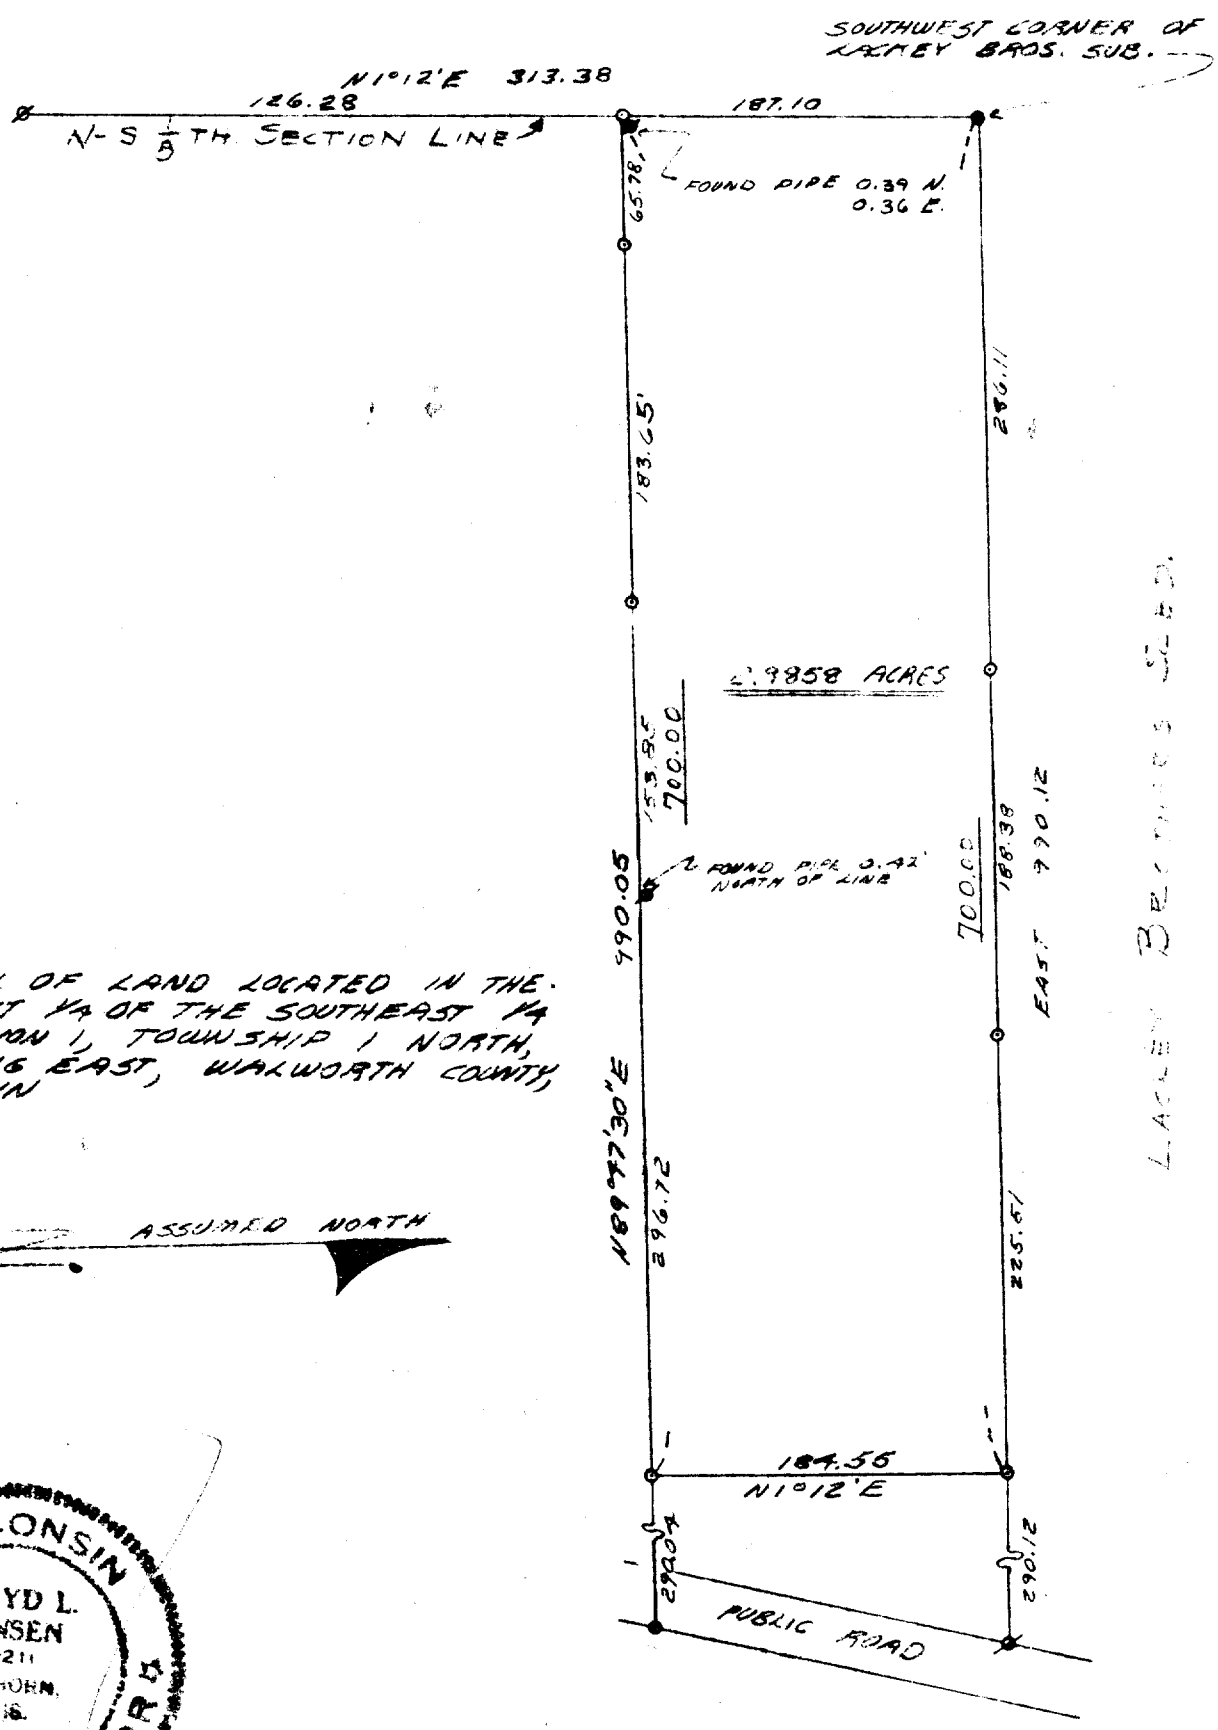

A PARCEL OF LAND LOCATED IN THE SOUTHEAST ¼ OF THE SOUTHEAST ¼ OF SECTION 1, TOWNSHIP 1 NORTH, RANGE 16 EAST, WALWORTH COUNTY, WISCONSIN

WISCONSIN LLOYD L. JENSEN S-211 ELKHORN, WIS. LAND SURVEYOR

LEGEND

- ∅ — Iron Pipe *Found*
- ● — Concrete Monument *FOUND*

Scale 1" = 100'

- o — IRON PIPE SET

SURVEY AND PLAT BY

JENSEN & JOHNSON, INC.

CIVIL ENGINEERS AND SURVEYORS

Elkhorn, Wisconsin

WE CERTIFY: That we have surveyed the above described property and that the plat shown hereon is an accurate survey and a true representation thereof and correctly shows the exterior boundary lines and all divisions of said property.

Date JUNE 1971

Lloyd L Jensen

LLOYD L. JENSEN,

Wisconsin Registered Land Surveyor, No. S-211

UP-76