
PLAT OF SURVEY
TOPOGRAPHIC MAPPING

LOT 17 IN CEDAR POINT PARK, FIRST ADDITIONA TO THE VILLAGE OF WILLIMAS BAY
LOCATED IN SECTION 6, TOWN 1 NORTH, RANGE 17 EAST,
VILLAGE OF WILLIMAS BAY, WALWORTH COUNTY, WISCONSIN

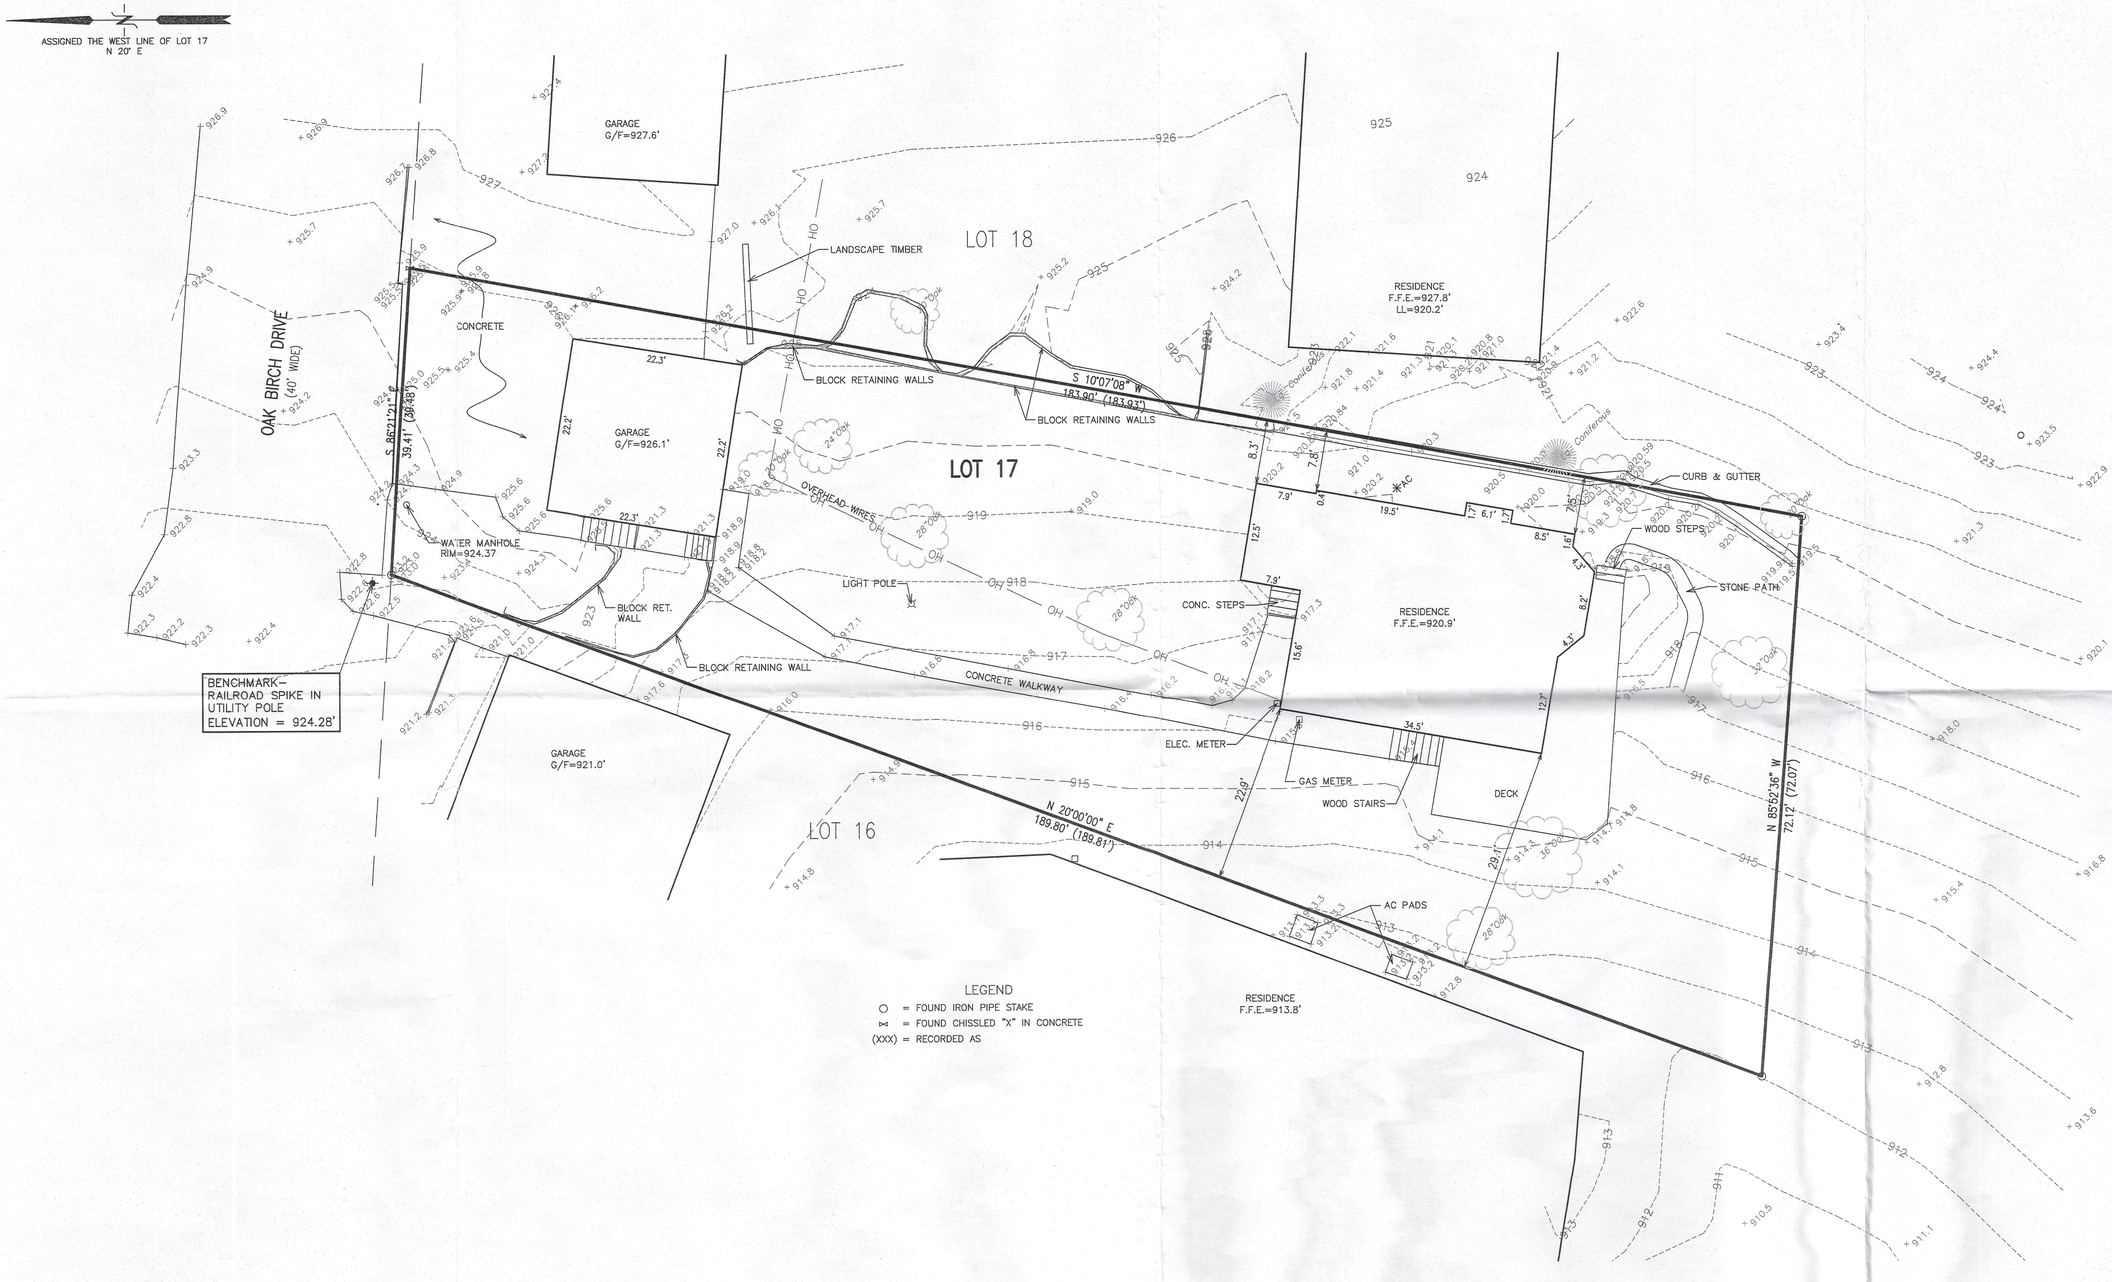

RECEIVED
DEC 8 2015
By jan

NOTE: COPIES OF THIS MAP TO WHICH THE FOLLOWING CERTIFICATE WILL APPLY SHOW THE SURVEYOR'S ORIGINAL SEAL AND SIGNATURE IN RED INK. COPIES BY ANY OTHER MEANS MAY HAVE ALTERATIONS WHICH DO NOT REPRESENT THE SURVEYOR'S WORK PRODUCT.

I HEREBY CERTIFY THAT THE ABOVE DESCRIBED PROPERTY HAS BEEN SURVEYED UNDER MY DIRECTION AND THAT THE ABOVE MAP IS A TRUE REPRESENTATION THEREOF AND SHOWS THE SIZE AND LOCATION OF THE PROPERTY AND ITS EXTERIOR BOUNDARIES. THIS SURVEY IS MADE FOR THE USE OF THE PRESENT OWNERS OF THE PROPERTY, AND ALSO THOSE WHO PURCHASE, MORTGAGE, OR GUARANTEE THE TITLE THERETO WITHIN ONE YEAR FROM THE DATE HEREOF.

WISCONSIN
PETER S. GORDON
S-2101
ELKHORN, WI
LAND SURVEYOR

DATED: 06/30/2015

PETER S. GORDON P.L.S. 2101

X:\Projects\9315\ACAD\9315.dwg

FARRIS, HANSEN & ASSOCIATES, INC.
ENGINEERING – ARCHITECTURE – SURVEYING
P.O. BOX 437
7 RIDGWAY COURT
– WORK ORDERED BY –
FAIRWYN
875 TOWNLINE ROAD, SUITE 103

REVISION

PROJECT 9315
DATE 06/30/2
SHEET N 1 OF