
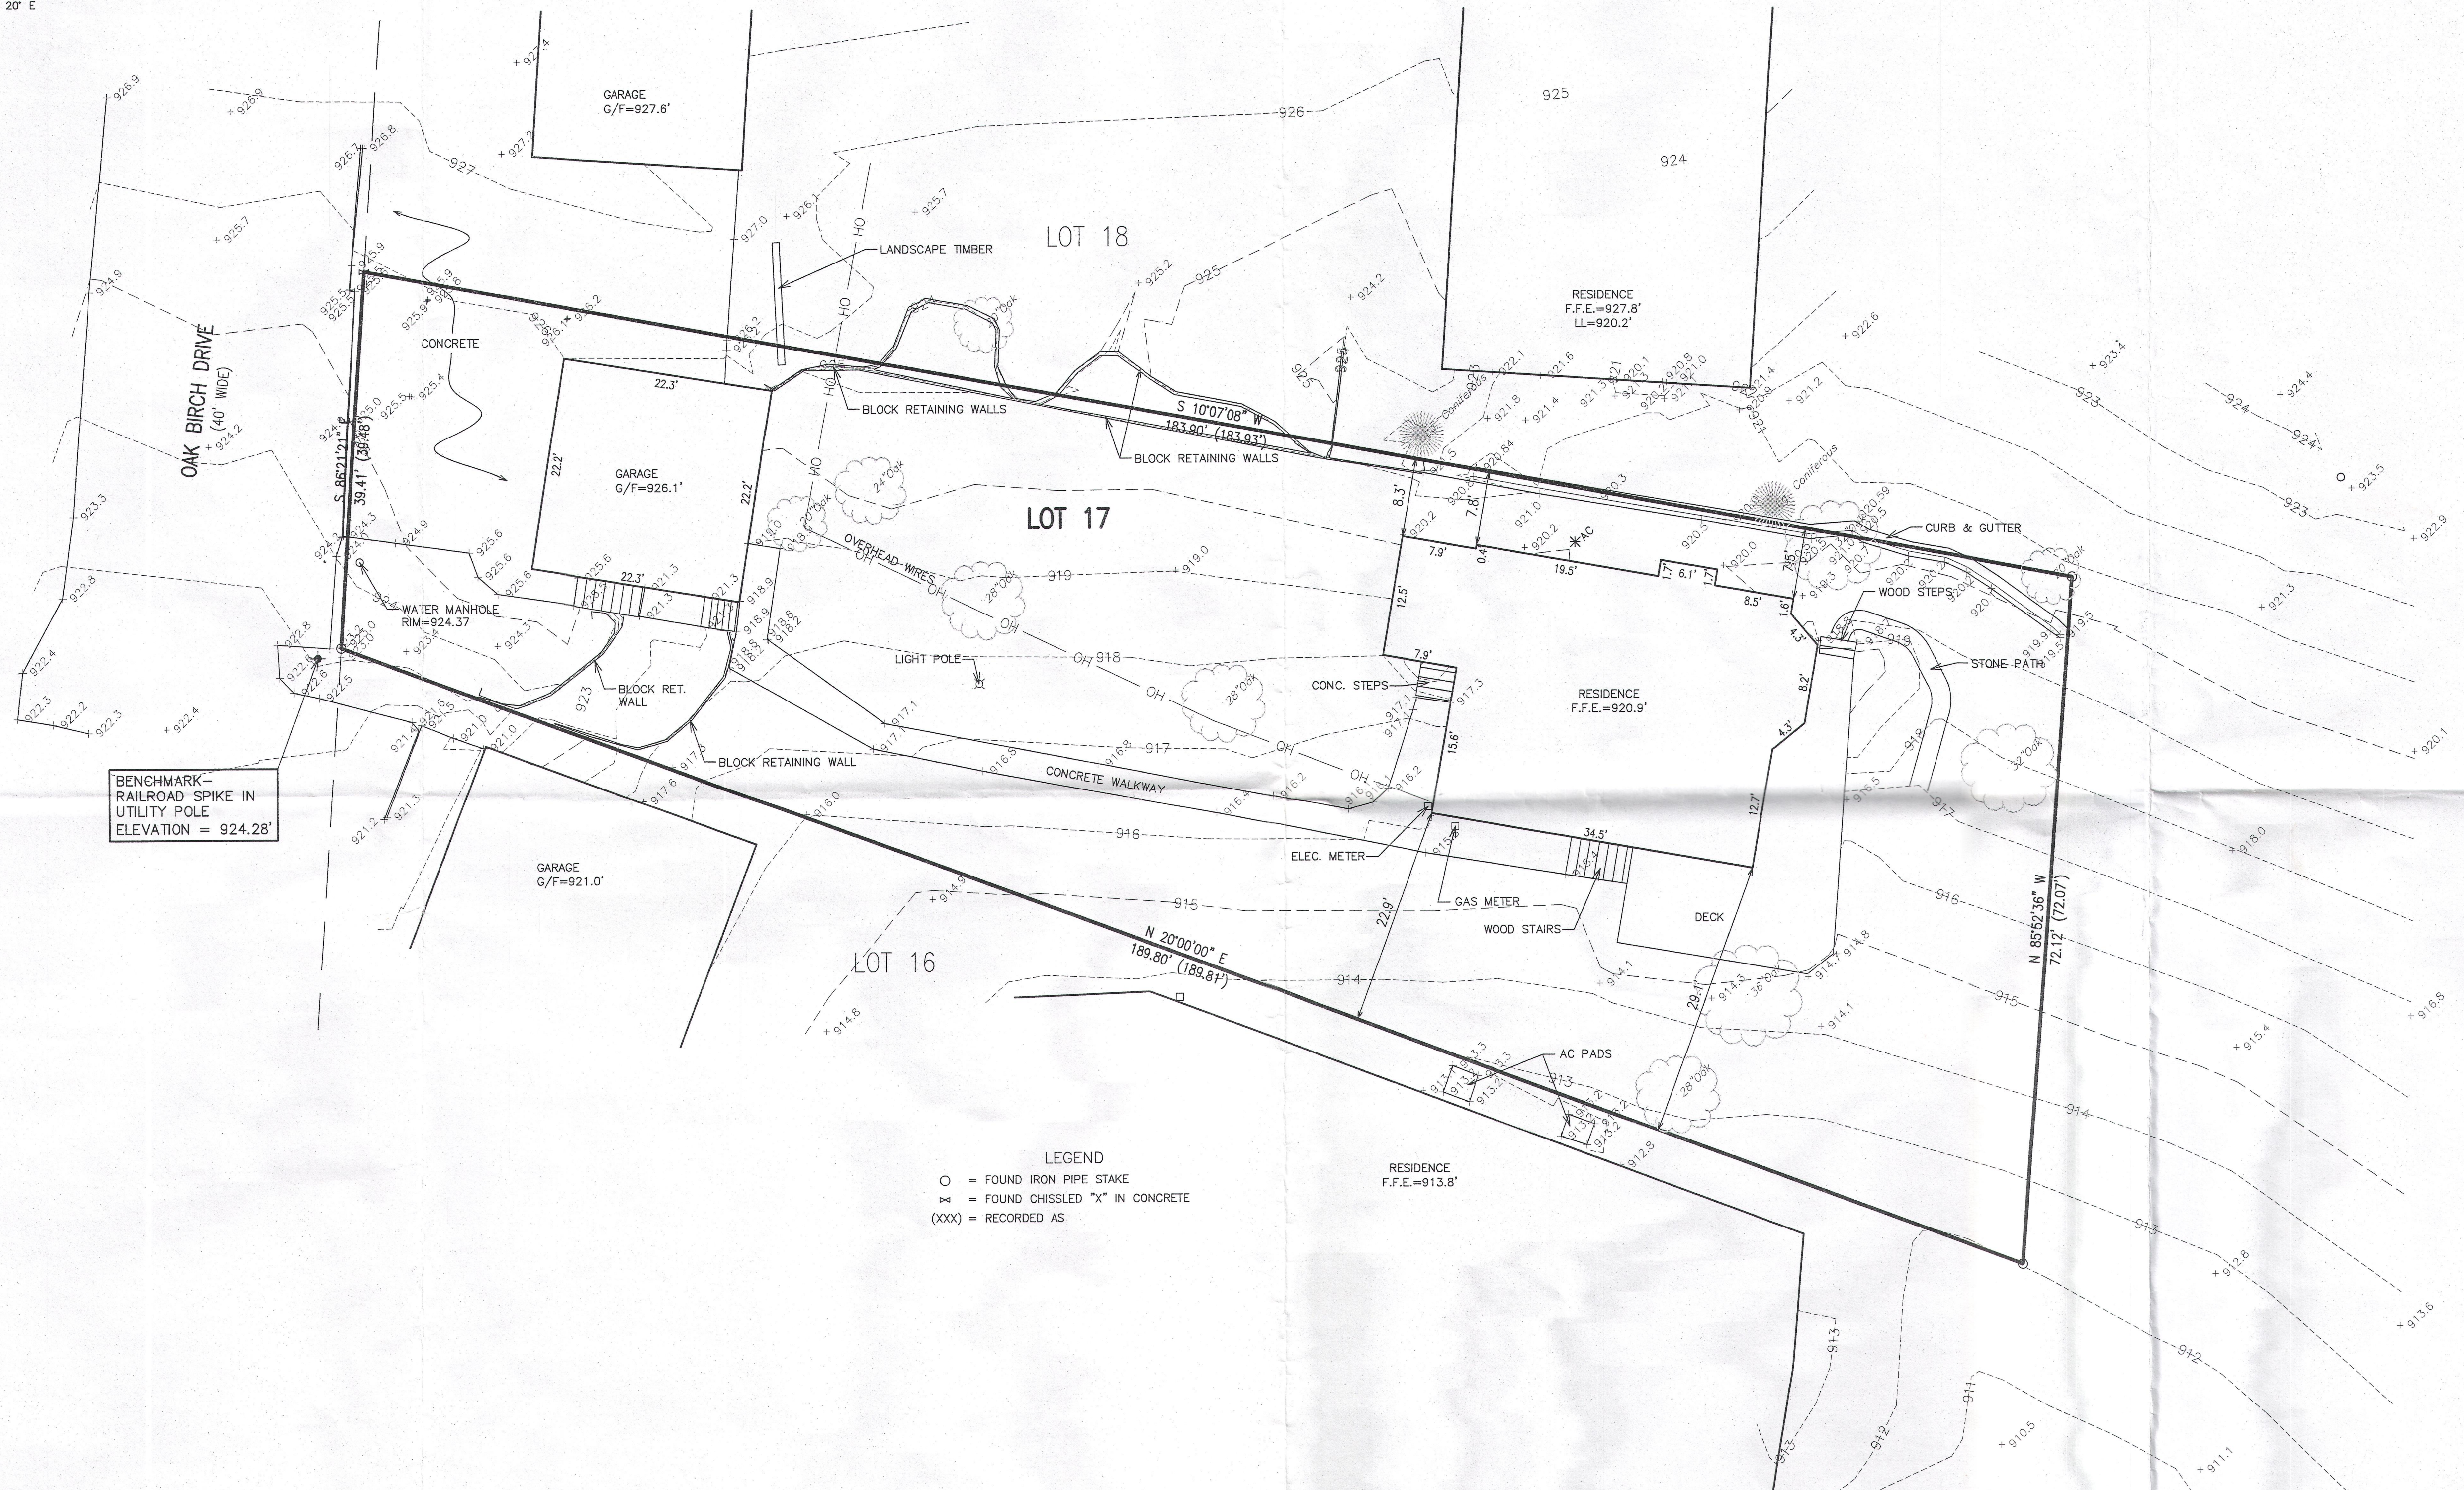


PLAT OF SURVEY TOPOGRAPHIC MAPPING


LOT 17 IN CEDAR POINT PARK, FIRST ADDITION TO THE VILLAGE OF WILLIMAS BAY
LOCATED IN SECTION 6, TOWN 1 NORTH, RANGE 17 EAST,
VILLAGE OF WILLIMAS BAY, WALWORTH COUNTY, WISCONSIN

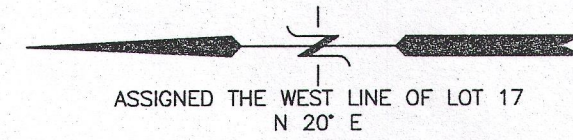

BENCHMARK -
RAILROAD SPIKE IN
UTILITY POLE
ELEVATION = 924.28'

LEGEND
○ = FOUND IRON PIPE STAKE
✕ = FOUND CHISSELED "X" IN CONCRETE
(XXX) = RECORDED AS

10 5 0 10 20 30 40
MAP SCALE IN FEET - ORIGINAL 1"=10'

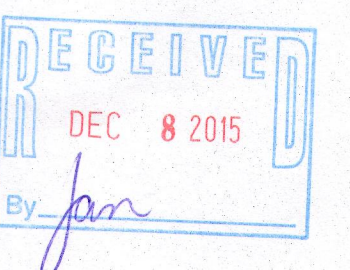

NOTE: COPIES OF THIS MAP TO WHICH THE FOLLOWING CERTIFICATE WILL APPLY SHOW
THE SURVEYOR'S ORIGINAL SEAL AND SIGNATURE IN RED INK. COPIES BY ANY OTHER
MEANS MAY HAVE ALTERATIONS WHICH DO NOT REPRESENT THE SURVEYOR'S WORK
PRODUCT.

I HEREBY CERTIFY THAT THE ABOVE DESCRIBED PROPERTY HAS BEEN SURVEYED
UNDER MY DIRECTION AND THAT THE ABOVE MAP IS A TRUE REPRESENTATION
THEREOF AND SHOWS THE SIZE AND LOCATION OF THE PROPERTY AND ITS EXTERIOR
BOUNDARIES. THIS SURVEY IS MADE FOR THE USE OF THE PRESENT OWNERS OF THE
PROPERTY, AND ALSO THOSE WHO PURCHASE, MORTGAGE, OR GUARANTEE THE TITLE
THERE TO WITHIN ONE YEAR FROM THE DATE HEREOF.

DATED: 06/30/2015

PETER S. GORDON
S-2101
ELKHORN, WI
LAND SURVEYOR

WORK ORDERED BY -
FAIRWYN
875 TOWNLINE ROAD, SUITE 103

FARRIS, HANSEN & ASSOCIATES, INC.
ENGINEERING - ARCHITECTURE - SURVEYING
7 RIDGWAY COURT P.O. BOX 437

REVISION

PROJECT 9315
DATE 06/30/2015
SHEET 1 OF 1