

Witness Corner
East-West 1/4 Line
Section 6-1-17
N. 213.104.01
E. 2.396.221.06
Elev. 878.28

Birch


Grove

Park



Plat of Survey

of
Lot 24 of Cedar Point Park 1st Addition,
a subdivision located in the Southeast 1/4 of Section 6, Town 1 North, Range
17 East, Village of Williams Bay, Walworth County, Wisconsin.

Surveyed for: **Harry & Linda Hagy**
525 Blackstone Avenue

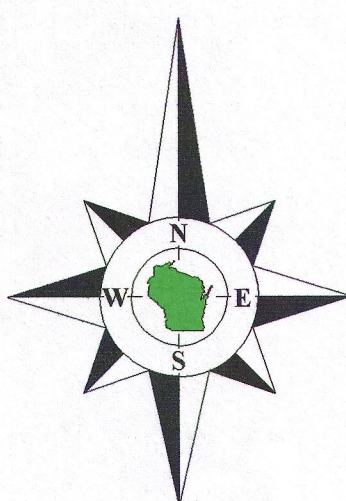

Bearings reference to the Wisconsin State
Plane Coordinate System, South Zone.

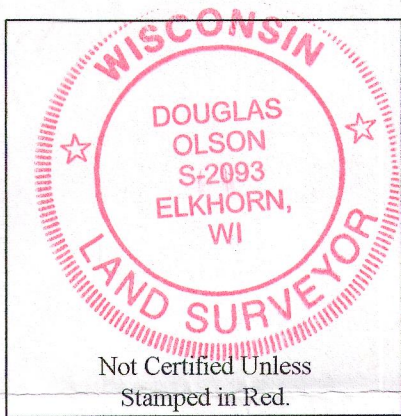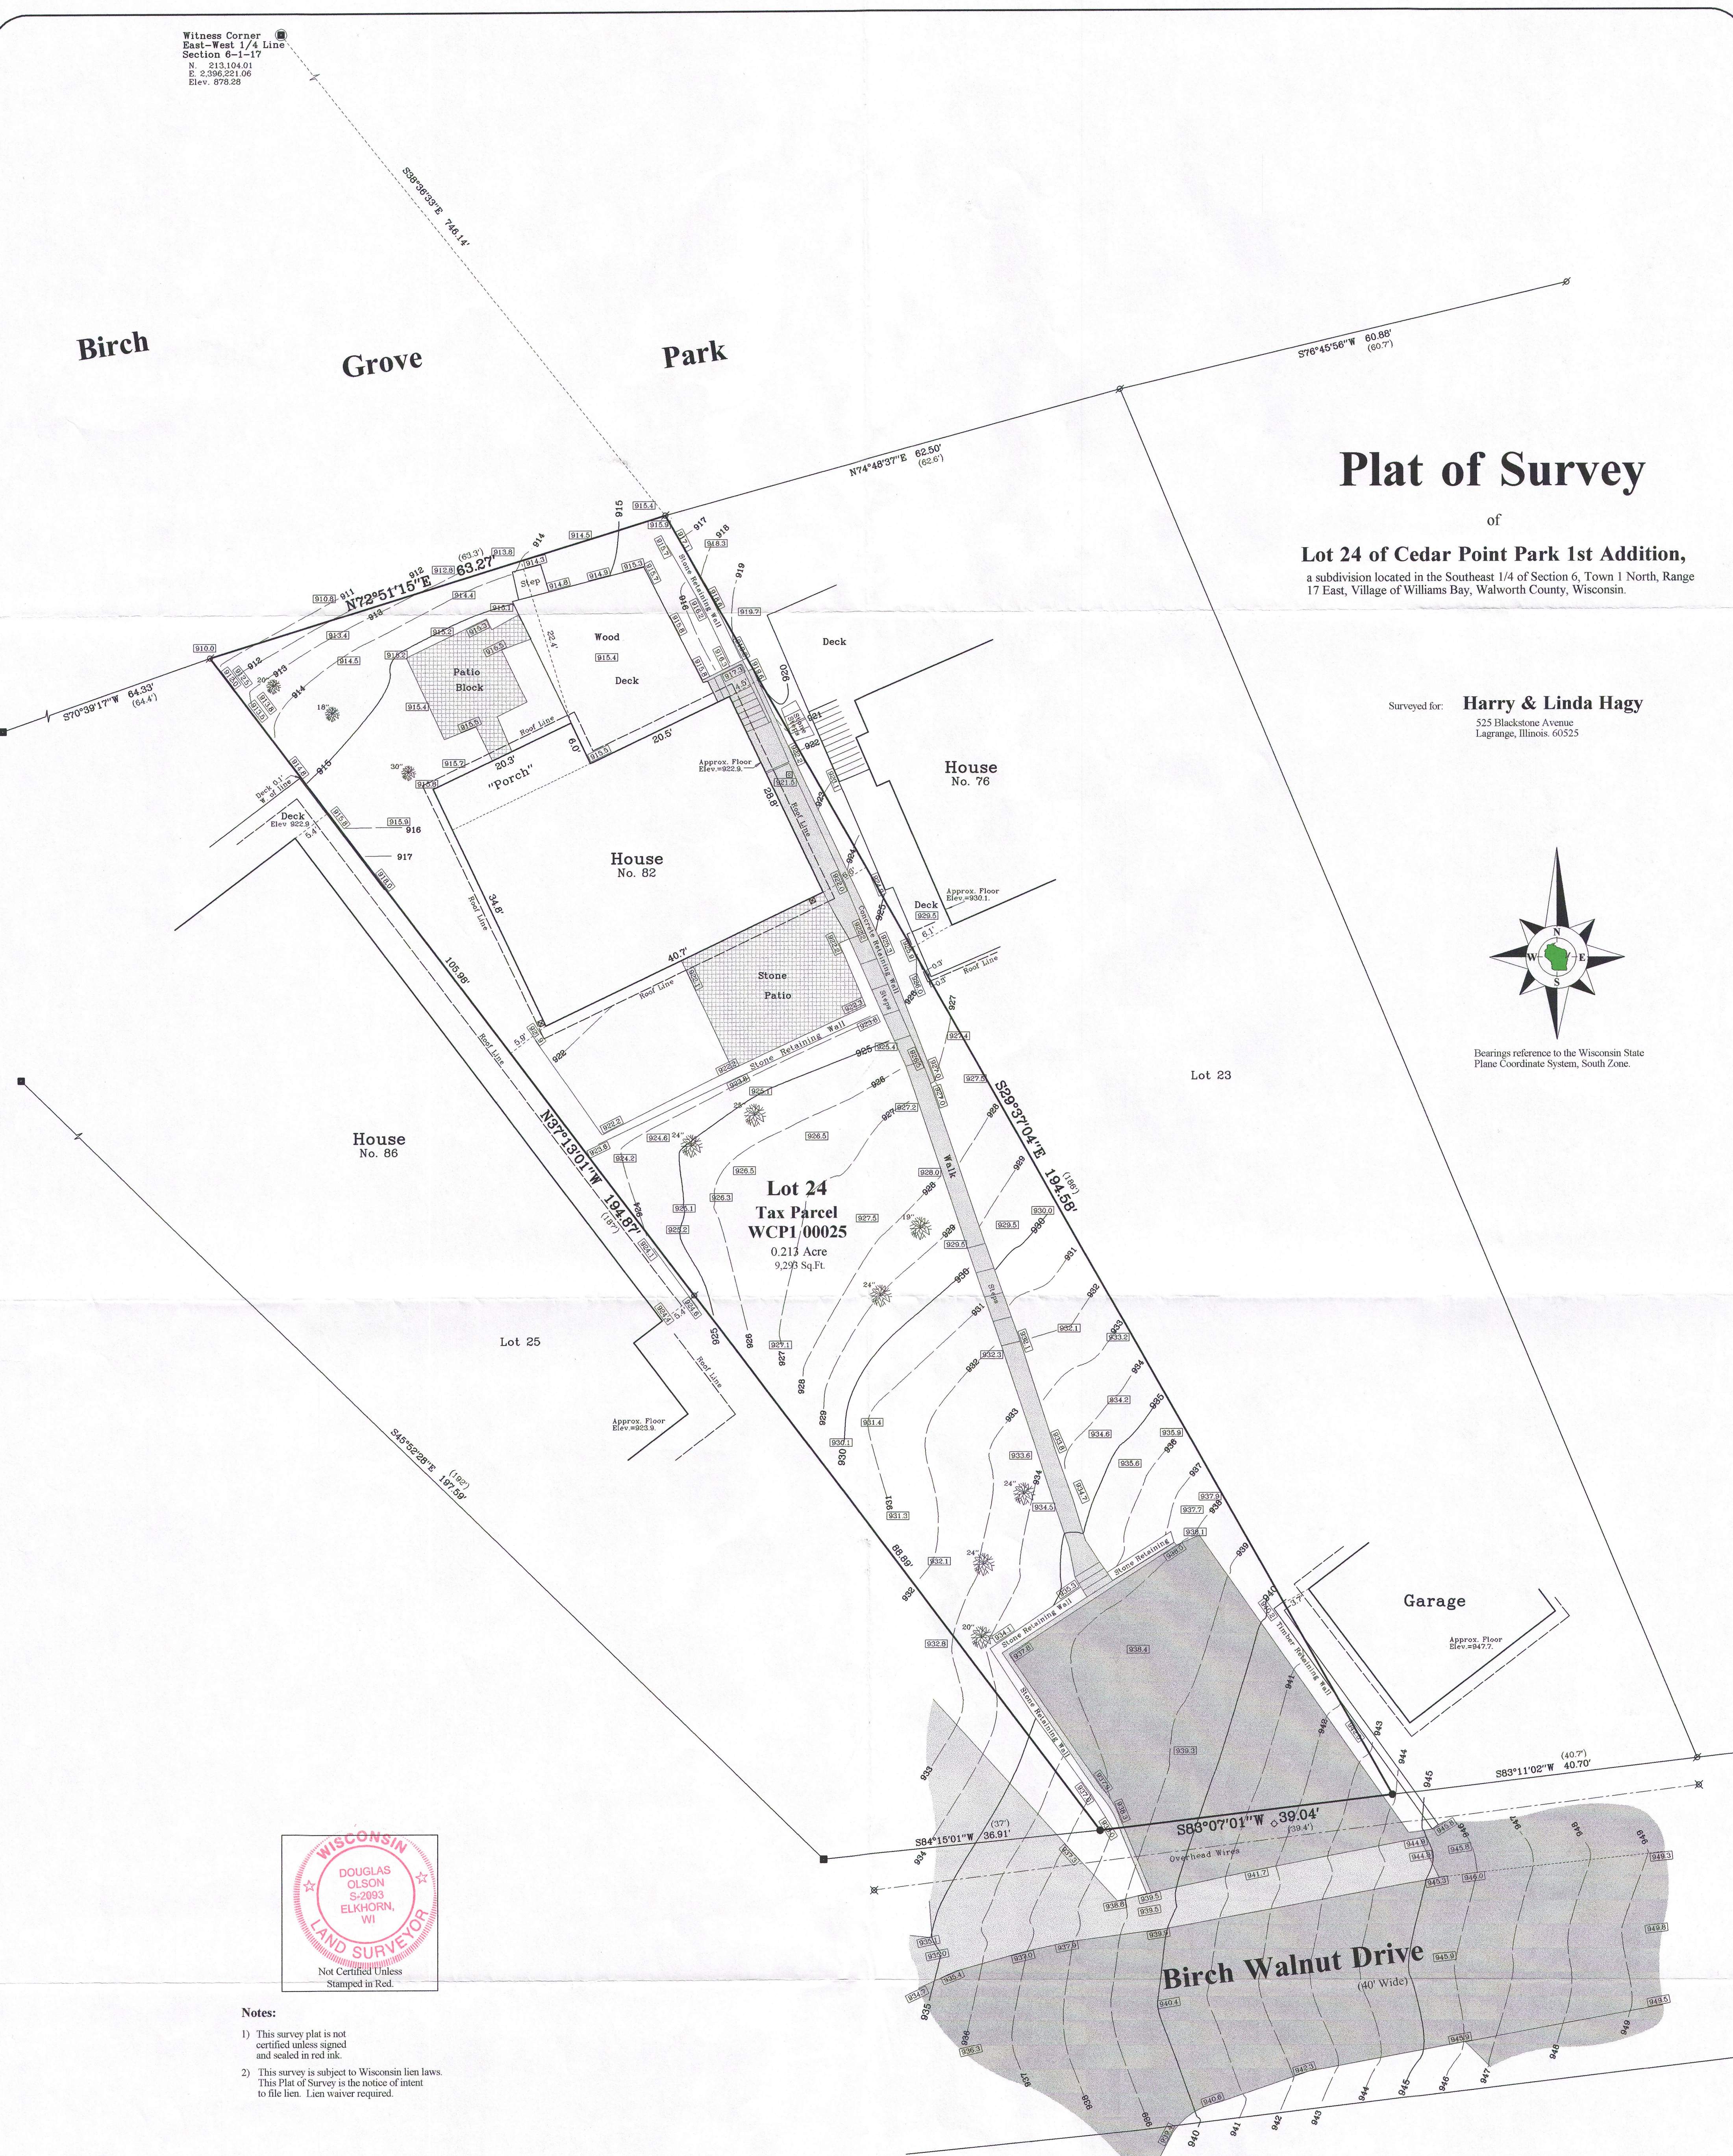

- Notes:**
- 1) This survey plat is not certified unless signed and sealed in red ink.
 - 2) This survey is subject to Wisconsin lien laws. This Plat of Survey is the notice of intent to file lien. Lien waiver required.

Copyright 2015 by Olson Land Surveying, LLC.

All rights reserved. No part of this survey plat may be reproduced or transmitted in any form by any means - graphic, electronic, or mechanical, including photocopying, tracing, or information storage and retrieval systems - without permission in writing from Douglas G. Olson, Olson Land Surveying, LLC.

I, Douglas G. Olson, Wisconsin Professional Land Surveyor, do hereby certify that this survey was performed by me, or under my direction in full compliance with the owner's/agent's instructions and Chapter A-E 7 of the Wisconsin Administrative Code "Minimum Standards for Property Surveys", and that this map is an accurate representation thereof to the best of my knowledge and belief.

Douglas G. Olson
Wisconsin Professional Land Surveyor - 2093

Legend

- Found County Section Corner
- Found Concrete Monument
- Found Iron Pipe
- Found Iron Rod
- Set Iron Pipe, 1" dia.
- Recorded Information
- Utility Pole
- Utility Pedestal
- Water Valve
- Asphalt Surface
- Concrete Surface
- Deciduous Tree
- Drain
- Brick Pavers




Olson Land Surveying, LLC

45 South Wisconsin Street * P.O. Box 322 * Elkhorn, Wisconsin. 53121
Telephone: (262) 723-3434 * Facsimile: (262) 723-8044
Email: doug@olsonsurveying.com


Scale in Feet

1" = 10'

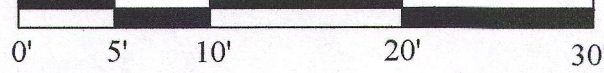

Survey date: August 3, 2015.

Revisions:

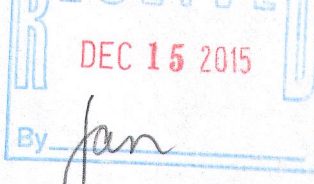

WCP1-25 011-2614