
PREPARED FOR
LINDA TONGE
KEEFE REAL ESTATE
LAKE GENEVA WI

PLAT OF SURVEY

- OF -

LOT 46, FIRST ADDITION TO CEDAR POINT PARK, ACCORDING TO THE RECORD PLAT THEREOF, SAID LAND BEING IN THE VILLAGE OF WILLIAMS BAY, COUNTY OF WALWORTH AND STATE OF WISCONSIN.

PATHFINDER SURVEYING INC.
(formerly)
J.K. SURVEYING INC.
P.O BOX 322
LAKE GENEVA, WI. 53147
WWW.PATHFINDERSURVEYING.NET
262-248-8303

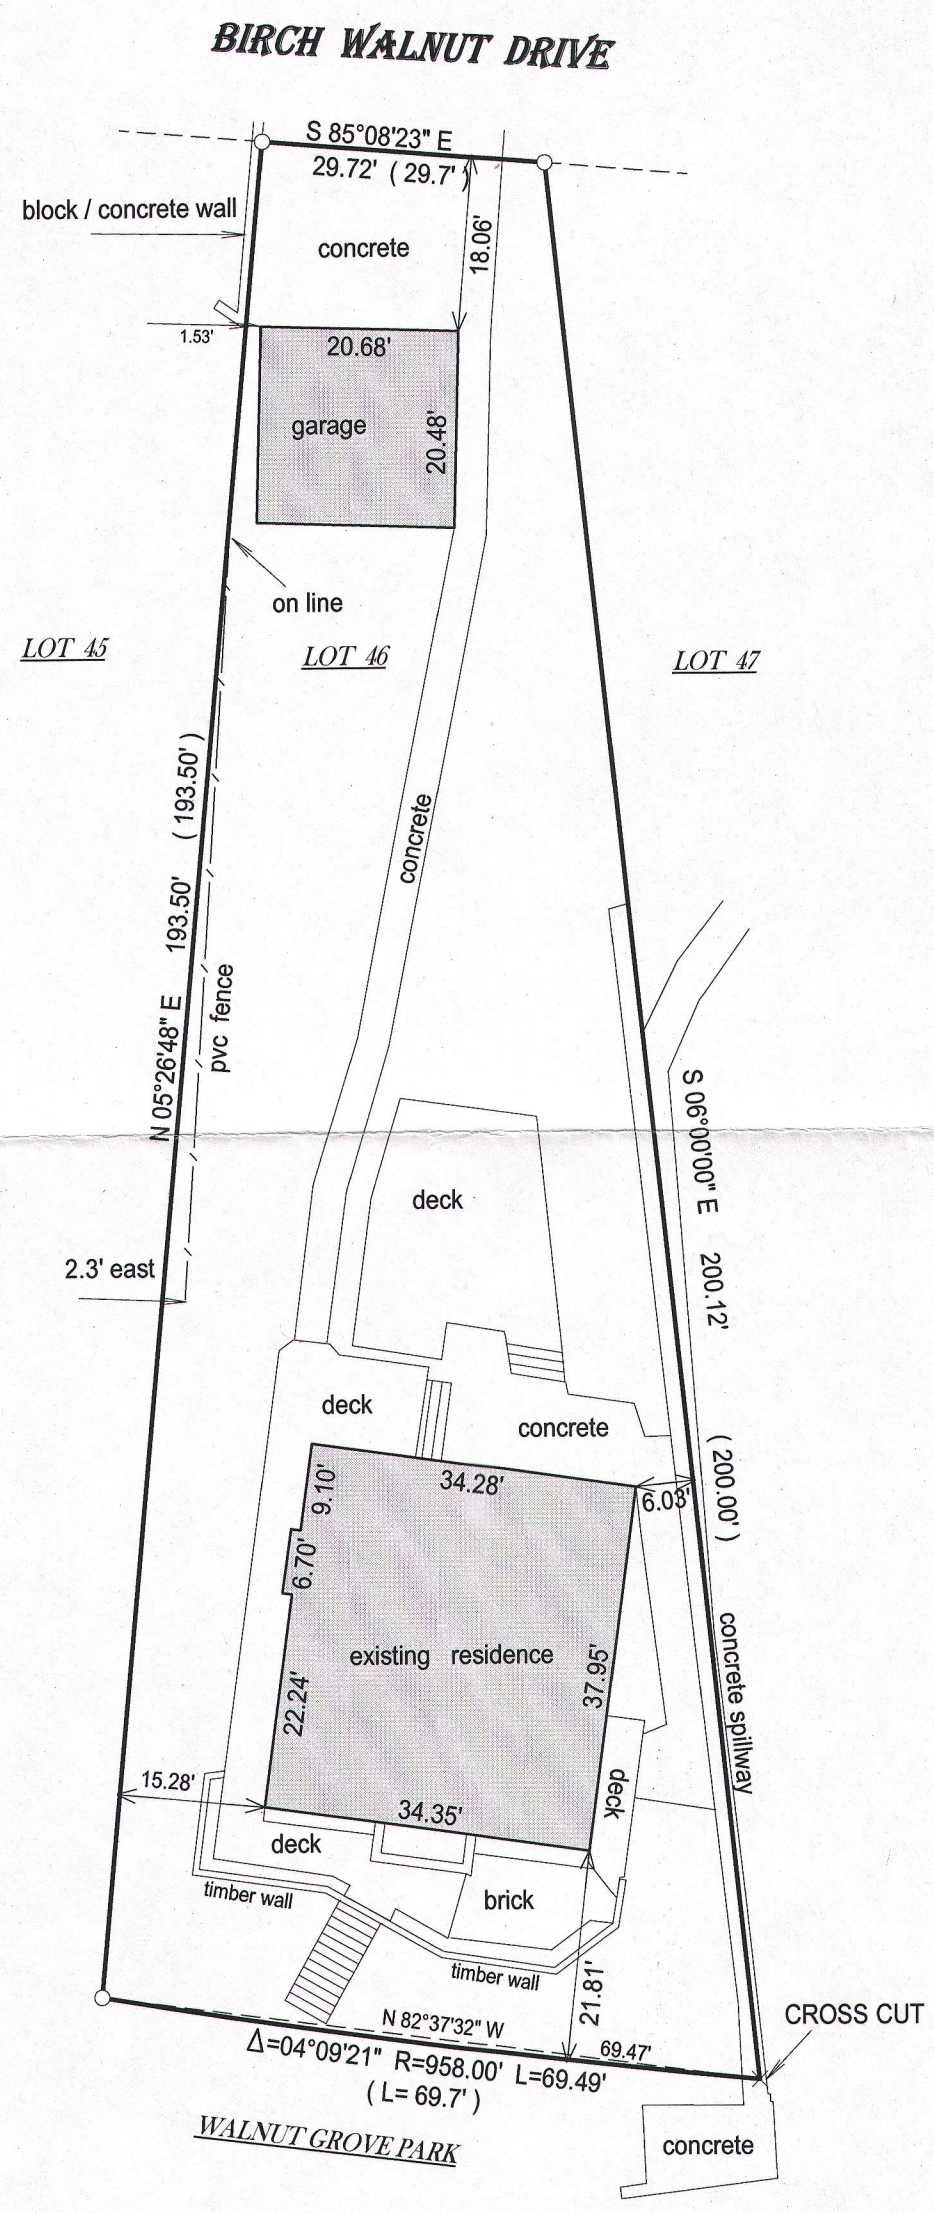

RECEIVED
DEC 30 2015
By

( )= recorded as

□ = found iron bar

○ = found iron pipe

● = set iron pipe

■ = set iron bar

SCALE 1" = 20'

JOB # 15-338

TAX ID # WCP100042

BASIS OF BEARING OF THIS PLAT: THE EAST LINE OF LOT 46 WAS ASSUMED TO BEAR S 6°00'E.

I hereby certify that I have surveyed the above- described property and the above map is a is a true representation thereof and shows the size and location of the property, its exterior boundaries, the location and dimensions of all structures thereon, fences, apparant easements and roadways and visible encroachments if any.

This survey is made for the present owners of the property, and those who purchase, mortgage, or guarantee the title thereto, within one year from the date hereof.

DATED THIS 26TH DAY OF OCTOBER, 2015.

WISCONSIN
JEFFREY L. KIMPS S-2436 LAKE GENEVA. WIS.
LAND SURVEYOR

JEFFREY L KIMPS S - 2436
Wisconsin Professional Land Surveyor
(original if signed in red)