
HAROLD H. KOLB

REGISTERED PROFESSIONAL LAND SURVEYOR
LAKE GENEVA, WISCONSIN

Part of the NE¼ of
Lot 3, Dodge [illegible] Division,
[illegible] NE¼ Sec.
[illegible] County, Wisconsin.

Note: Geneva Street has
been widened, as shown by
the [illegible] boundary of the
East 11 ft. of Lot 3.

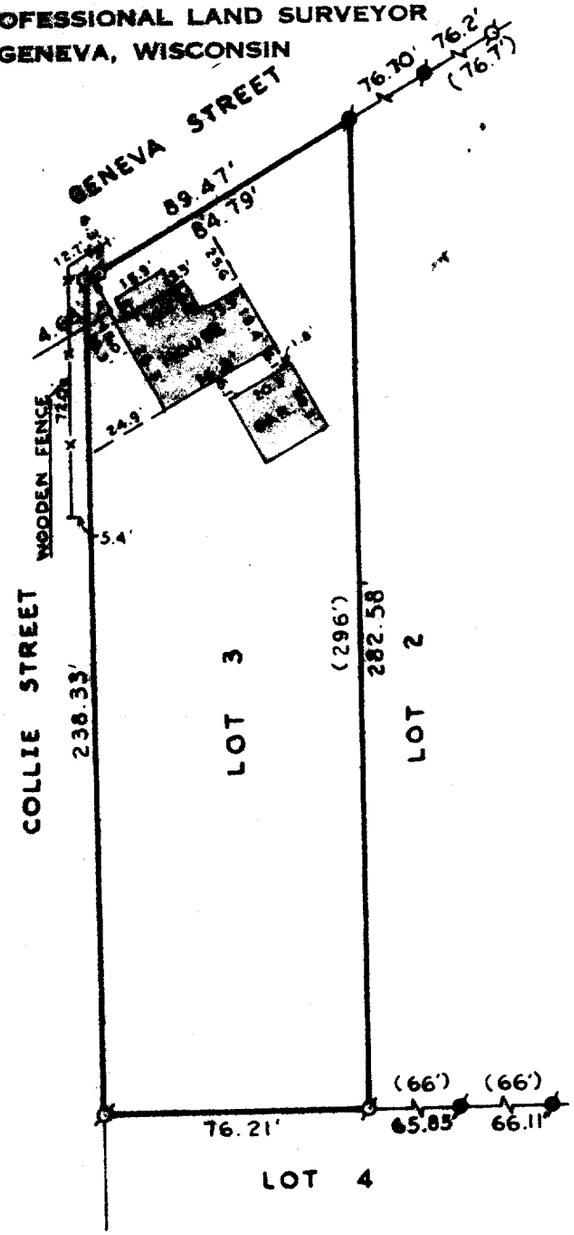

N

SCALE: 1"=50'

LEGEND

- ϕ — IRON PIPE FOUND
- O — IRON PIPE PLACED
- ⌀ — [illegible] Found
- x — SPIKE
- ( ) — [illegible] As

WISCONSIN
HAROLD H
KOLB
S-187
LAKE GENEVA
WIS.
LAND SURVEYOR

I, HAROLD H. KOLB, DO HEREBY CERTIFY THAT I HAVE SURVEYED THE PROPERTY HEREON DESCRIBED ACCORDING TO THE OFFICIAL RECORDS, AND THAT THE PLAT HEREON IS A CORRECT REPRESENTATION OF THE LOT LINES.

Harold H. Kolb

HAROLD H. KOLB
WISCONSIN REGISTERED LAND SURVEYOR, S-187

DATE [illegible]

WDO-3

11-269