
Plat of Survey

of

Lot 56 of Willabay Woods,

a subdivision located in the Northwest 1/4 of the Northeast 1/4 of Section 6, Town 1 North, Range 17 East, Village of Williams Bay, Walworth County, Wisconsin.

Surveyed for: **Leece & Phillips, S.C.**
Six West Street
Elkhorn, Wisconsin. 53121

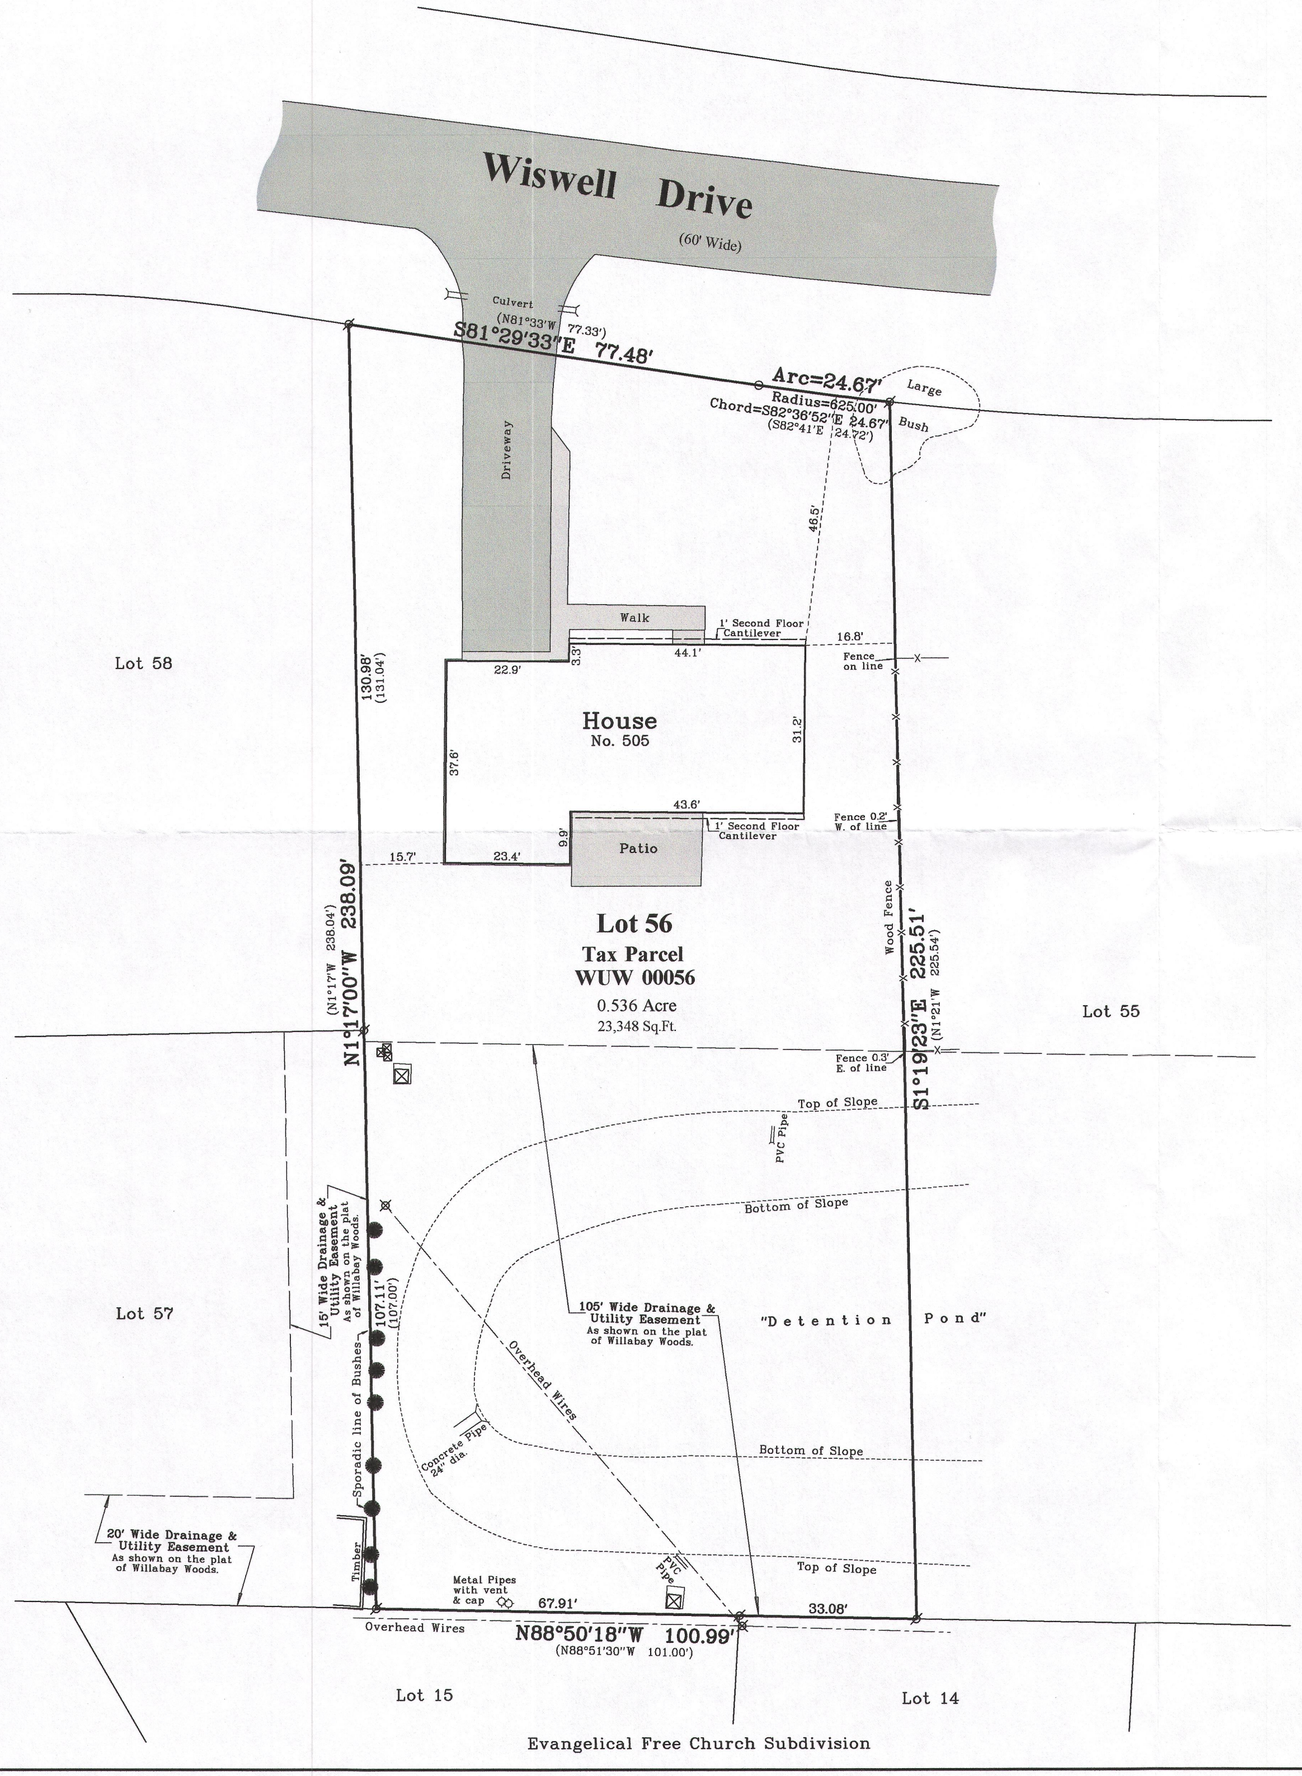

Bearings reference to the West line of Lot 56 which is recorded N1°17'00"W on the plat of Willabay Woods.

WISCONSIN
DOUGLAS OLSON S-2093 ELKHORN, WI
LAND SURVEYOR
Not Certified Unless Stamped in Red.

Notes:

1) This Plat of Survey is not certified unless signed and sealed in red ink.
2) This survey is subject to Wisconsin lien laws. This Plat of Survey is the notice of intent to file lien. Lien waiver required.
3) The Survey Date shown on this Plat of Survey is the completion date of the field work.

RECEIVED
MAR 9 2017
By: Jan

Copyright ©2017 by Olson Land Surveying, LLC.

All rights reserved. No part of this survey plat may be reproduced or transmitted in any form by any means - graphic, electronic, or mechanical, including photocopying, tracing, or information storage and retrieval systems - without permission in writing from Douglas G. Olson, Olson Land Surveying, LLC.

I hereby certify that I have surveyed the above described property in compliance with Chapter A-E 7 of the Wisconsin Administrative Code and that the map hereon is correct to the best of my professional knowledge and belief and shows the size and location of the property, its exterior boundaries, the location and dimensions of all visible structures thereon, boundary fences, apparent easements and roadways and visible encroachments, if any.

This survey is made for the exclusive use of the present owners of the property, and also those who purchase, mortgage or guarantee title thereto, within one year from the date hereof.

Douglas G. Olson
Wisconsin Professional Land Surveyor - 2093

WUW-56 011-2718

Survey Date: February 1, 2017.
Revisions:

Scale in Feet
1" = 20'
0' 10' 20' 40' 60'

45 South Wisconsin Street | P.O. Box 322
Elkhorn, Wisconsin. 53121
Telephone: (262) 723-3434
Facsimile: (262) 723-8044
Email: doug@olsonsurveying.com
Website: www.olsonsurveying.com

OLSON
LAND SURVEYING, LLC
Rural | Residential | Commercial

Legend of Symbols & Abbreviations

○	Found Iron Pipe, 2" dia.	In.	Inches
⊘	Found Iron Pipe, 1" dia.	No.	Number
( )	Recorded Information	Dia.	Diameter
⊠	Utility Pole	N	North
▨	Utility Box or Pedestal	S	South
▥	Asphalt Surface	E	East
▤	Concrete Surface	W	West
°	Degrees		
'	Minutes		
"	Seconds		
In.	Distances		
'	Feet		
"	Inches		

Sheet 1 of 1 Sheets

Drawing Name: 2017001 Leece - 2017001 Plat

Job Reference Number
2017.001

2017.001