


Plat of Survey

of


**The East 62 feet, excepting therefrom the South
1 foot of Lot 13 in Block 16 in Williams Second
Addition to the Village of Williams Bay,**

being a part of the Northeast 1/4 of Section 1, Township 1 North, Range
16 East, in the Village of Williams Bay, Walworth County, Wisconsin.

Surveyed for: **James Silverwood**
634 Highview Terrace
Lake Forest, Illinois. 60045

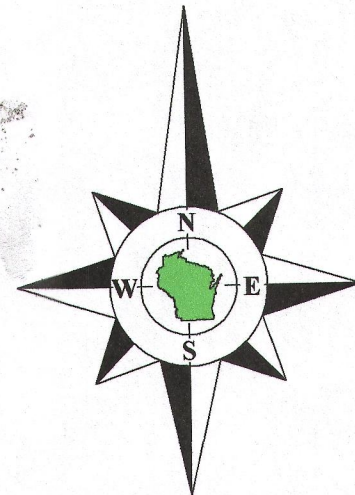

Bearings reference to the West line of
Orchard Street, assumed as North.

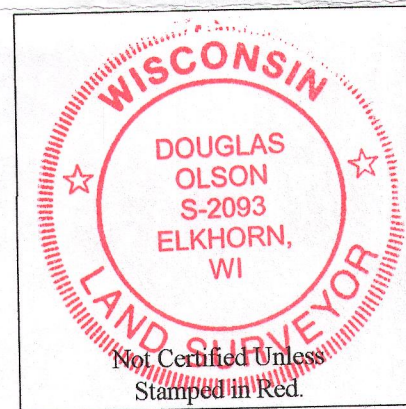

Notes:

- 1) This survey plat is not certified unless signed and sealed in red ink.
- 2) This survey is subject to Wisconsin lien laws. This Plat of Survey is the notice of intent to file lien. Lien waiver required.



Copyright 2016 by Olson Land Surveying, LLC.

All rights reserved. No part of this survey plat may be reproduced or transmitted in any form by any means - graphic, electronic, or mechanical, including photocopying, tracing, or information storage and retrieval systems - without permission in writing from Douglas G. Olson, Olson Land Surveying, LLC.


I hereby certify that I have surveyed the above described property and the map hereon is correct to the best of my professional knowledge and belief and shows the size and location of the property, its exterior boundaries, the location and dimensions of all visible structures thereon, boundary fences, apparent easements and roadways and visible encroachments, if any.

This survey is made for the exclusive use of the present owners of the property, and also those who purchase, mortgage or guarantee title thereto, within one year from the date hereof.

Douglas G. Olson
Wisconsin Professional Land Surveyor - 2093

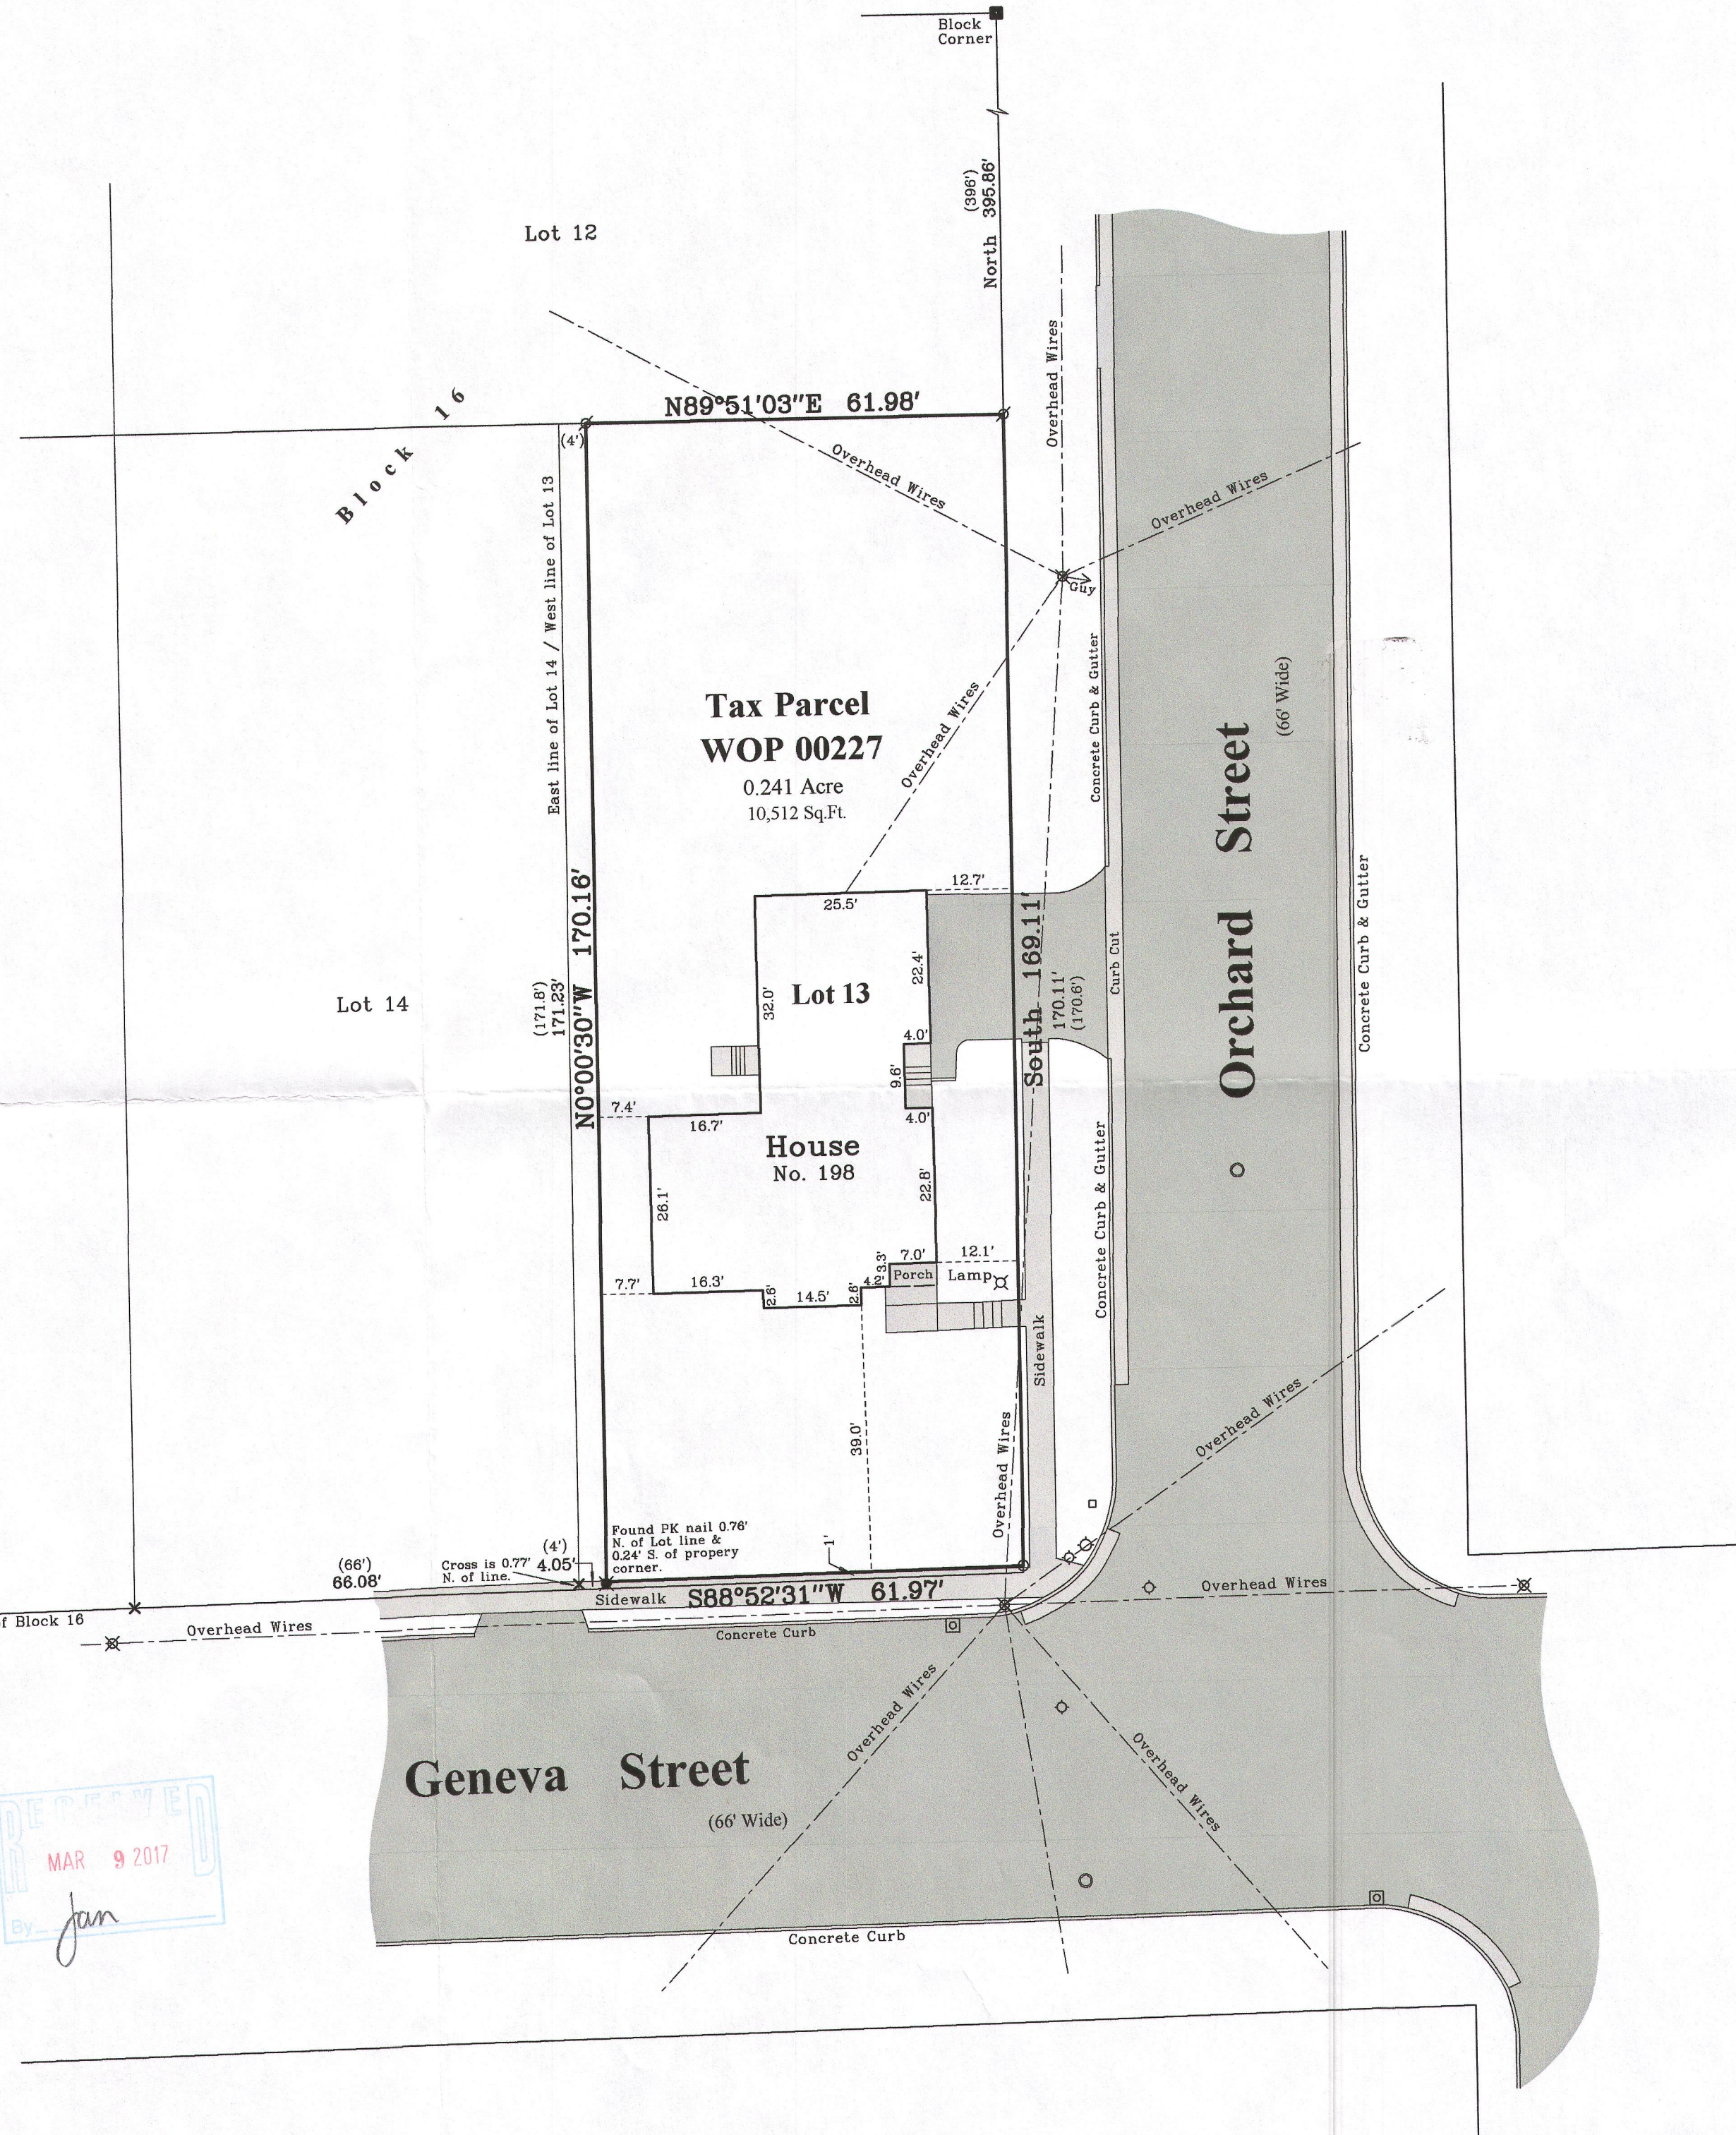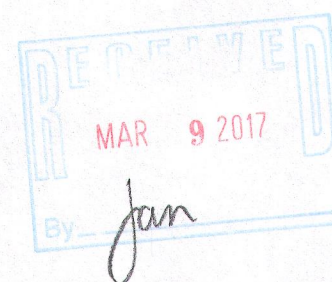

Survey Date: September 19, 2016.
Revisions:

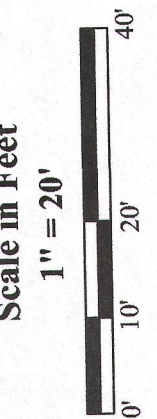

Olson Land Surveying, LLC

45 South Wisconsin Street * P.O. Box 322 * Elkhorn, Wisconsin. 53121
Telephone: (262) 723-3434 * Facsimile: (262) 723-8044
Email: doug@olsonsurveying.com



Legend
Found Concrete Monument
Found Concrete Pipe
Found P.K. Nail
Found Chiseled Crosscut
Set Iron Pipe, 1" dia.
Recorded Information
Catch Basin
Water Valve
Manhole
Hydrant
Asphalt Surface
Concrete

Sheet 1 of 1 Sheets

Job Reference Number
2016.103

2016.103

WOP-227 011-2720