PREPARED FOR:


LAKE GENEVA AREA REALTY
101 BROAD ST
LAKE GENEVA, WI.


PLAT OF SURVEY


- OF -

LOT 37 IN LOCKWOOD SUBDIVISION, LOCATED IN THE NE 1/4 OF SECTION 1, TOWN 1 NORTH, RANGE 16 EAST, VILLAGE OF WILLIAMS BAY, COUNTY OF WALWORTH AND STATE OF WISCONSIN.

PATHFINDER SURVEYING INC.
(formerly)
J.K. SURVEYING INC.
P.O BOX 322
LAKE GENEVA, WI. 53147
WWW.PATHFINDERSURVEYING.NET
262-248-8303

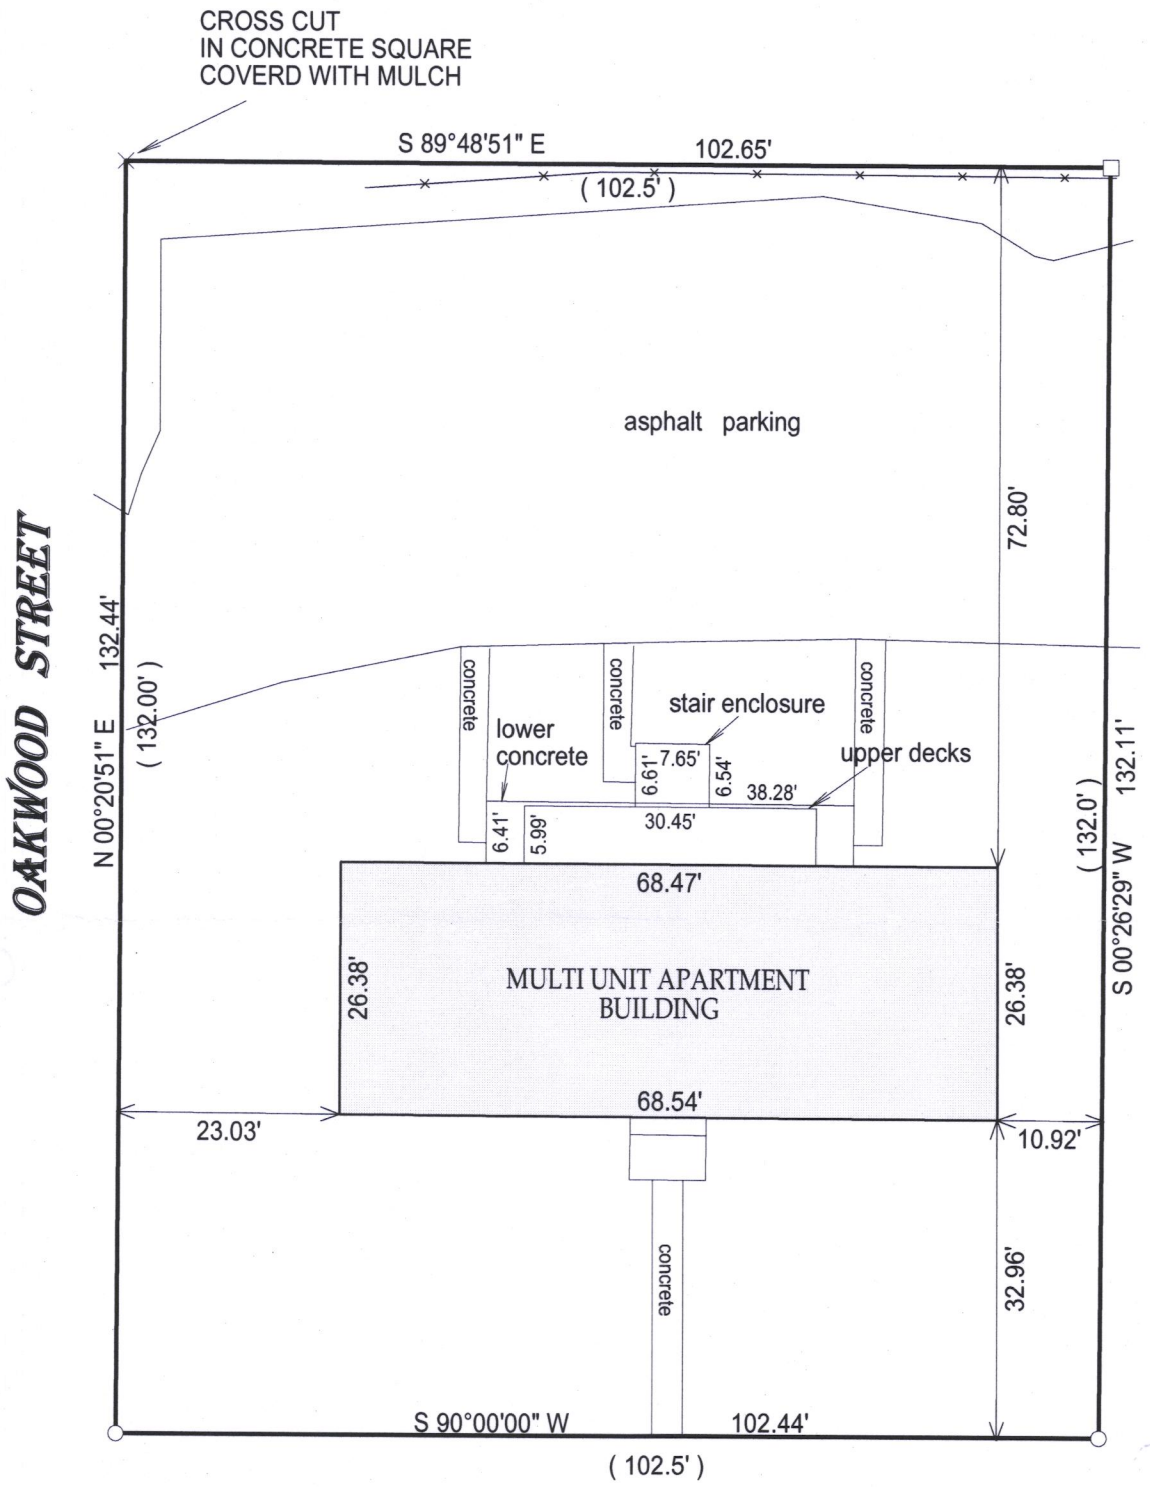

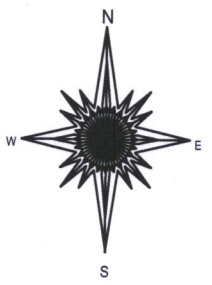

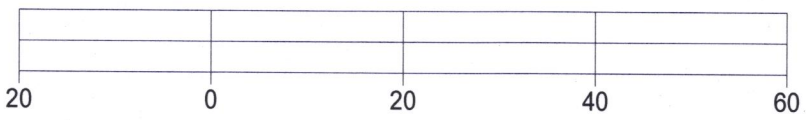

BASIS OF BEARING OF THIS PLAT: THE NORTH LINE OF CHERRY ST. WAS ASSUMED TO BEAR WEST AS MONUMENTED.

( )= recorded as

□ = found iron bar

○ = found iron pipe

● = set iron pipe

■ = set iron bar

SCALE 1" = 20'

JOB # 16-372

TAX ID # WLW300026A

I hereby certify that I have surveyed the above- described property and the above map is a is a true representation thereof and shows the size and location of the property, its exterior boundaries, the location and dimensions of all structures thereon, fences, apparant easements and roadways and visible encroachments if any.

This survey is made for the present owners of the property, and those who purchase, mortgage, or guarantee the title thereto, within one year from the date hereof.

DATED THIS 23rd day of November, 2016.

RECEIVED
JUN 21 2017
By



JEFFREY L KIMPS S - 2436
Wisconsin Professional Land Surveyor
(original if signed in red)

011-2734