



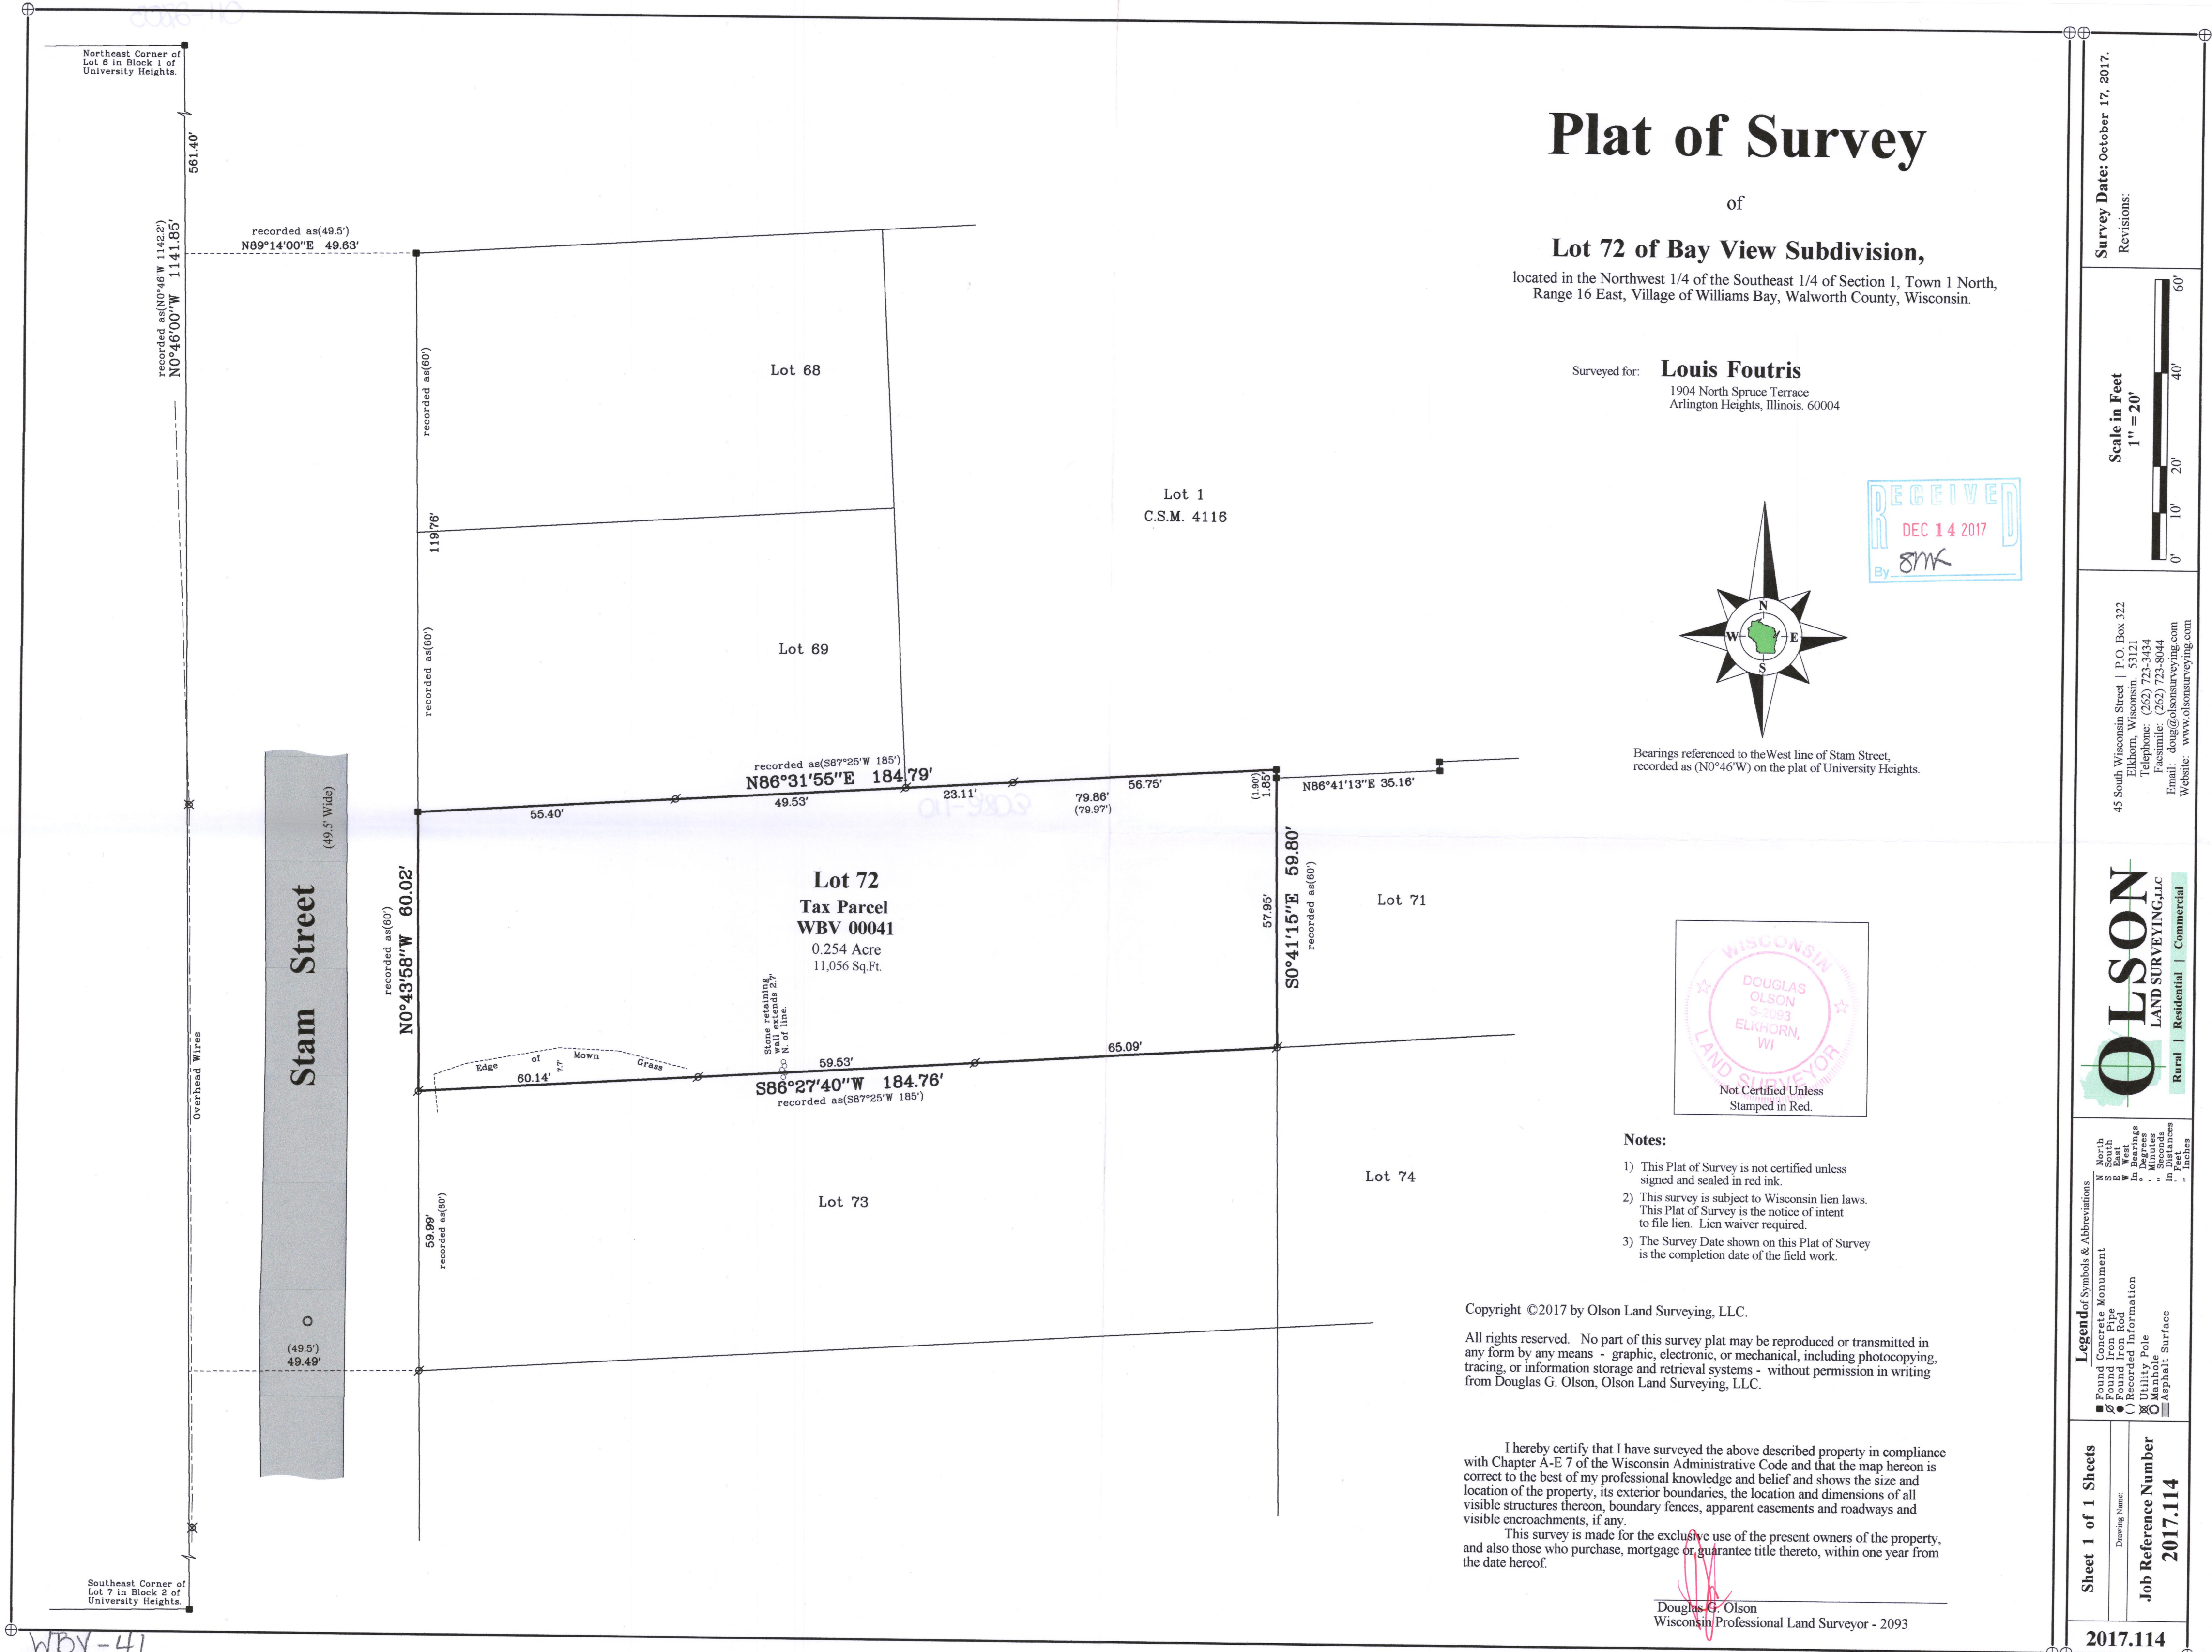



Plat of Survey

of
Lot 72 of Bay View Subdivision,
located in the Northwest 1/4 of the Southeast 1/4 of Section 1, Town 1 North,
Range 16 East, Village of Williams Bay, Walworth County, Wisconsin.

Surveyed for: **Louis Foutris**
1904 North Spruce Terrace
Arlington Heights, Illinois. 60004

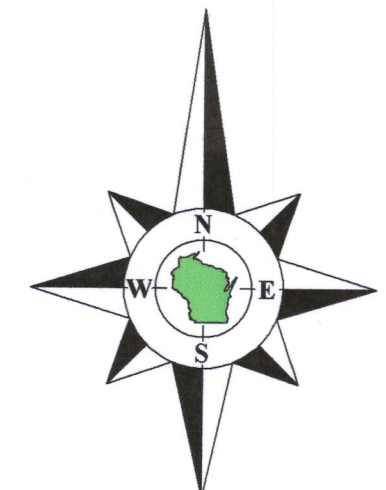

Bearings referenced to the West line of Stam Street,
recorded as (N0°46'W) on the plat of University Heights.

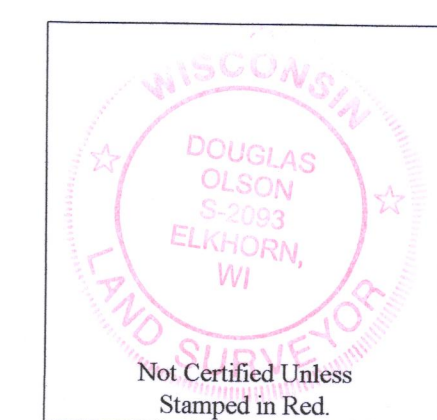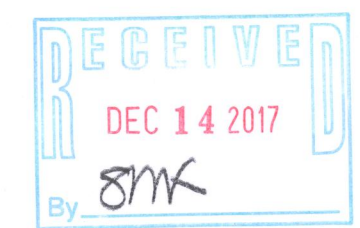

- Notes:**
- 1) This Plat of Survey is not certified unless signed and sealed in red ink.
 - 2) This survey is subject to Wisconsin lien laws. This Plat of Survey is the notice of intent to file lien. Lien waiver required.
 - 3) The Survey Date shown on this Plat of Survey is the completion date of the field work.

Copyright ©2017 by Olson Land Surveying, LLC.

All rights reserved. No part of this survey plat may be reproduced or transmitted in any form by any means - graphic, electronic, or mechanical, including photocopying, tracing, or information storage and retrieval systems - without permission in writing from Douglas G. Olson, Olson Land Surveying, LLC.

I hereby certify that I have surveyed the above described property in compliance with Chapter A-E 7 of the Wisconsin Administrative Code and that the map hereon is correct to the best of my professional knowledge and belief and shows the size and location of the property, its exterior boundaries, the location and dimensions of all visible structures thereon, boundary fences, apparent easements and roadways and visible encroachments, if any.

This survey is made for the exclusive use of the present owners of the property, and also those who purchase, mortgage or guarantee title thereto, within one year from the date hereof.

Douglas G. Olson
Wisconsin Professional Land Surveyor - 2093

Survey Date: October 17, 2017. Revisions:	
Scale in Feet 1" = 20' 0' 10' 20' 40' 60'	
45 South Wisconsin Street P.O. Box 322 Elkhorn, Wisconsin. 53121 Telephone: (262) 723-3434 Facsimile: (262) 723-8044 Email: doug@olsonsurveying.com Website: www.olsonsurveying.com	
OLSON LAND SURVEYING, LLC Rural Residential Commercial	
Legend of Symbols & Abbreviations	North South East West Bearing Distance Minutes Seconds Inches
Sheet 1 of 1 Sheets	Job Reference Number 2017.114
2017.114	