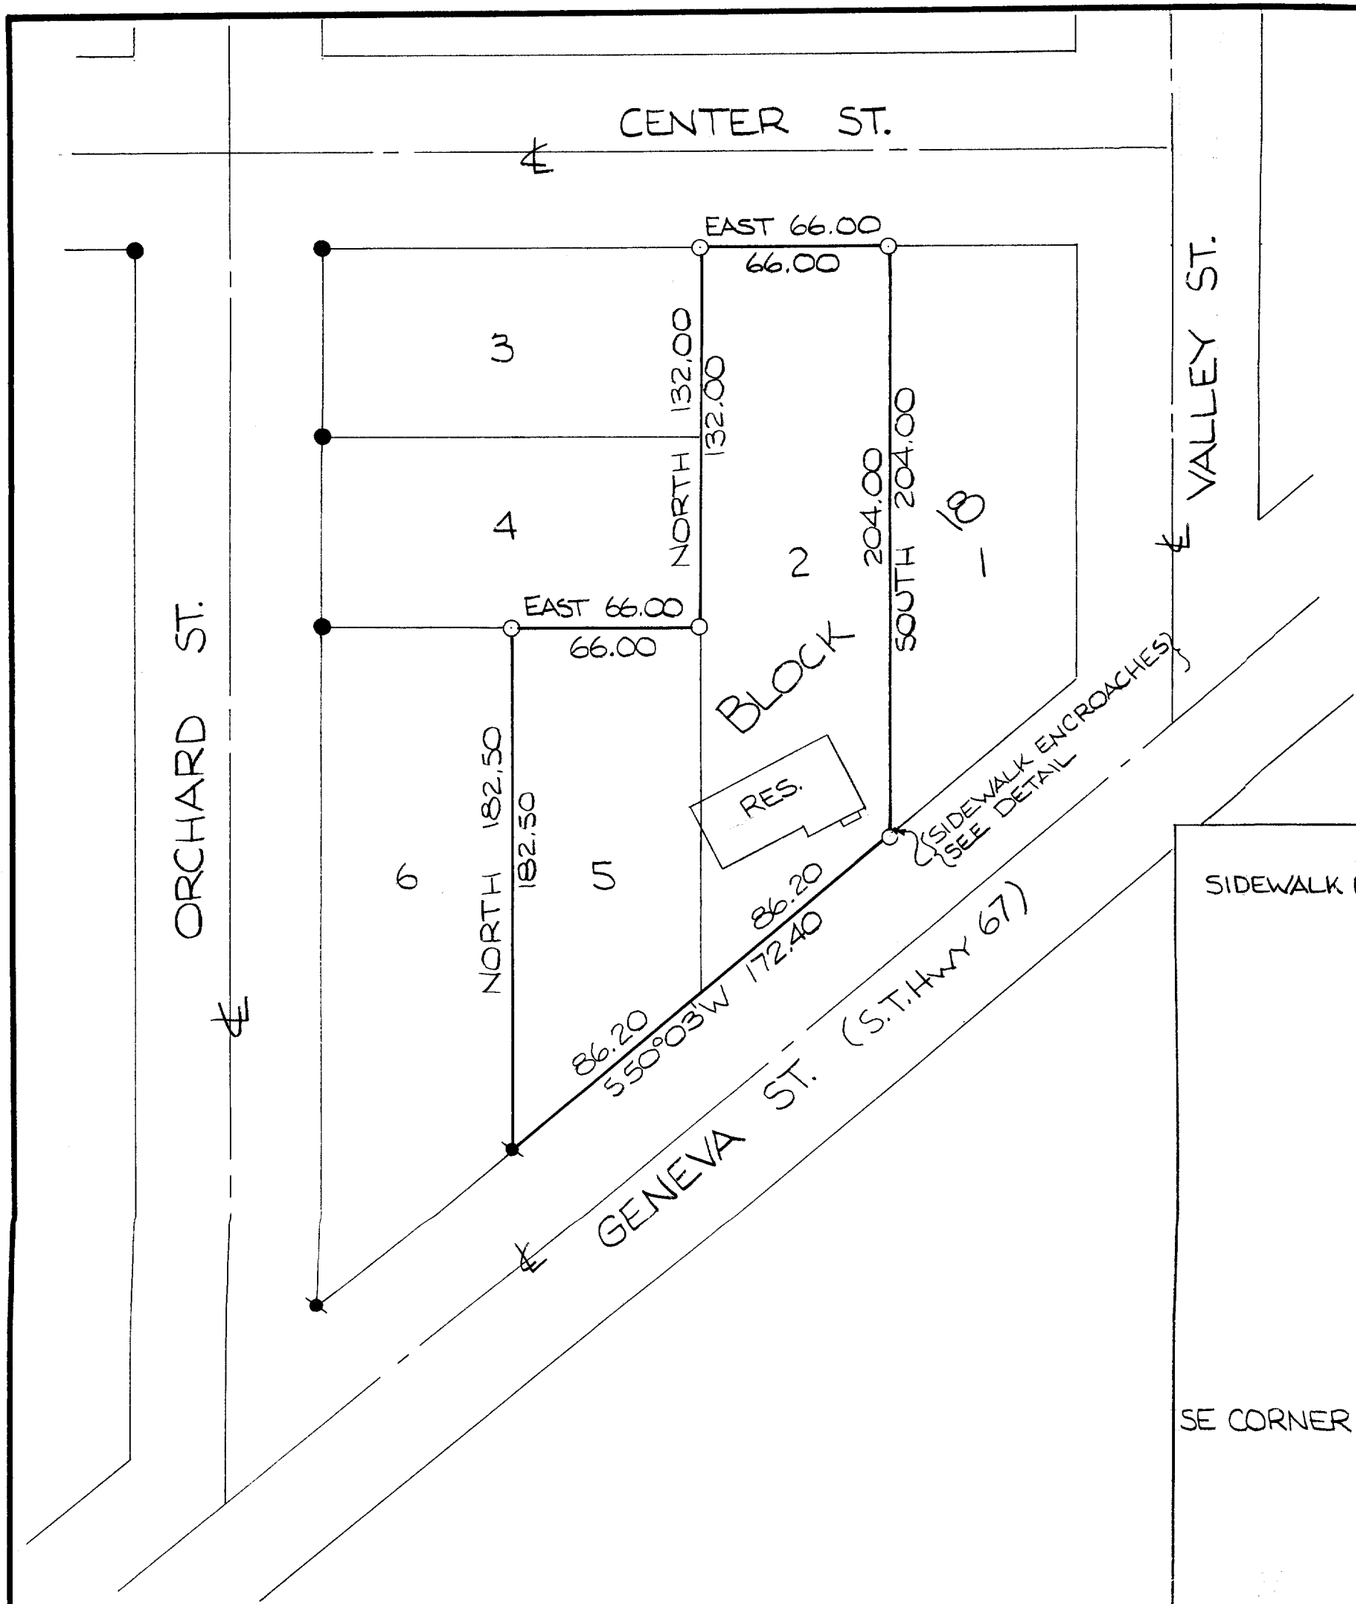


LEGEND
- ● IRON PIPE FOUND
- ◔ IRON ROD FOUND
- O IRON PIPE SET 1¼" ø x 24"

SCALE: 1"=50' MAXIMUM POSITIONAL TOLERANCE = 0.04'


DESCRIPTION:
LOTS 2 & 5 OF BLOCK 18 OF WILLIAMS 2nd ADDITION TO THE VILLAGE OF WILLIAMS BAY, WALWORTH COUNTY, WISCONSIN.

CERTIFICATE:
I, JOSEPH M. BIAGI, SURVEYOR, DO HEREBY CERTIFY THAT I HAVE SURVEYED THE LANDS HEREON DESCRIBED.

DATE:
APRIL 15, 1975

JOSEPH M. BIAGI RLS 12

WISCONSIN JOSEPH M. BIAGI S-12 ELKHORN WIS. LAND SURVEYOR

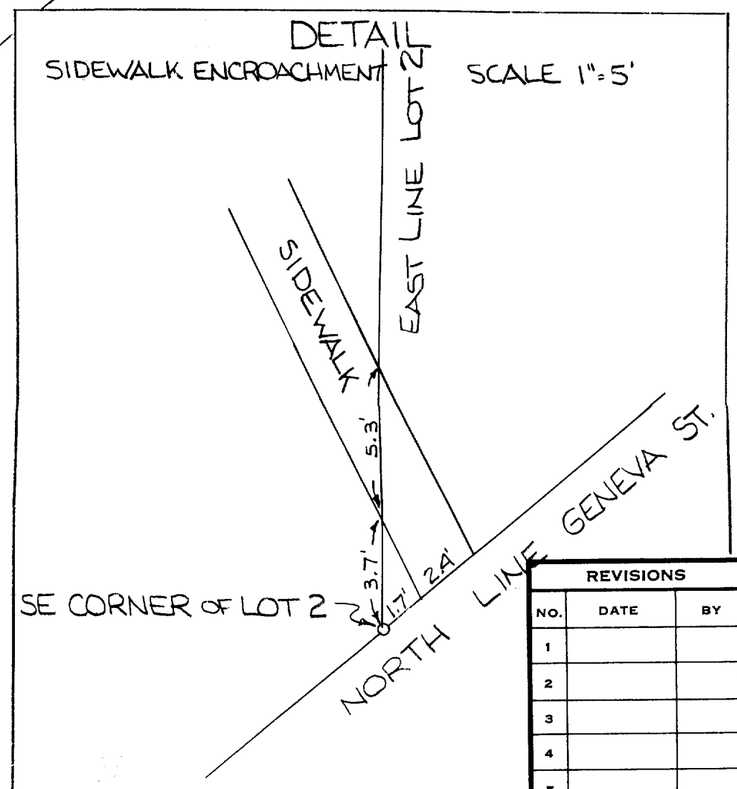

REVISIONS		
NO.	DATE	BY
1		
2		
3		
4		
5		

T. ROBT. HORVATH (TRUSTEE)

LOTS 2 & 5 BLK 18 WMS 2nd ADD.

DRAWN BY GW	SCALE 1" = 50'	MATERIAL
CHK'D HG	DATE 4-15-75	DRAWING NO. 42-75
TRACED	APP'D	

TELEDYNE POST 18AE-10E—12X18 OP-245 & OP-247 New Sized

11-28