

Batterman
engineers surveyors planners
2857 Bartells Drive
Beloit, Wisconsin 53511
608.365.4164
www.rlbatterman.com


PLAT OF SURVEY

FOR THE EXCLUSIVE USE OF:
Dave Chroust as personal representative
of the Richard J. Chroust Estate
804 Skyline Dr.
Batavia, IL 60510

ORDER NO: 33496

FIELD CREW: DJE
DRAWN BY: DJE
DATE: December 27, 2019

File Name: 1633400_33499633496 - Down Chorus5 SURVEY.PDF ID: DRAWING FILES

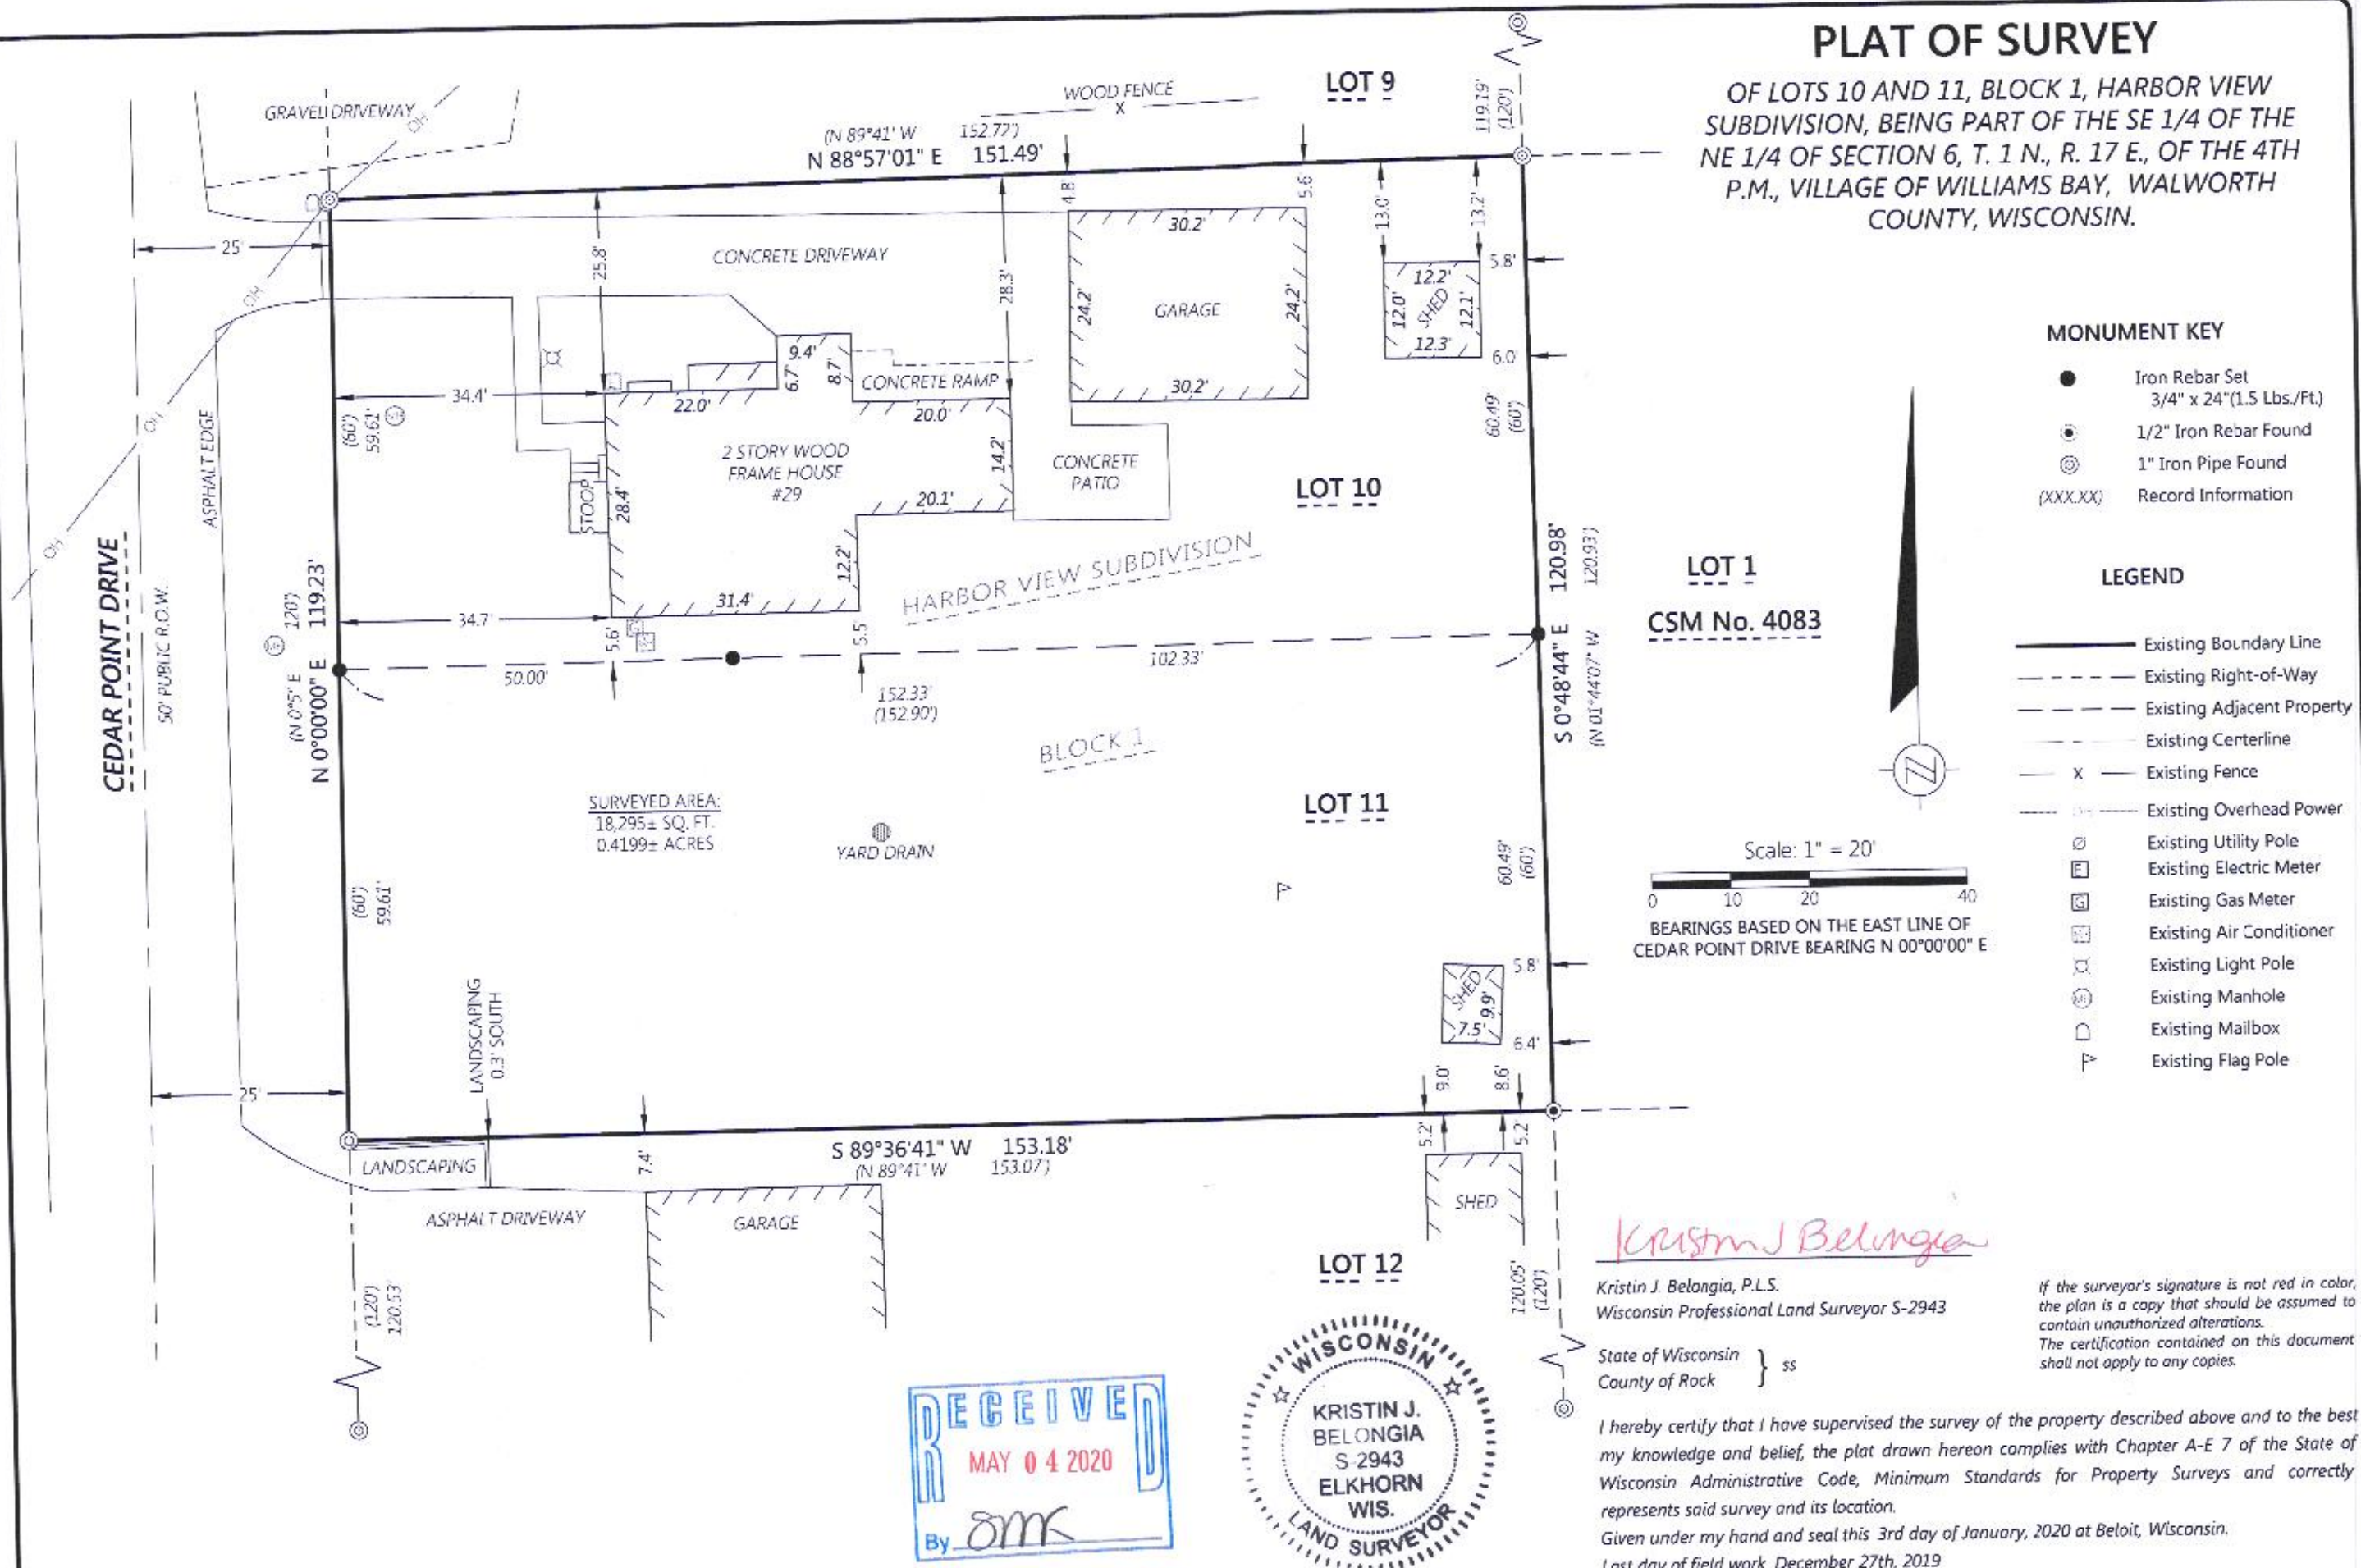

WHV-7

011-2953