


X:\PROJECTS\3836\BLOCK_01\LOT_01_15\ACAD\3836-01-01-15.DWG

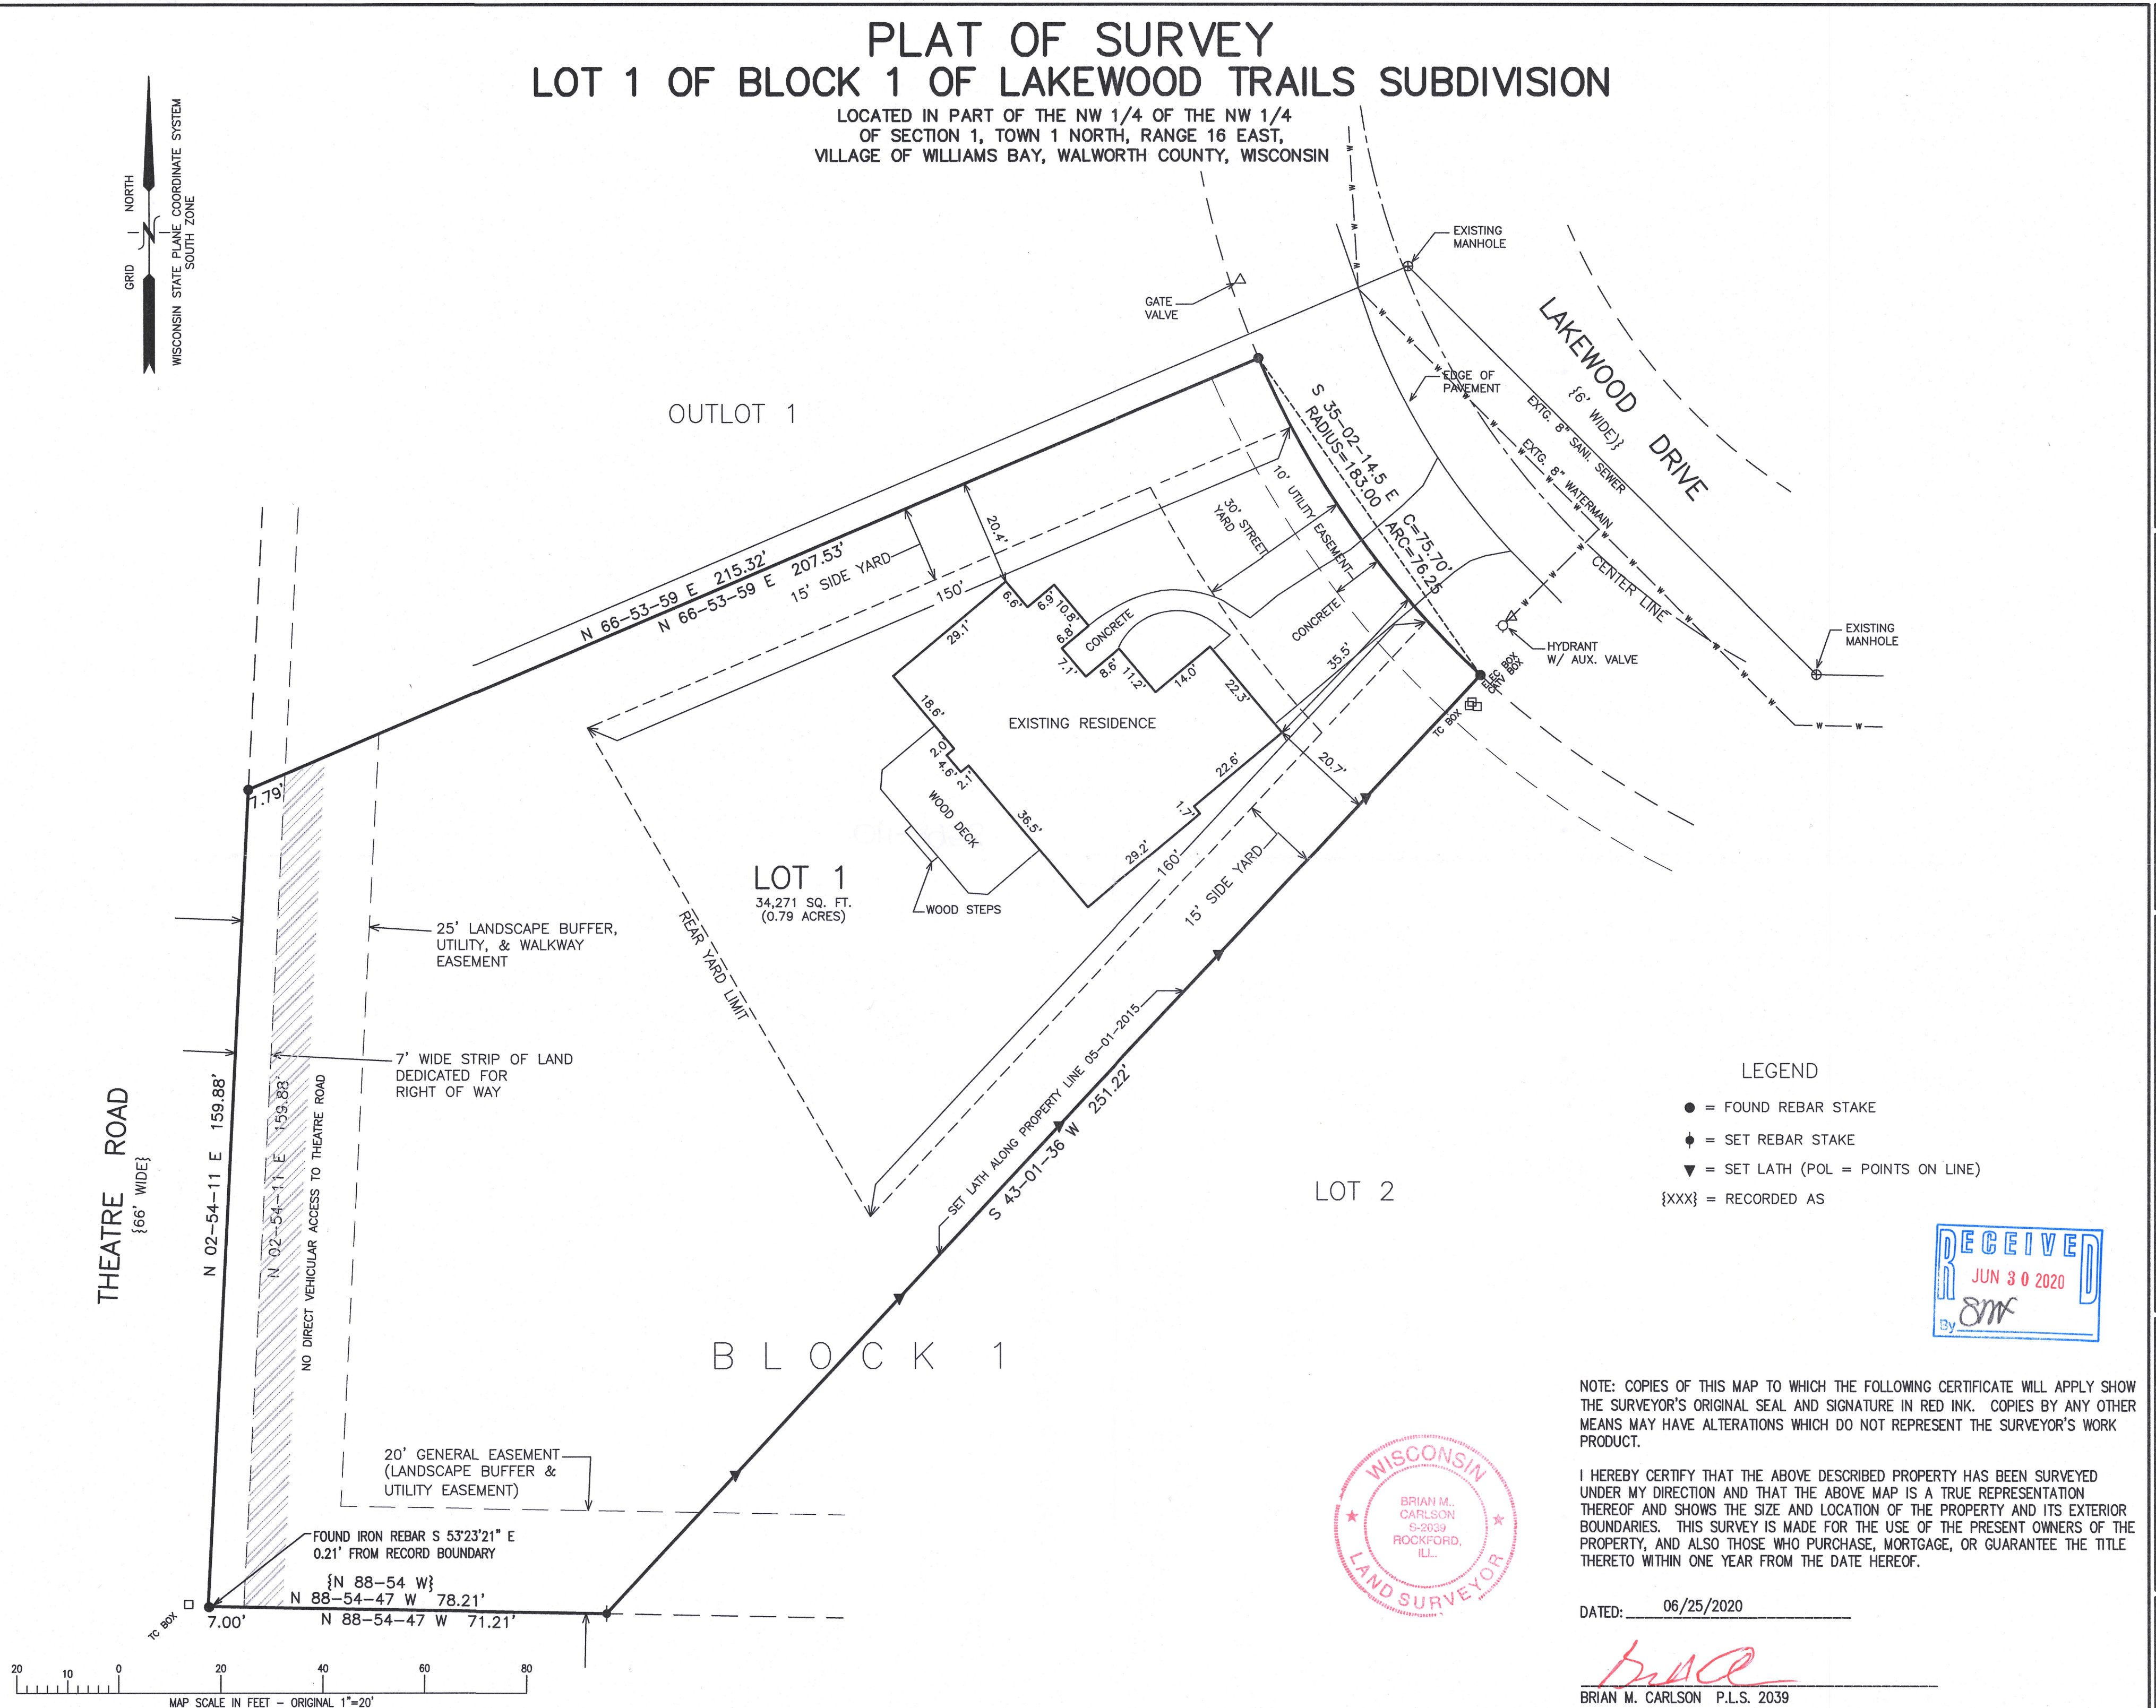

PLAT OF SURVEY
429 LAKEWOOD DRIVE
WILLIAMS BAY, WI 53191

WORK ORDERED BY -
MAUREEN WEBER
429 LAKEWOOD DRIVE
WILLIAMS BAY, WI 53191

FARRIS, HANSEN & ASSOCIATES, INC.
ENGINEERING - ARCHITECTURE - SURVEYING
7 RIDGWAY COURT P.O. BOX 437
ELKHORN, WISCONSIN 53121
OFFICE: (262) 723-2098 FAX: (262) 723-5886

REVISIONS

DATE	DESCRIPTION
06/19/1998	RESURVEYED
08/31/2006	RESURVEYED
05/25/2010	RESURVEYED
05/04/2015	RESURVEYED & POL
06/25/2020	- LB RESURVEYED & POL

PROJECT NO.
3836.01.01.15

DATE:
08/19/1996

SHEET NO.
1 OF 1