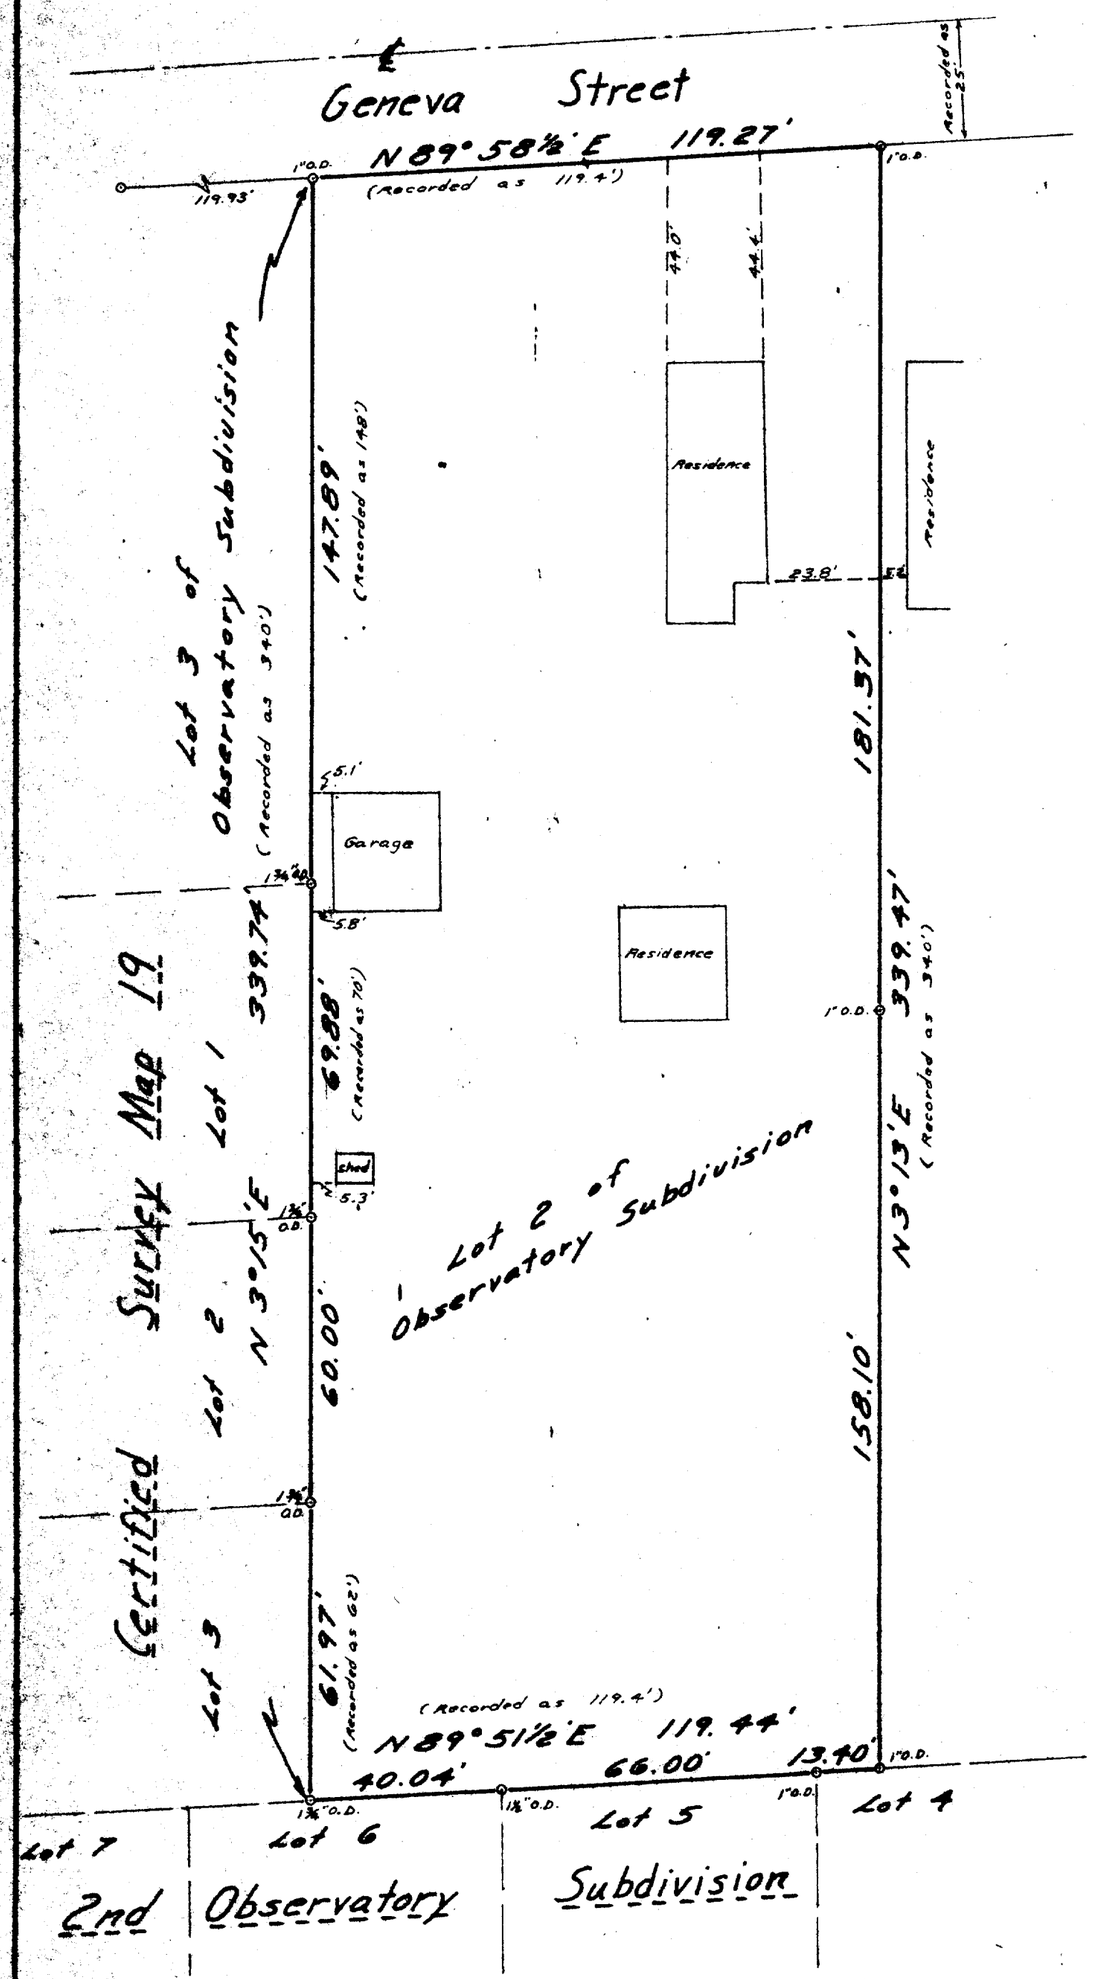

I, Lloyd L. Jensen, surveyor, do hereby certify that under my direction Lot 2 of Observatory Subdivision located in Section 1, Town 1 North, Range 16 East, Village of Williams Bay, Walworth County, Wisconsin has been surveyed and mapped, and that this Plat of Survey is a true representation of the lot lines and location of buildings to the best of my knowledge and belief.

Dated this 16th day of July 1976.

Lloyd L. Jensen S-211

WISCONSIN LLOYD L. JENSEN S-211 ELKHORN, WIS. LAND SURVEYOR

⊙ = Iron pipe survey stake found (inches outside diameter shown)

PLAT OF SURVEY
OF

Lot 2 of Observatory Subdivision, Located in Section 1, Town 1 North, Range 16 East, Village of Williams Bay, Walworth County, Wisconsin

Owner: Dorothy Williams

SCALE 1" = 30'

DATE 16 JULY 1976

NO. 175H 200 9-68

WOB-3

11-318