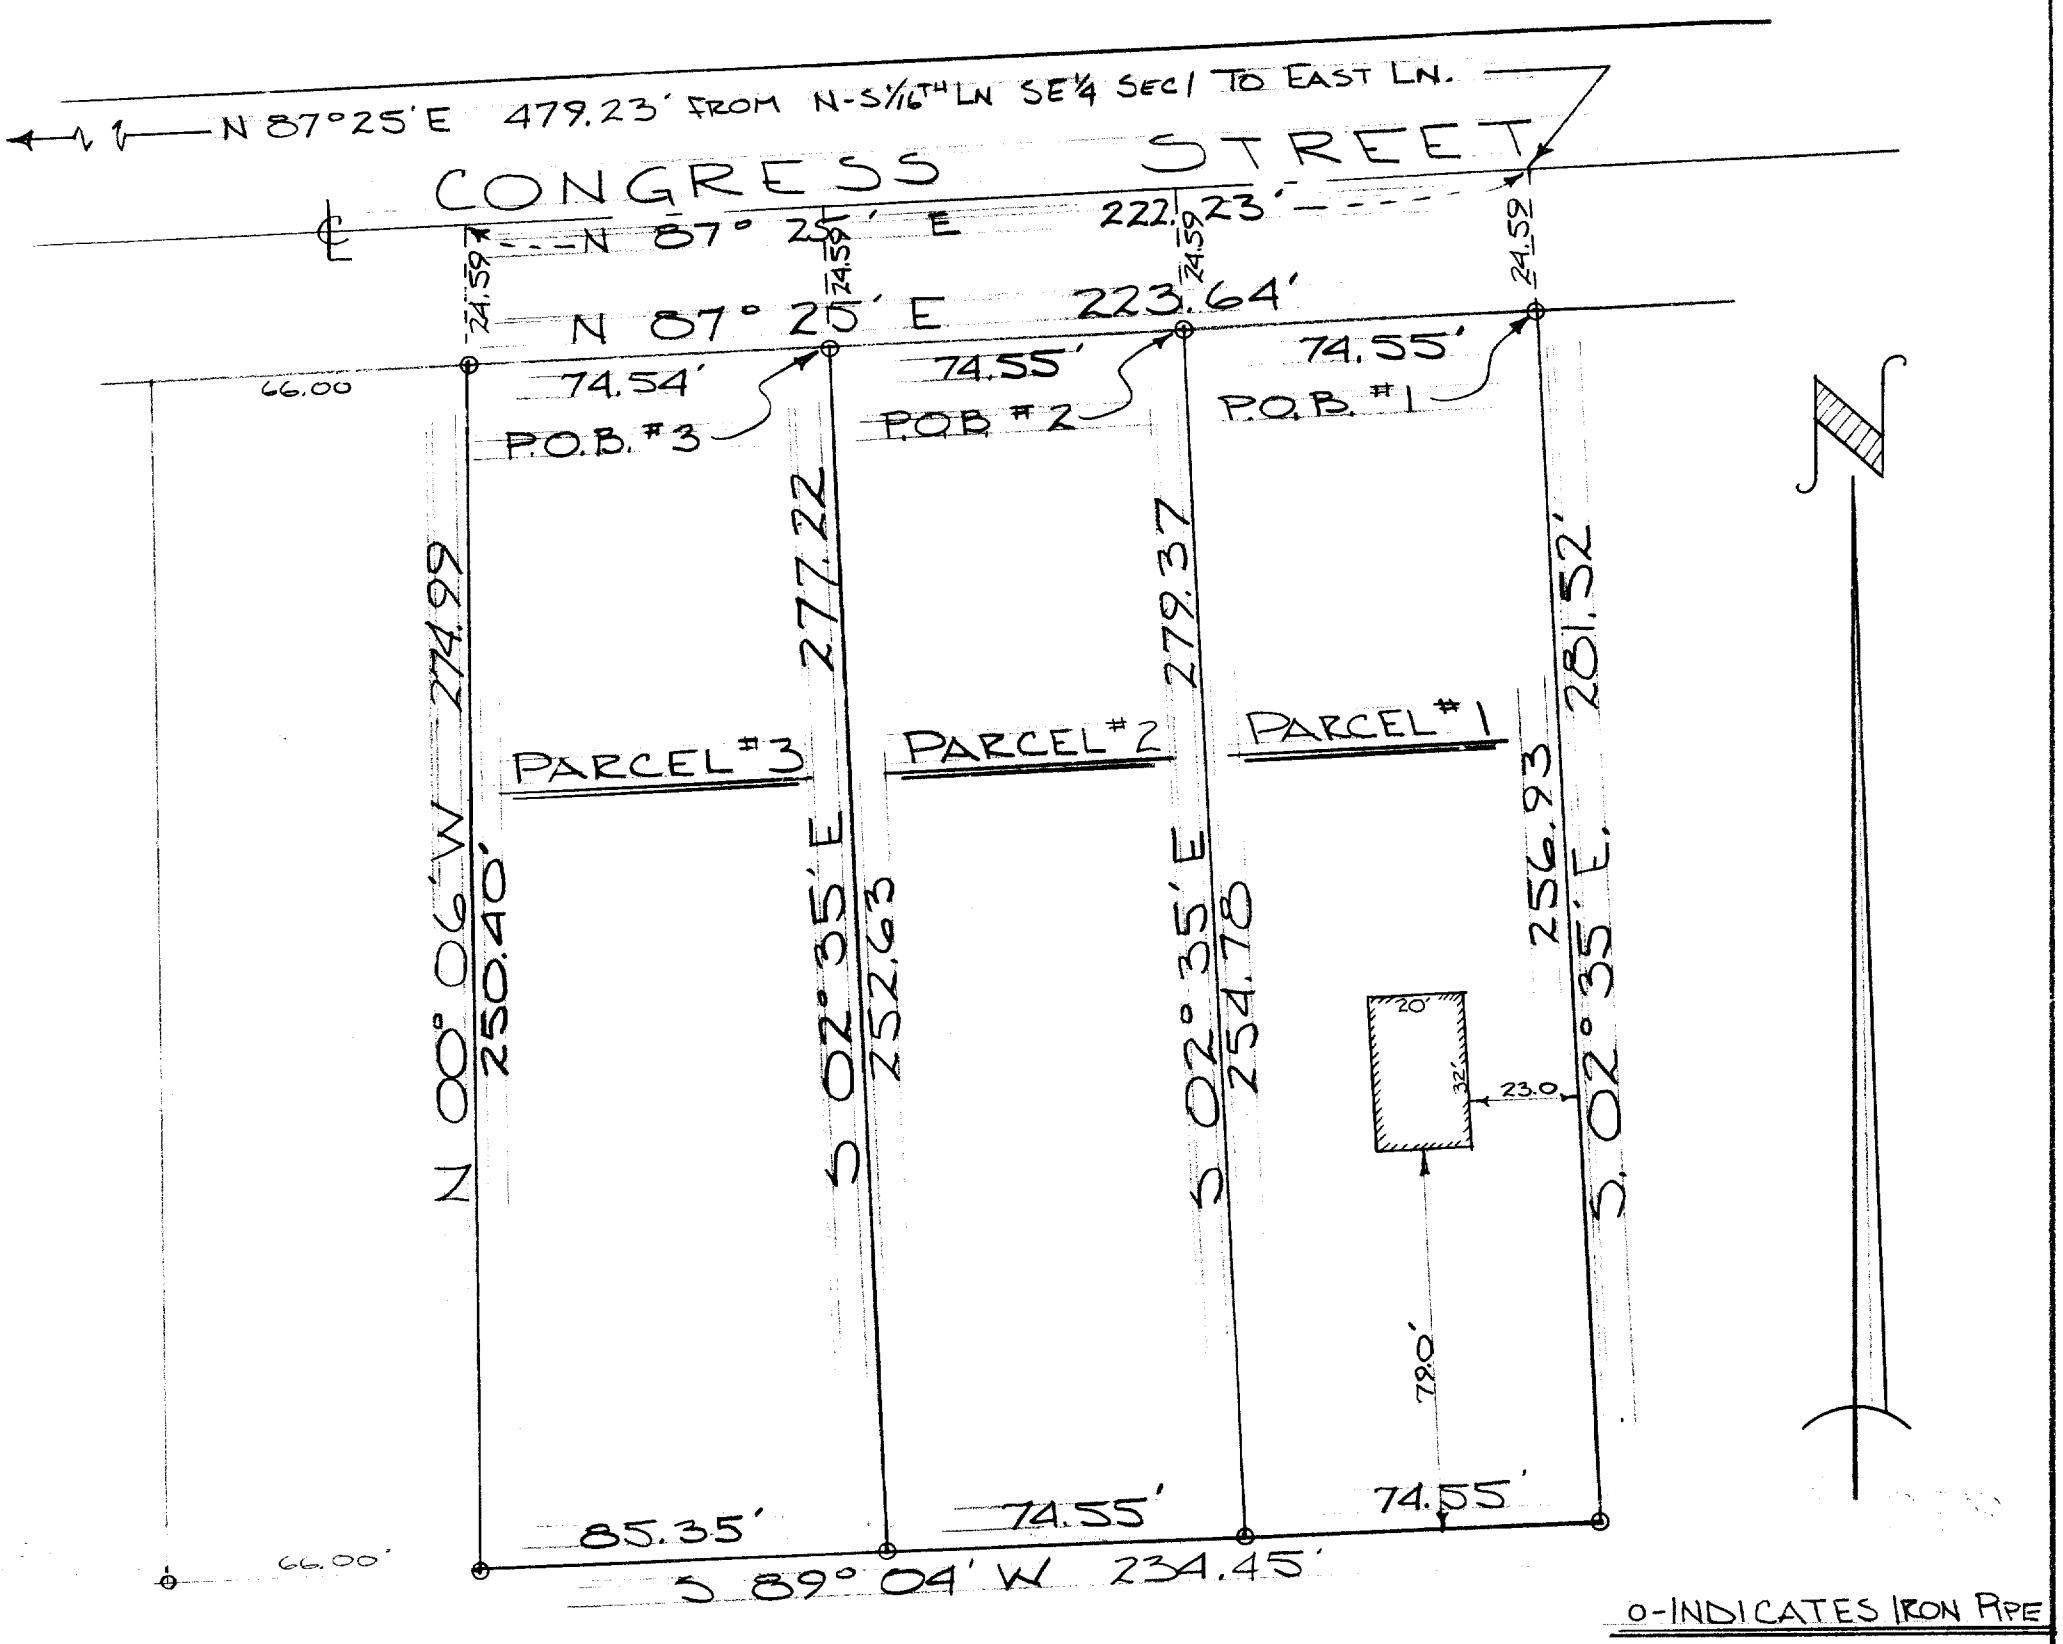


DESCRIPTIONS:

PARCEL #1: Commencing at a point in the N-S 1/16th. line running through the SE¼ of Section 1, T. 1 N., R. 16 E. (said 1/16th. line being the East line of Collie Street) which is 37.67 chains (2486.22 feet) North of the South 1/16th. corner of the SE¼ of Section 1; thence N. 00° 06' W. 269.30 feet to the N. 1/16th. corner of the SE¼ of Section 1; thence N. 87° 25' E. along the E-W¼ Section line of Section 1, 479.23 feet, thence S. 02° 35' E. 24.59 feet to the place of beginning of the lands hereinafter described (said place of beginning being in the South line of Congress Street), thence S. 02° 35' E. 256.93 feet to an iron pipe, thence S. 89° 04' W. 74.55 feet to an iron pipe, thence N. 02° 35' W. 254.78 feet to an iron pipe in the south line of Congress Street, thence N. 87° 25' E. along the South line of Congress Street 74.55 feet to the place of beginning.

PARCEL #2: Commencing at a point in the N-S 1/16th. line running through the SE¼ of Section 1, T. 1 N., R. 16 E. (said 1/16th. line being the East line of Collie Street) which is 37.67 chains (2486.22 feet) North of the South 1/16th. corner of the SE¼ of Section 1; thence N. 00° 06' W. 269.30 feet to the North 1/16th. corner of the SE¼ of Section1; thence N. 87° 25' E. along the E-W¼ Section line of Section 1, 404.68 feet, thence S. 02° 35' E. 24.59 feet to the place of beginning of the lands hereinafter described (said place of beginning being in the South line of Congress Street), thence S. 02° 35' E. 254.78 feet to an iron pipe, thence S. 89° 04' W. 74.55 feet, thence N. 02° 35' W. 252.63 feet to an iron pipe in the South line of Congress Street, thence N. 87° 25' E. along the South line of Congress Street 74.55 feet to the place of beginning.

PARCEL #3: Commencing at a point in the N-S 1/16th. line running through the SE¼ of Section 1, T. 1 N., R. 16 E., (said 1/16th. line being the East line of Collie Street) which is 37.67 chains (2486.22 feet) North of the South 1/16th. corner of the SE¼ of Section 1; thence N. 00° 06' W. 269.30 feet to the North 1/16th. corner of the SE¼ of Section 1; thence N.87° 25' E. along the E-W¼ Section line of Section 1, 330.13 feet, thence S. 02° 35' E. 24.59 feet to the place of beginning of the lands hereinafter described (said place of beginning being in the South line of Congress Street), thence S. 02° 35' E. 252.63 feet to an iron pipe, thence S. 89° 04' W. 85.35 feet, thence N. 00° 06' W. parallel to the East line of Collie Street 250.40 feet to an iron pipe in the South line of Congress Street, thence N. 87° 25' E. along the South line of Congress Street 74.54 feet to the place of beginning.

CERTIFICATE:

I, James F. Biagi, surveyor, do hereby certify that I have surveyed the property hereon described and that the location of the improvements are as shown hereon.

November 28, 1969.

UP-51D, 51C, 51C1, 51A (66'w)

James F. Biagi, R.L.S. 272

WISCONSIN JAMES F. BIAGI LAND SURVEYOR

11-38