
PLAT OF SURVEY

LOT 22, EVANGELICAL FREE CHURCH SUBDIVISION, VILLAGE OF WILLIAMS BAY, WALWORTH COUNTY, WISCONSIN.

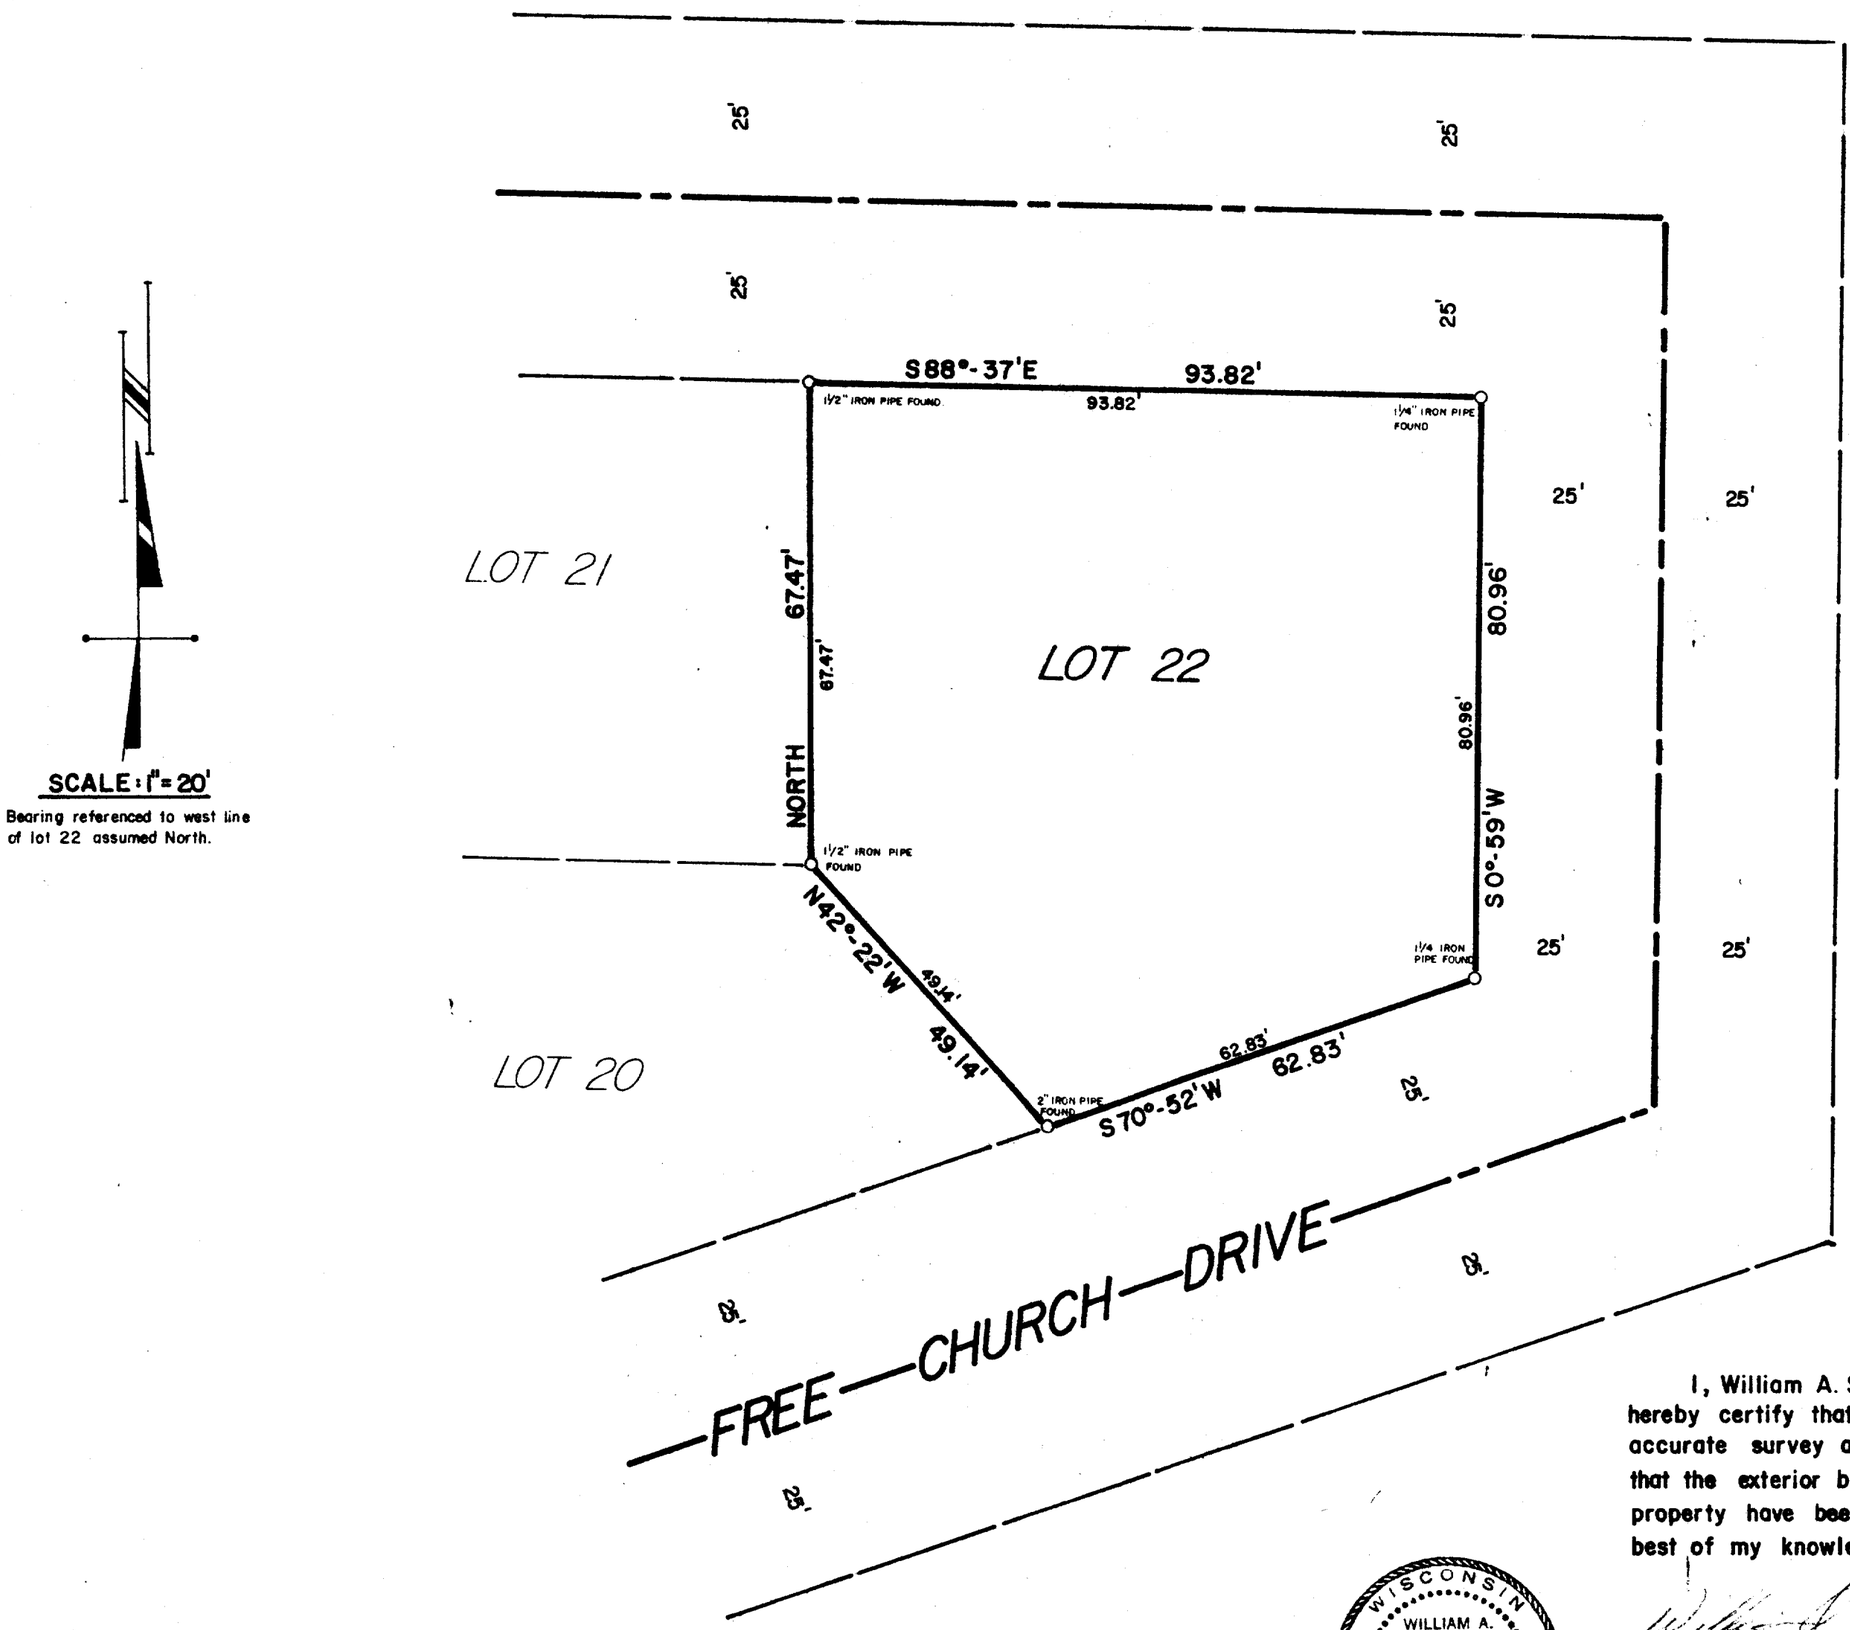

SCALE: 1" = 20'

Bearing referenced to west line of lot 22 assumed North.

Jensen & Johnson
Engineers & Surveyors
Elkhorn, Wisc.

WISCONSIN
WILLIAM A. SHEARMAN
S-1378
ELKHORN
WISC.
LAND SURVEYOR

I, William A. Shearman Registered Land Surveyor do hereby certify that the plat shown hereon is a true and accurate survey and a true representation thereof and that the exterior boundary lines and all divisions of said property have been surveyed under my direction and to best of my knowledge and belief.

William A. Shearman S-1378
Registered Land Surveyor

Dated this 1st day of August 1977.

WEF-22

Surveyed for Glen Rose.
P.O. 1658.198

11-350