


DUNHAM SURVEYING, S.C.

SURVEYING & SUBDIVIDING
DELA VAN, WISCONSIN 53115

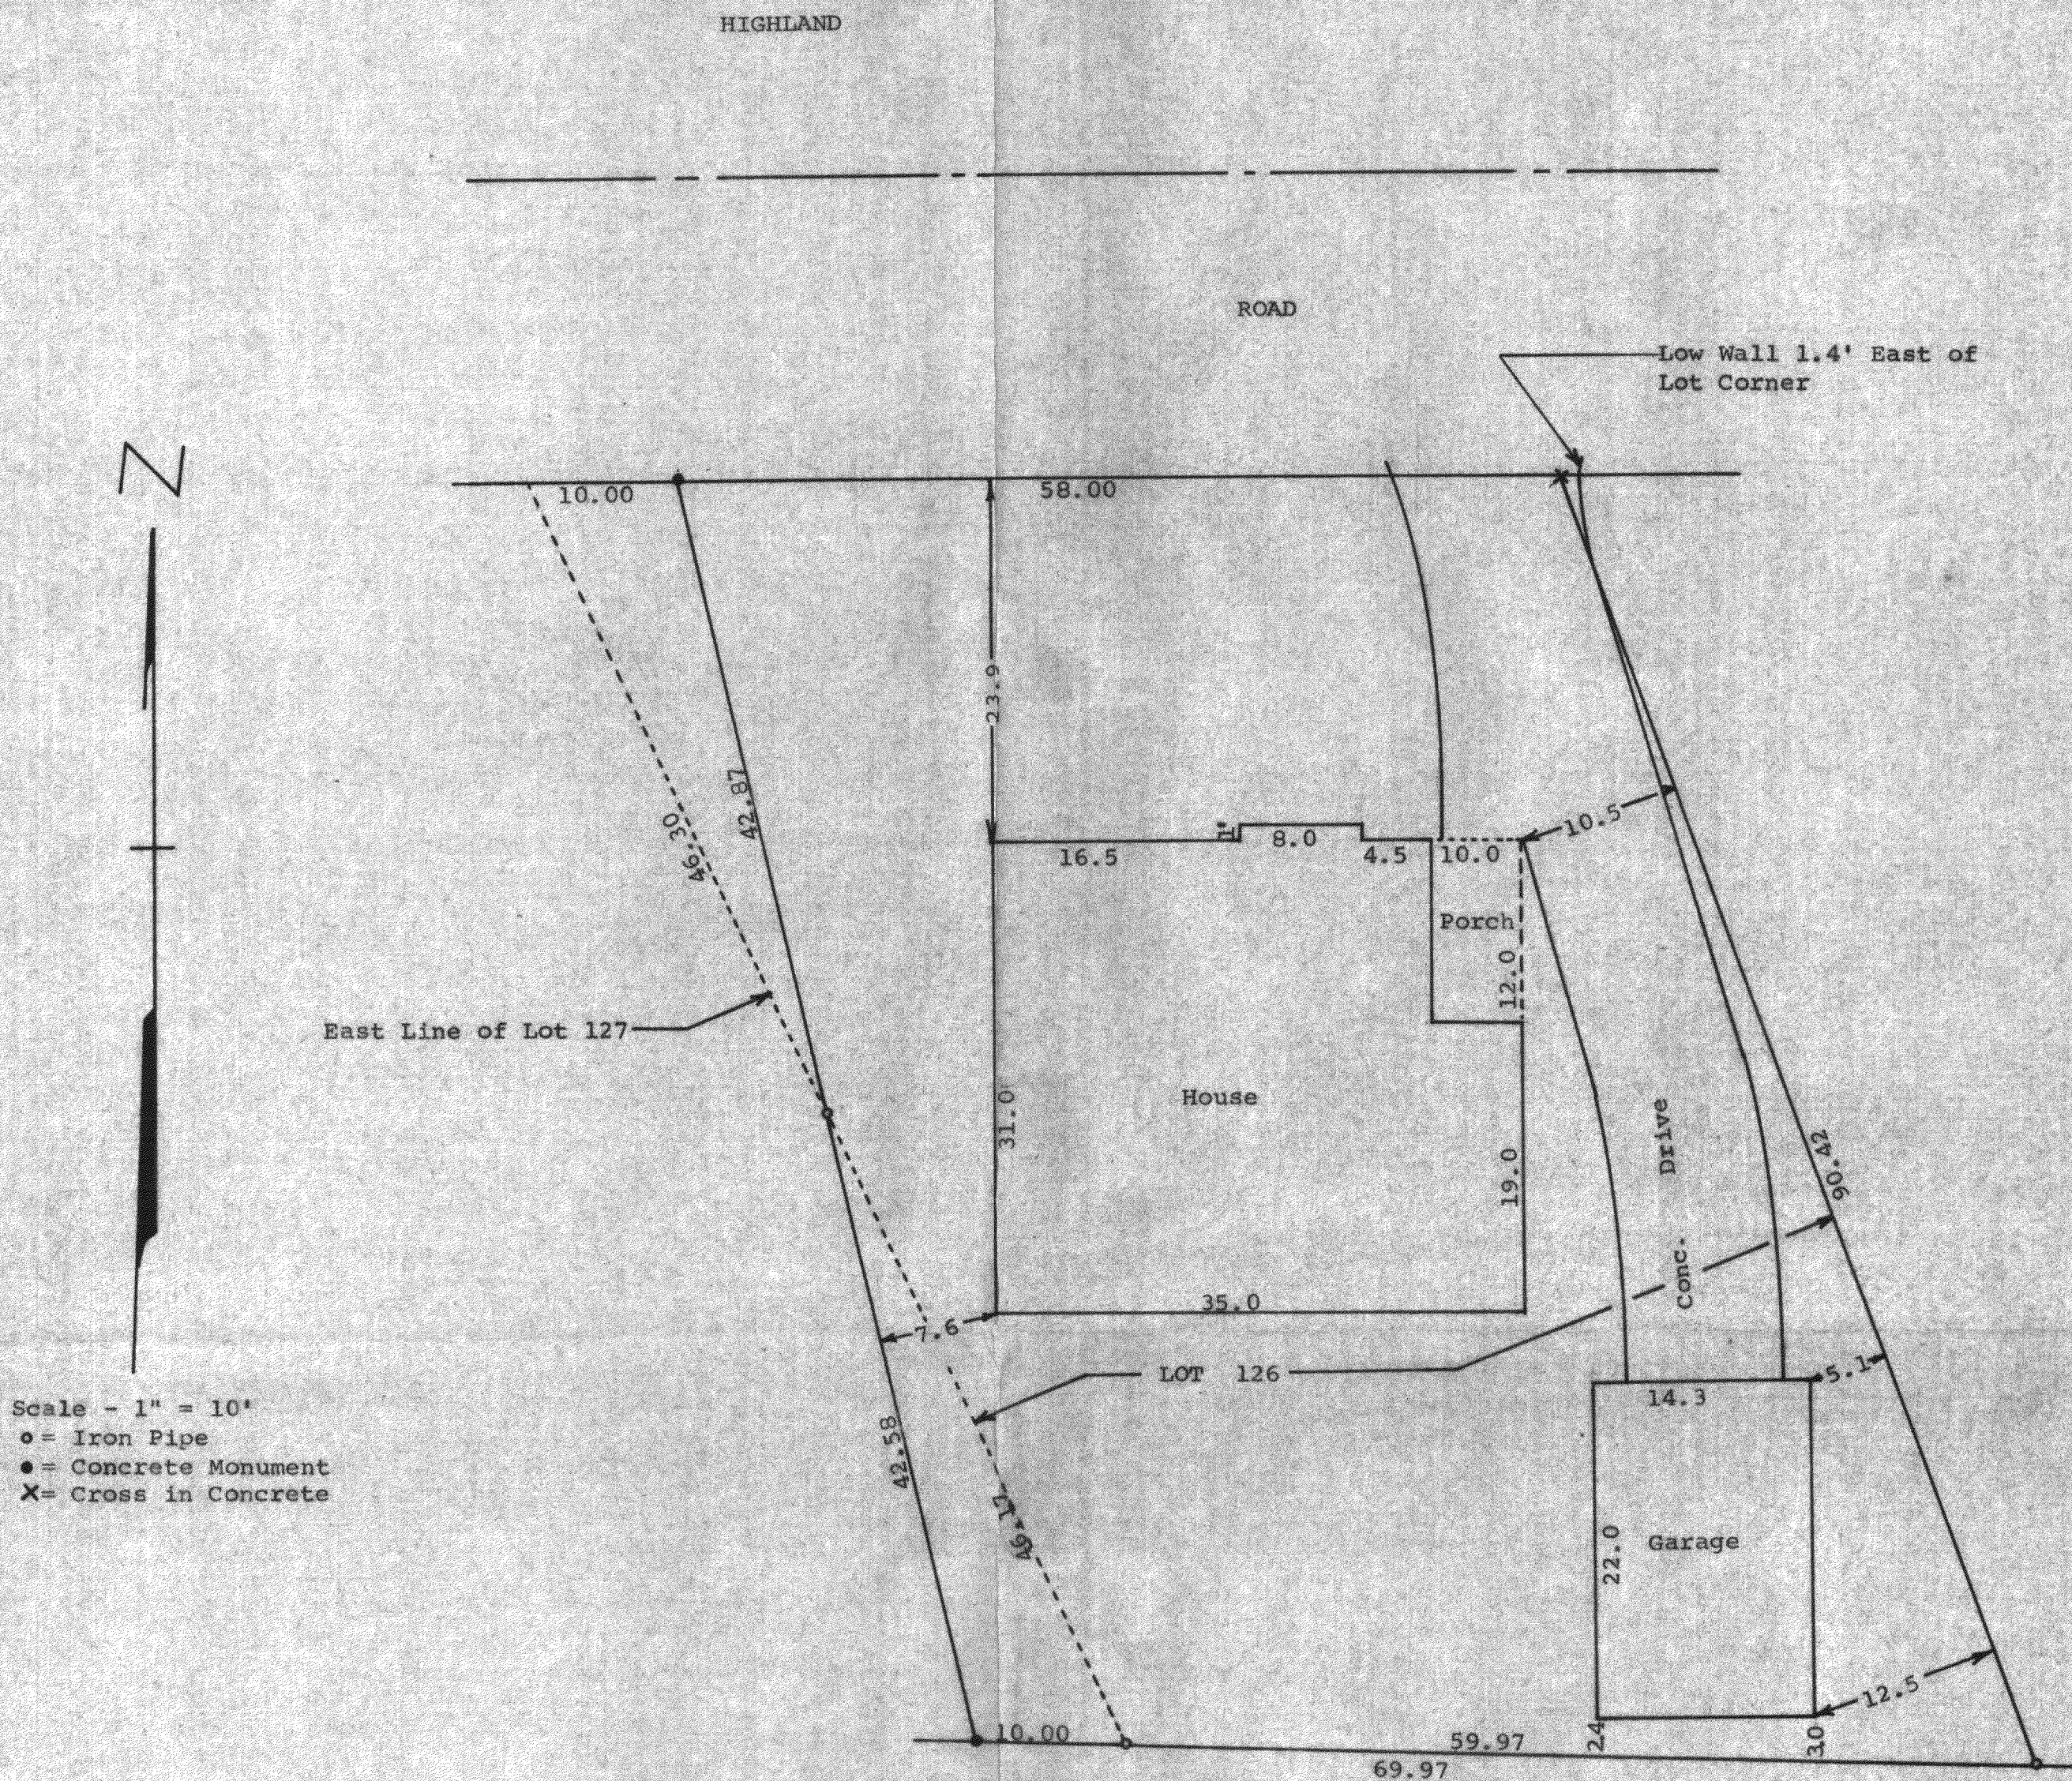

STATE OF WISCONSIN)
COUNTY OF WALWORTH) SS

I, George T. Dunham, Surveyor, certify that I have surveyed the property described as follows:

All of Lot 126 of the Second Addition to Cedar Point Park, a subdivision of the Village of Williams Bay, according to the plat thereof recorded in the Office of the Register of Deeds for Walworth County in Volume 9 of Plats on page 144, except therefrom, Beginning at the northwest corner of said Lot 126; thence Southeasterly along the westerly line of said Lot 126, 46.30 feet; thence northwesterly 42.87 feet to a concrete monument located on the north line of said Lot 126 and 10.00 feet east of the northwest corner of said Lot 126; thence west 10.00 feet to the place of beginning. Also a part of Lot 127 of said Second Addition to Cedar Point Park, Village of Williams Bay, described as follows: Beginning at the southeast corner of Lot 127; thence northwesterly along the southeasterly line of said Lot 127, 46.17 feet; thence southeasterly 42.58 feet to a concrete monument located on the south line of said Lot 127 and 10.00 feet west of the southeast corner of said Lot 127; thence East 10.00 feet to the place of beginning

and the above map is a true representation thereof and shows the size and location of the property, its exterior boundaries, the location and dimensions of all structures thereon, fences, apparent easements and roadways and visible encroachments, if any.

April 12, 1978

George T. Dunham
George T. Dunham, Surveyor

