
HAROLD H. KOLB

REGISTERED PROFESSIONAL LAND SURVEYOR
LAKE GENEVA, WISCONSIN

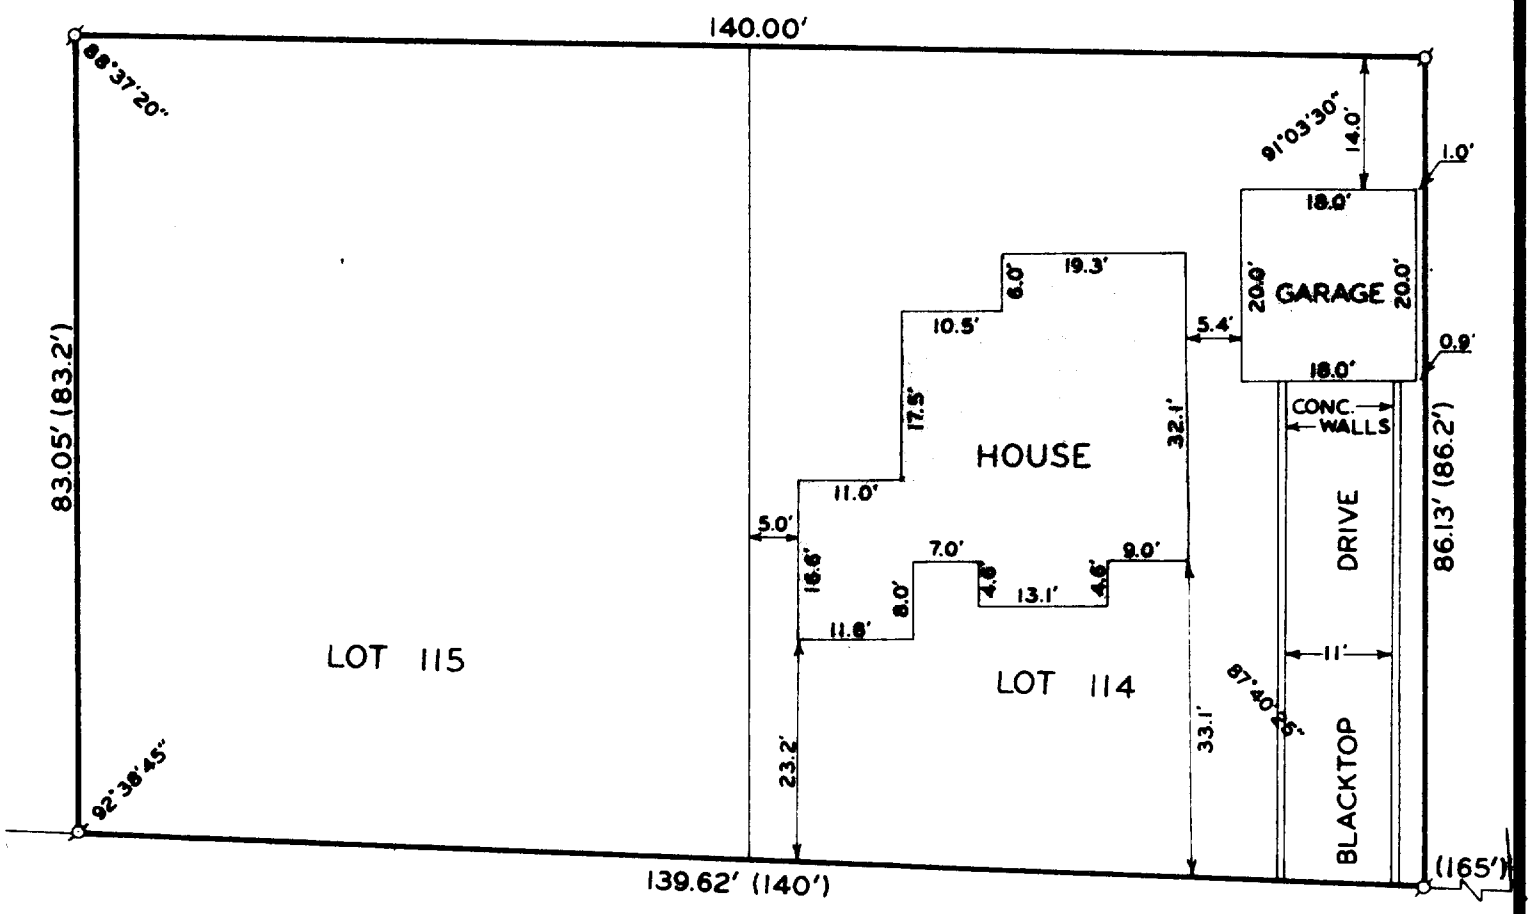

℄

PARK RIDGE ROAD · 40' WIDE

PLAT OF SURVEY OF

LOTS 114 AND 115 IN THE 2ND ADDITION TO CEDAR POINT PARK, A SUBDIVISION LOCATED IN THE VILLAGE OF WILLIAMS BAY, WALWORTH COUNTY, WISCONSIN.

ORDERED BY: HOTTON REALTY
WILLIAMS BAY, WI 53191

OWNER: WAYNE RANK

WISCONSIN
HAROLD H. KOLB
S-187
LAKE GENEVA, WIS.
LAND SURVEYOR

I, HAROLD H. KOLB, DO HEREBY CERTIFY THAT I HAVE SURVEYED THE PROPERTY HEREON DESCRIBED ACCORDING TO THE OFFICIAL RECORDS, AND THAT THE PLAT HEREON IS A CORRECT REPRESENTATION OF THE LOT LINES.

N

SCALE: 1"= 20'

LEGEND

O — IRON PIPE PLACED, 1" x 24" 1.13 LB./LIN. FT.
● — CONCRETE MONUMENT, 5" DIA. x 30"
ø — IRON PIPE FOUND ( ) — RECORDED AS

Harold H. Kolb
HAROLD H. KOLB
WISCONSIN REGISTERED LAND SURVEYOR, S-187
DATE June 1, 1978

BRUNING 40-105 1M-6-71

WCP 2-12, 13

11-388