
PLAT OF SURVEY
OF

LOT 176 CEDAR POINT PARK 2ND ADDITION
VILLAGE OF WILLIAMS BAY, WALWORTH
COUNTY, WISCONSIN

WISCONSIN
THOMAS P. A. JENSEN
S-1084
ELKHORN
WIS.
LAND SURVEYOR

I CERTIFY THAT I HAVE SURVEYED THE ABOVE DESCRIBED PROPERTY & THAT THE PLAT SHOWN HEREON IS AN ACCURATE SURVEY & A TRUE REPRESENTATION THEREOF & CORRECTLY SHOWS THE BOUNDARY LINES OF SAID PROPERTY.
MAR. 17, 1978

JENSEN SURVEYING & MAPPING
ELKHORN WIS

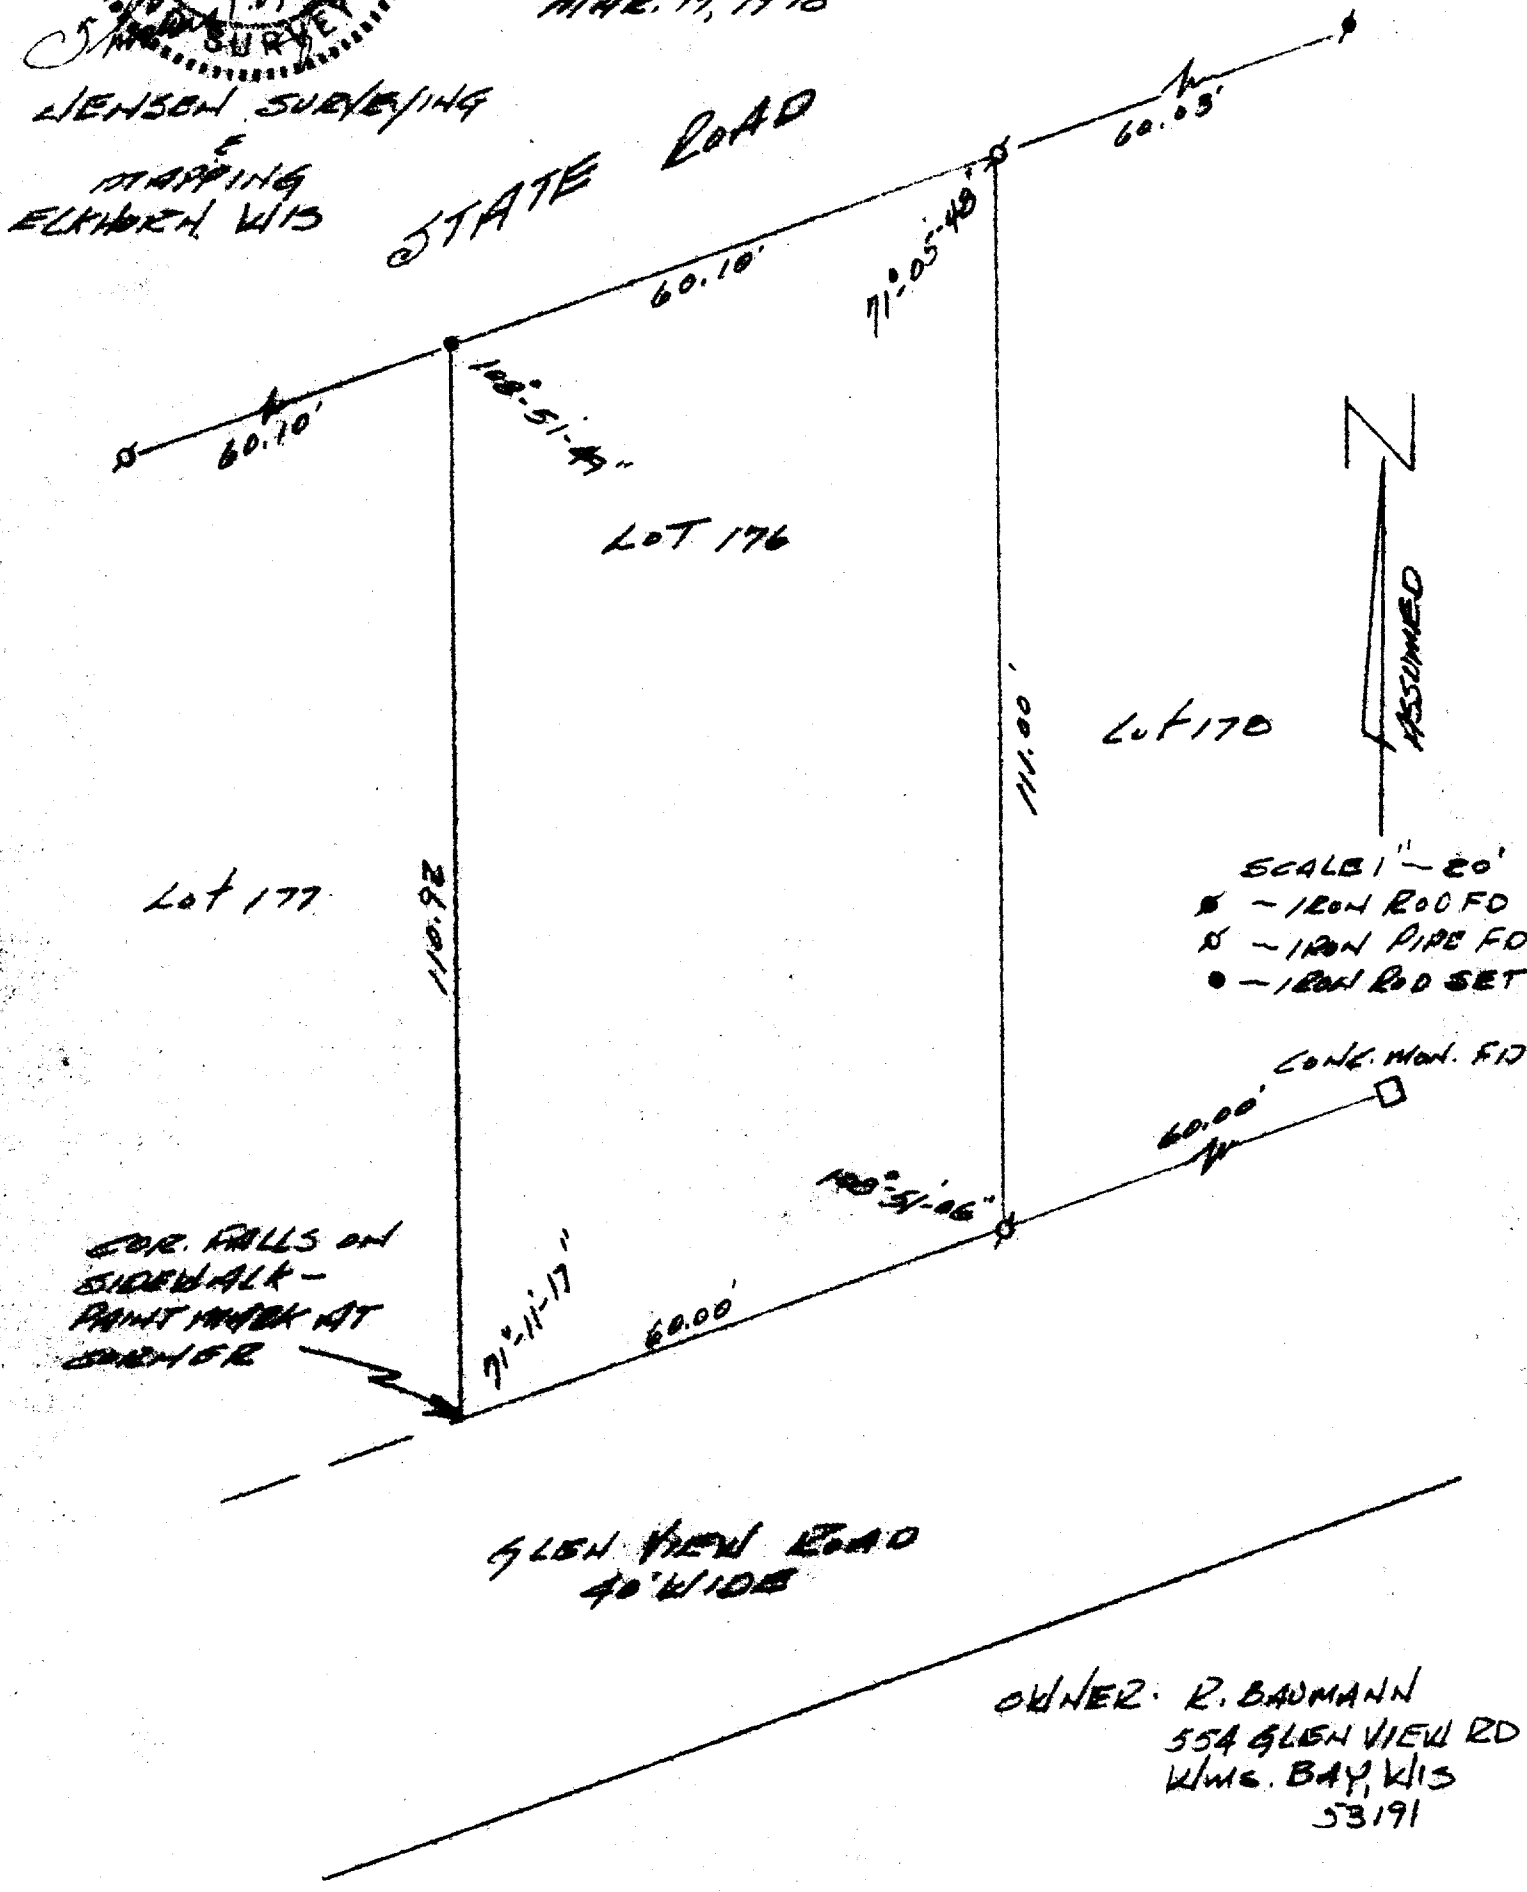

OWNER: R. BAUMANN
554 GLEN VIEW RD
W/MG. BAY, WIS
53191

P.O. 1978. 011

WCP2-68

11-393