
FARRIS, HANSEN & COOPER, INC.
ENGINEERING, SURVEYING AND LAND PLANNING
715 W. WALWORTH ST. - P.O. BOX 487 - ELKHORN, WI 53121
OFFICE: 414/723-2098




PLAT OF SURVEY OF

Lot 13, Evangelical Free Church Subdivision, located in the Northeast 1/4 of Section 6, T 1 N, R 17 E, Village of Williams Bay, Walworth County, Wisconsin.

NOTE: The Northerly line of the above described parcel is assumed to bear S 88°54' E as platted.

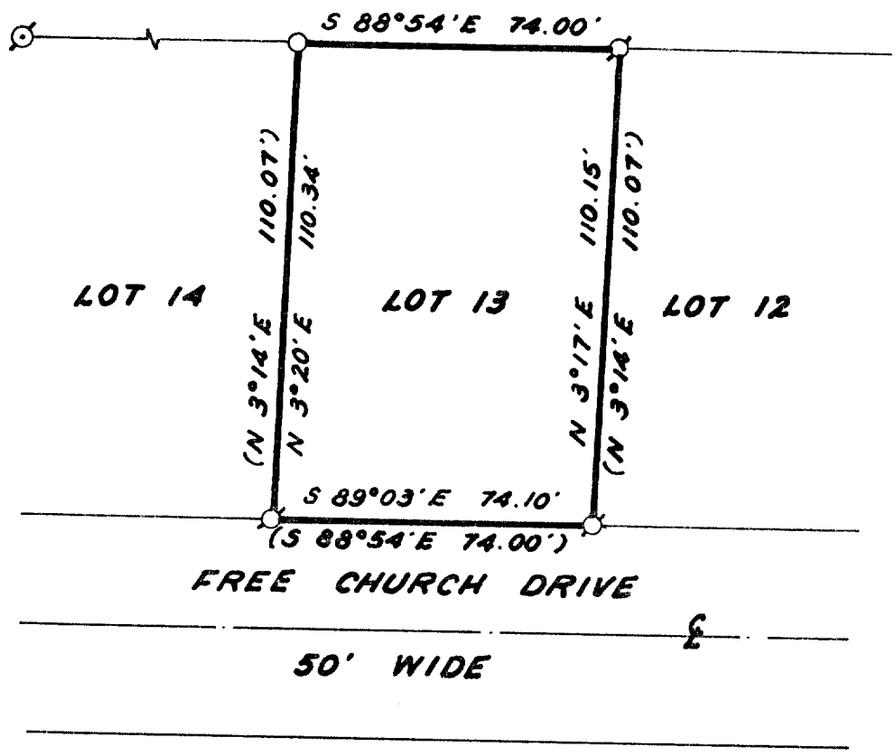

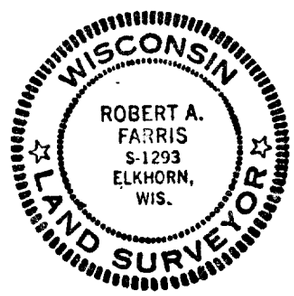

I HEREBY CERTIFY that I have surveyed the property described hereon and that this Plat of Survey accurately represents the exterior boundaries thereof to the best of my knowledge and belief.

Robert A. Farris
Robert A. Farris
Wis. Registered Land Surveyor, S-1293

18 JAN. 1979
Date

- ⌀— 1-1/2" Dia. Iron Pipe Found
- ⌀— 2" Dia. Iron Pipe Found
- O— 1" Dia. Iron Pipe Set
- ( )— Record Dimension

ORDERED BY:
Richard Jennings

DRAWING NUMBER 1454

WEF-13

11-399-F