
KOLB LAND CONSULTING, INC.
LAKE GENEVA, WIS.

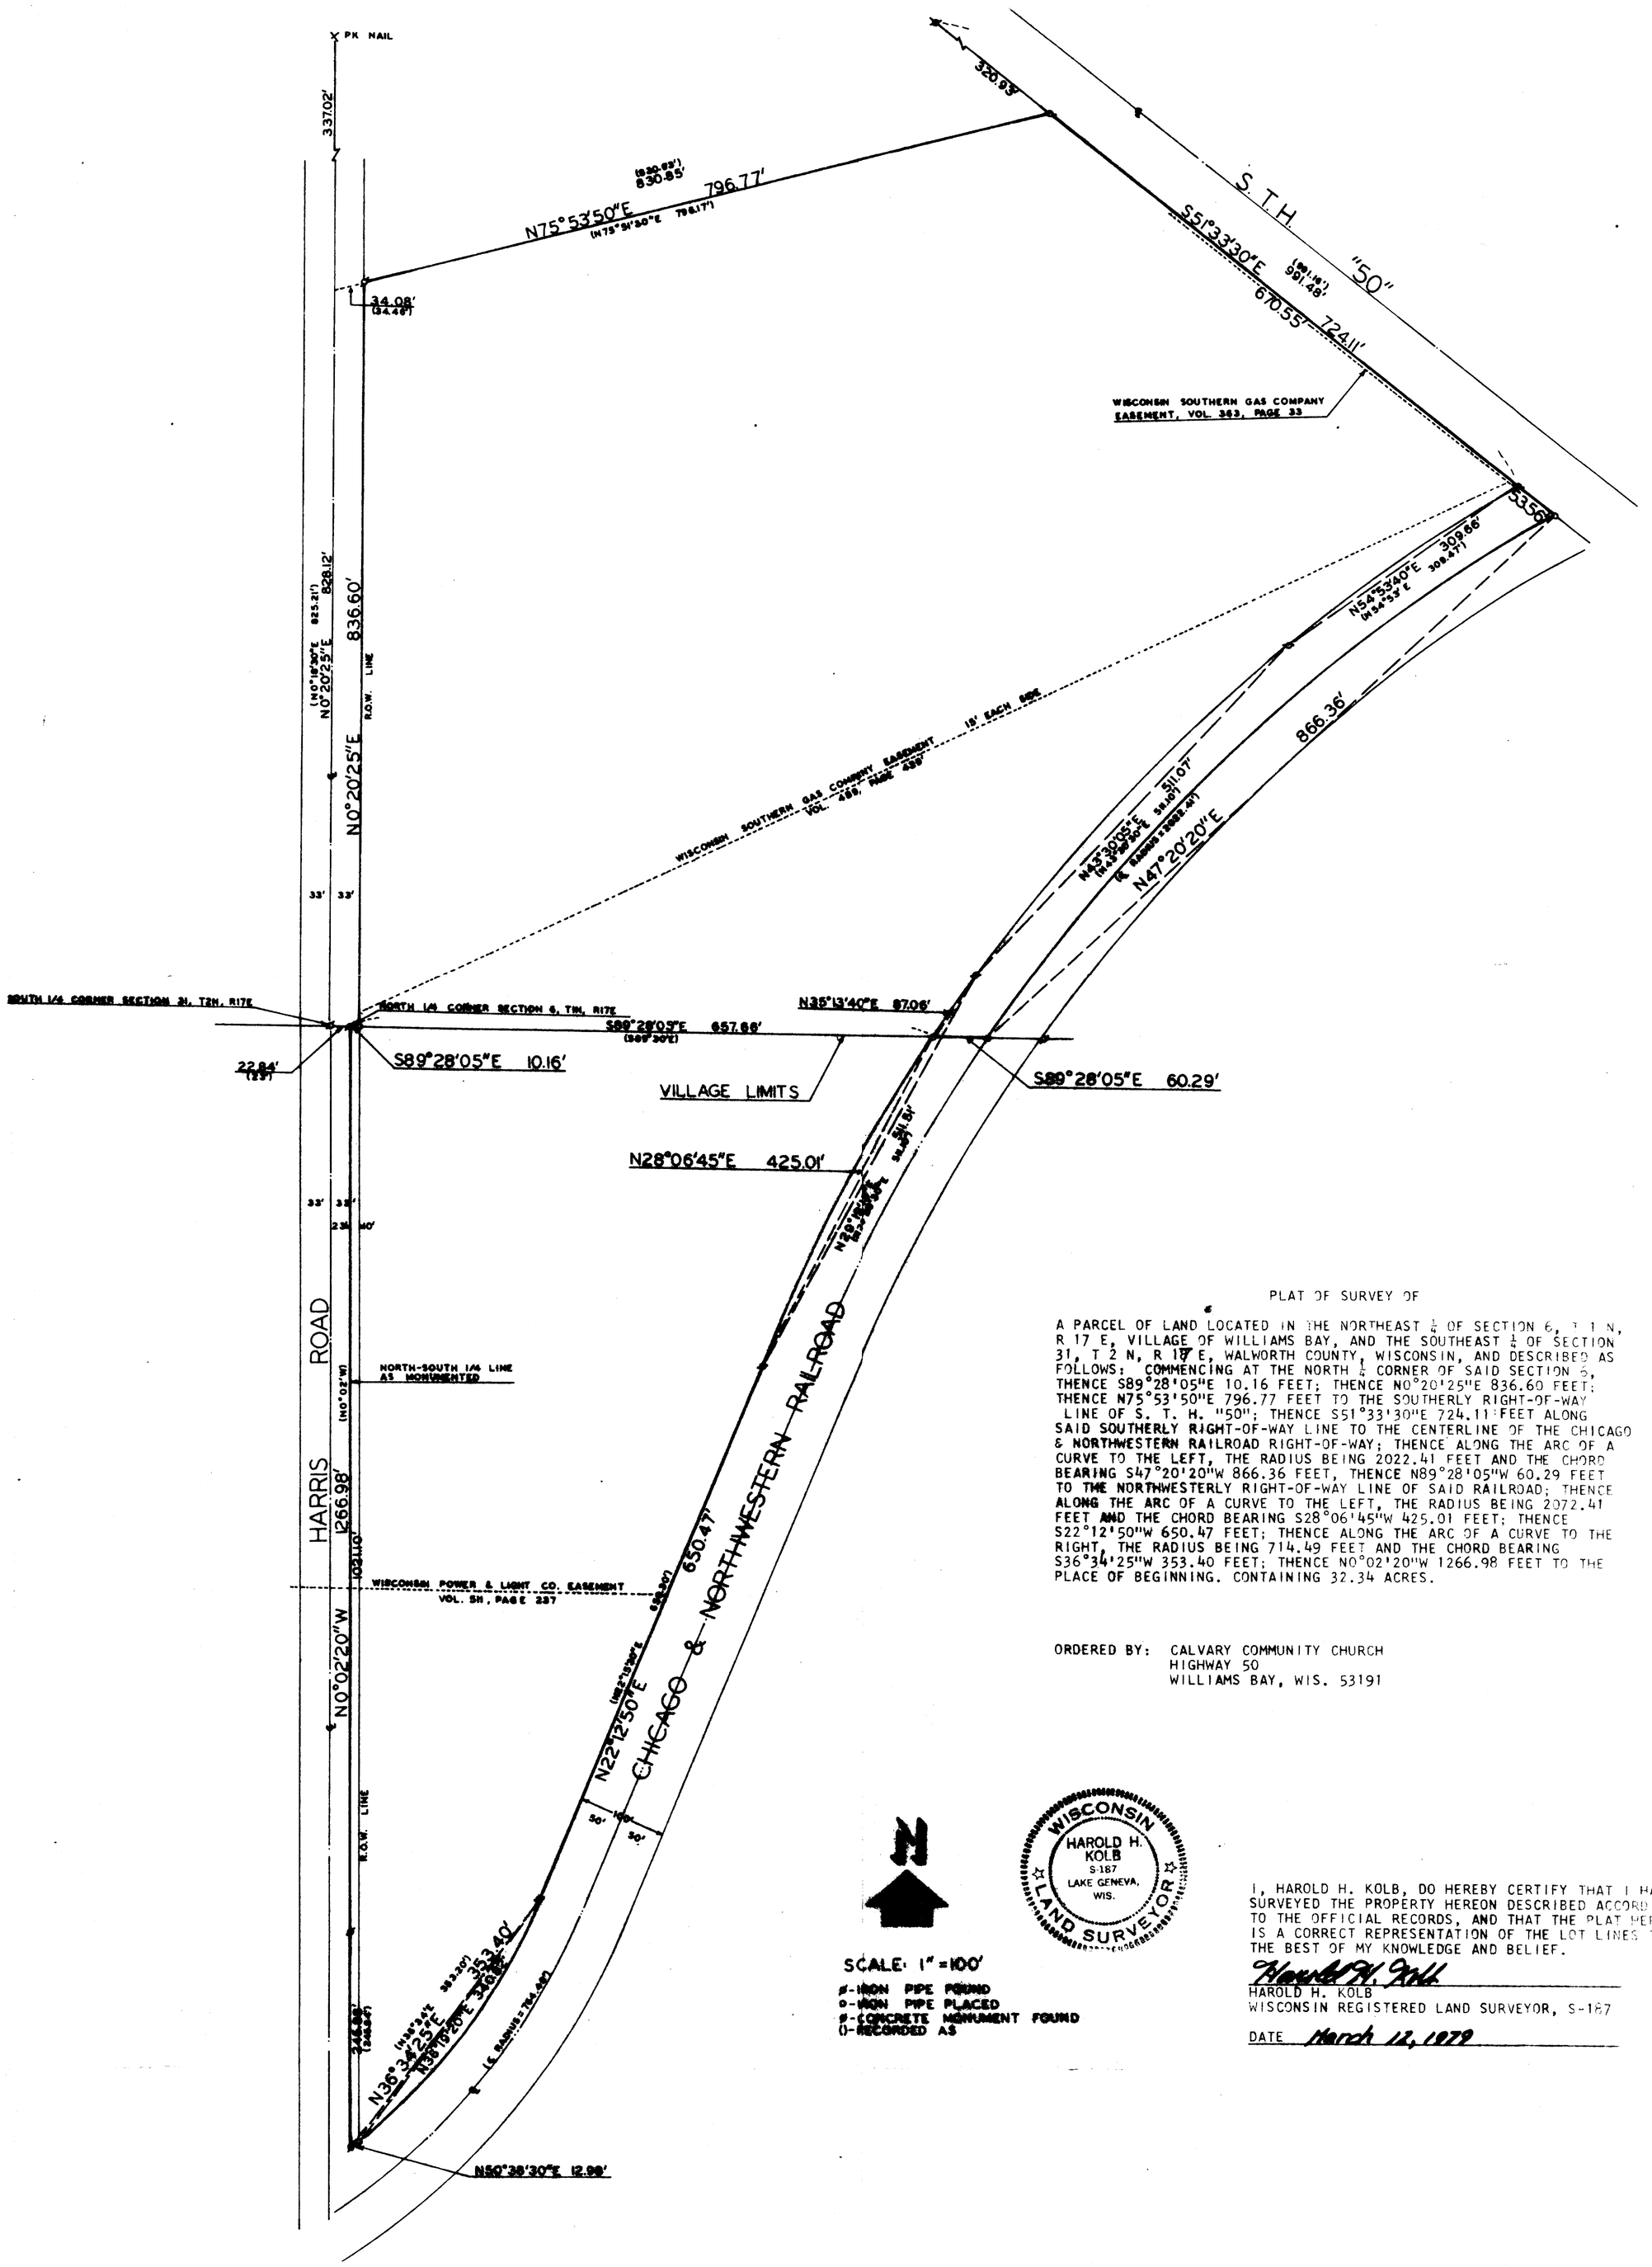

PLAT OF SURVEY OF

A PARCEL OF LAND LOCATED IN THE NORTHEAST ¼ OF SECTION 6, T 1 N, R 17 E, VILLAGE OF WILLIAMS BAY, AND THE SOUTHEAST ¼ OF SECTION 31, T 2 N, R 17 E, WALWORTH COUNTY, WISCONSIN, AND DESCRIBED AS FOLLOWS: COMMENCING AT THE NORTH ¼ CORNER OF SAID SECTION 6, THENCE S89°28'05"E 10.16 FEET; THENCE N0°20'25"E 836.60 FEET; THENCE N75°53'50"E 796.77 FEET TO THE SOUTHERLY RIGHT-OF-WAY LINE OF S. T. H. "50"; THENCE S51°33'30"E 724.11 FEET ALONG SAID SOUTHERLY RIGHT-OF-WAY LINE TO THE CENTERLINE OF THE CHICAGO & NORTHWESTERN RAILROAD RIGHT-OF-WAY; THENCE ALONG THE ARC OF A CURVE TO THE LEFT, THE RADIUS BEING 2022.41 FEET AND THE CHORD BEARING S47°20'20"W 866.36 FEET, THENCE N89°28'05"W 60.29 FEET TO THE NORTHWESTERLY RIGHT-OF-WAY LINE OF SAID RAILROAD; THENCE ALONG THE ARC OF A CURVE TO THE LEFT, THE RADIUS BEING 2072.41 FEET AND THE CHORD BEARING S28°06'45"W 425.01 FEET; THENCE S22°12'50"W 650.47 FEET; THENCE ALONG THE ARC OF A CURVE TO THE RIGHT, THE RADIUS BEING 714.49 FEET AND THE CHORD BEARING S36°34'25"W 353.40 FEET; THENCE N0°02'20"W 1266.98 FEET TO THE PLACE OF BEGINNING. CONTAINING 32.34 ACRES.

ORDERED BY: CALVARY COMMUNITY CHURCH
HIGHWAY 50
WILLIAMS BAY, WIS. 53191

N

SCALE: 1" = 100'

●-IRON PIPE FOUND
○-IRON PIPE PLACED
■-CONCRETE MONUMENT FOUND
()-RECORDED AS

WISCONSIN
HAROLD H. KOLB
S-187
LAKE GENEVA, WIS.
LAND SURVEYOR

I, HAROLD H. KOLB, DO HEREBY CERTIFY THAT I HAVE SURVEYED THE PROPERTY HEREON DESCRIBED ACCORDING TO THE OFFICIAL RECORDS, AND THAT THE PLAT HEREOF IS A CORRECT REPRESENTATION OF THE LOT LINES TO THE BEST OF MY KNOWLEDGE AND BELIEF.

Harold H. Kolb
HAROLD H. KOLB
WISCONSIN REGISTERED LAND SURVEYOR, S-187

DATE March 12, 1979

UP-81 + Part of G-31-6

U- 403K