
DUNHAM SURVEYING, S. C.
SURVEYING & SUBDIVIDING
DELAVAN, WISCONSIN 53115

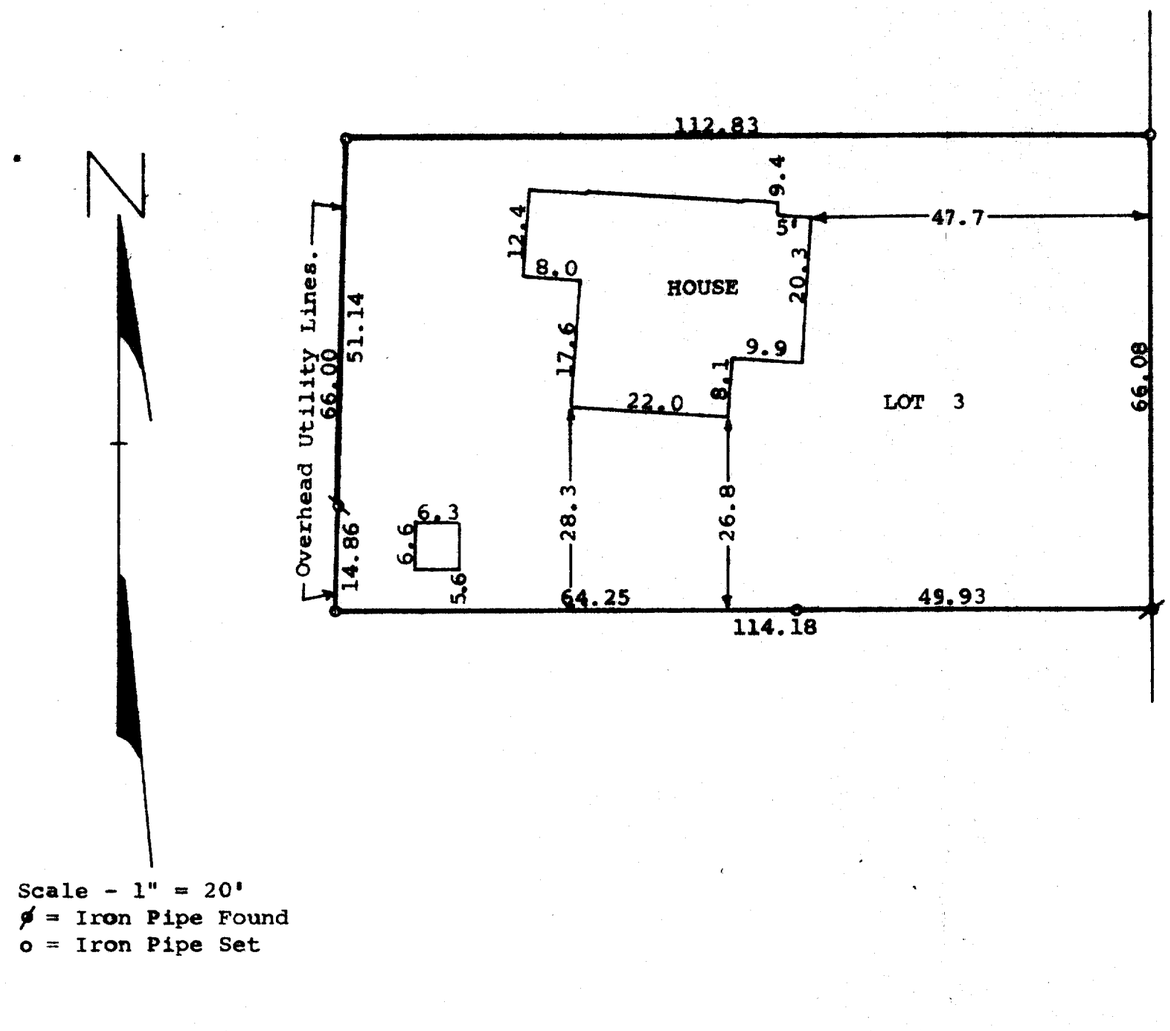

Scale - 1" = 20'
ø = Iron Pipe Found
o = Iron Pipe Set

STATE OF WISCONSIN)
COUNTY OF WALWORTH) SS

I, James M. Dunham, Surveyor, certify that I have surveyed the property described as follows,

Lot 3, Block 15 of Williams Second Addition to the Village of Williams Bay, Walworth County, Wisconsin,

and that the above map is a true representation thereof and shows the size and location of the property, its exterior boundaries, the location of all visible structures and dimensions of all principal buildings thereon, boundary fences, apparent easements, roadways and visible encroachments, if any.

This survey is made for the use of the present owners of the property, and also those who purchase, mortgage, or guarantee the title thereto within one (1) year from date hereof.

June 24, 1981

James M Dunham
James M. Dunham, Surveyor

WISCONSIN
JAMES M. DUNHAM
S-1331
DELAVAN, WIS.
LAND SURVEYOR

WOP-212

11-404D