
WILMETTE ROAD

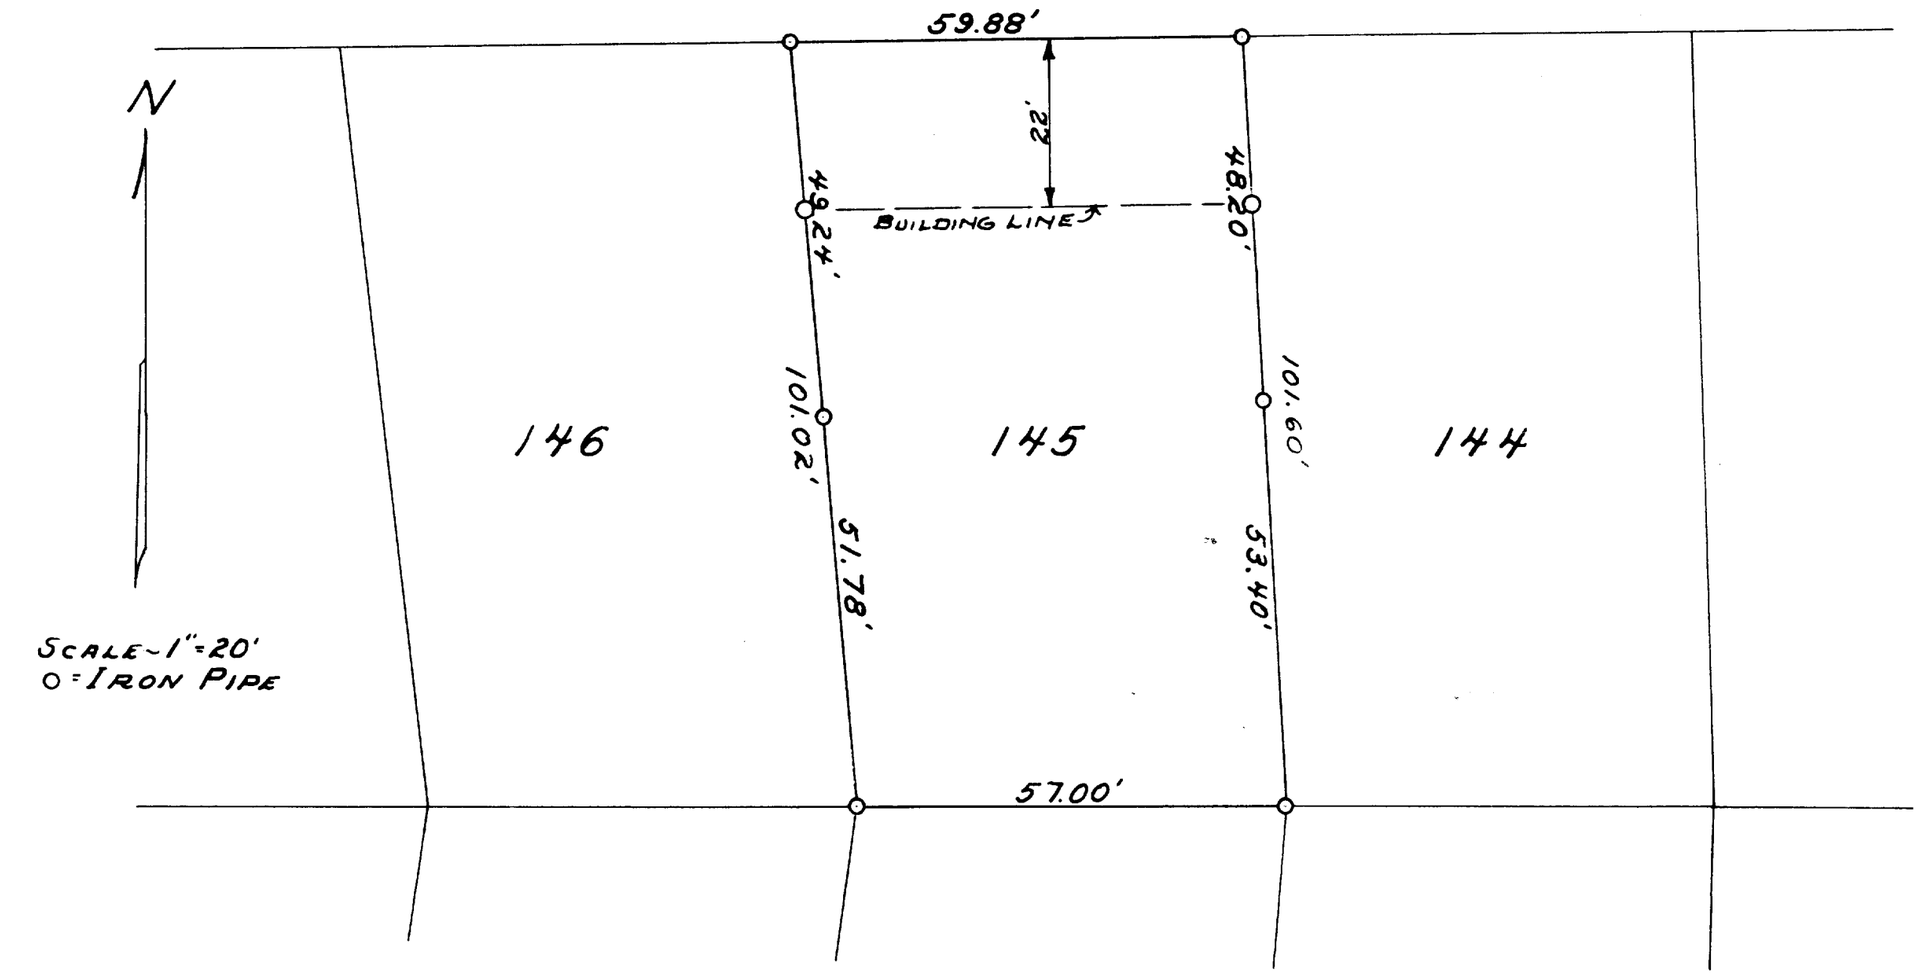

PLAT OF SURVEY OF LOT 145 OF THE 2ND ADDITION TO CEDAR POINT PARK LOCATED IN THE VILLAGE OF WILLIAMS BAY, WALWORTH COUNTY, WISCONSIN.
SEPT. 1948

Floyd L. Jensen 11-40
SURVEYOR

WCP2-41