
FARRIS, HANSEN & COOPER, INC.
ENGINEERING, SURVEYING AND LAND PLANNING
715 W. WALWORTH ST. - P.O. BOX 487 - ELKHORN, WI 53121
OFFICE: 414/723-2096

PLAT OF SURVEY OF LOT 11, BLOCK 7 OF THE ORIGINAL PLAT OF WILLIAMS BAY, WALWORTH COUNTY, WISCONSIN

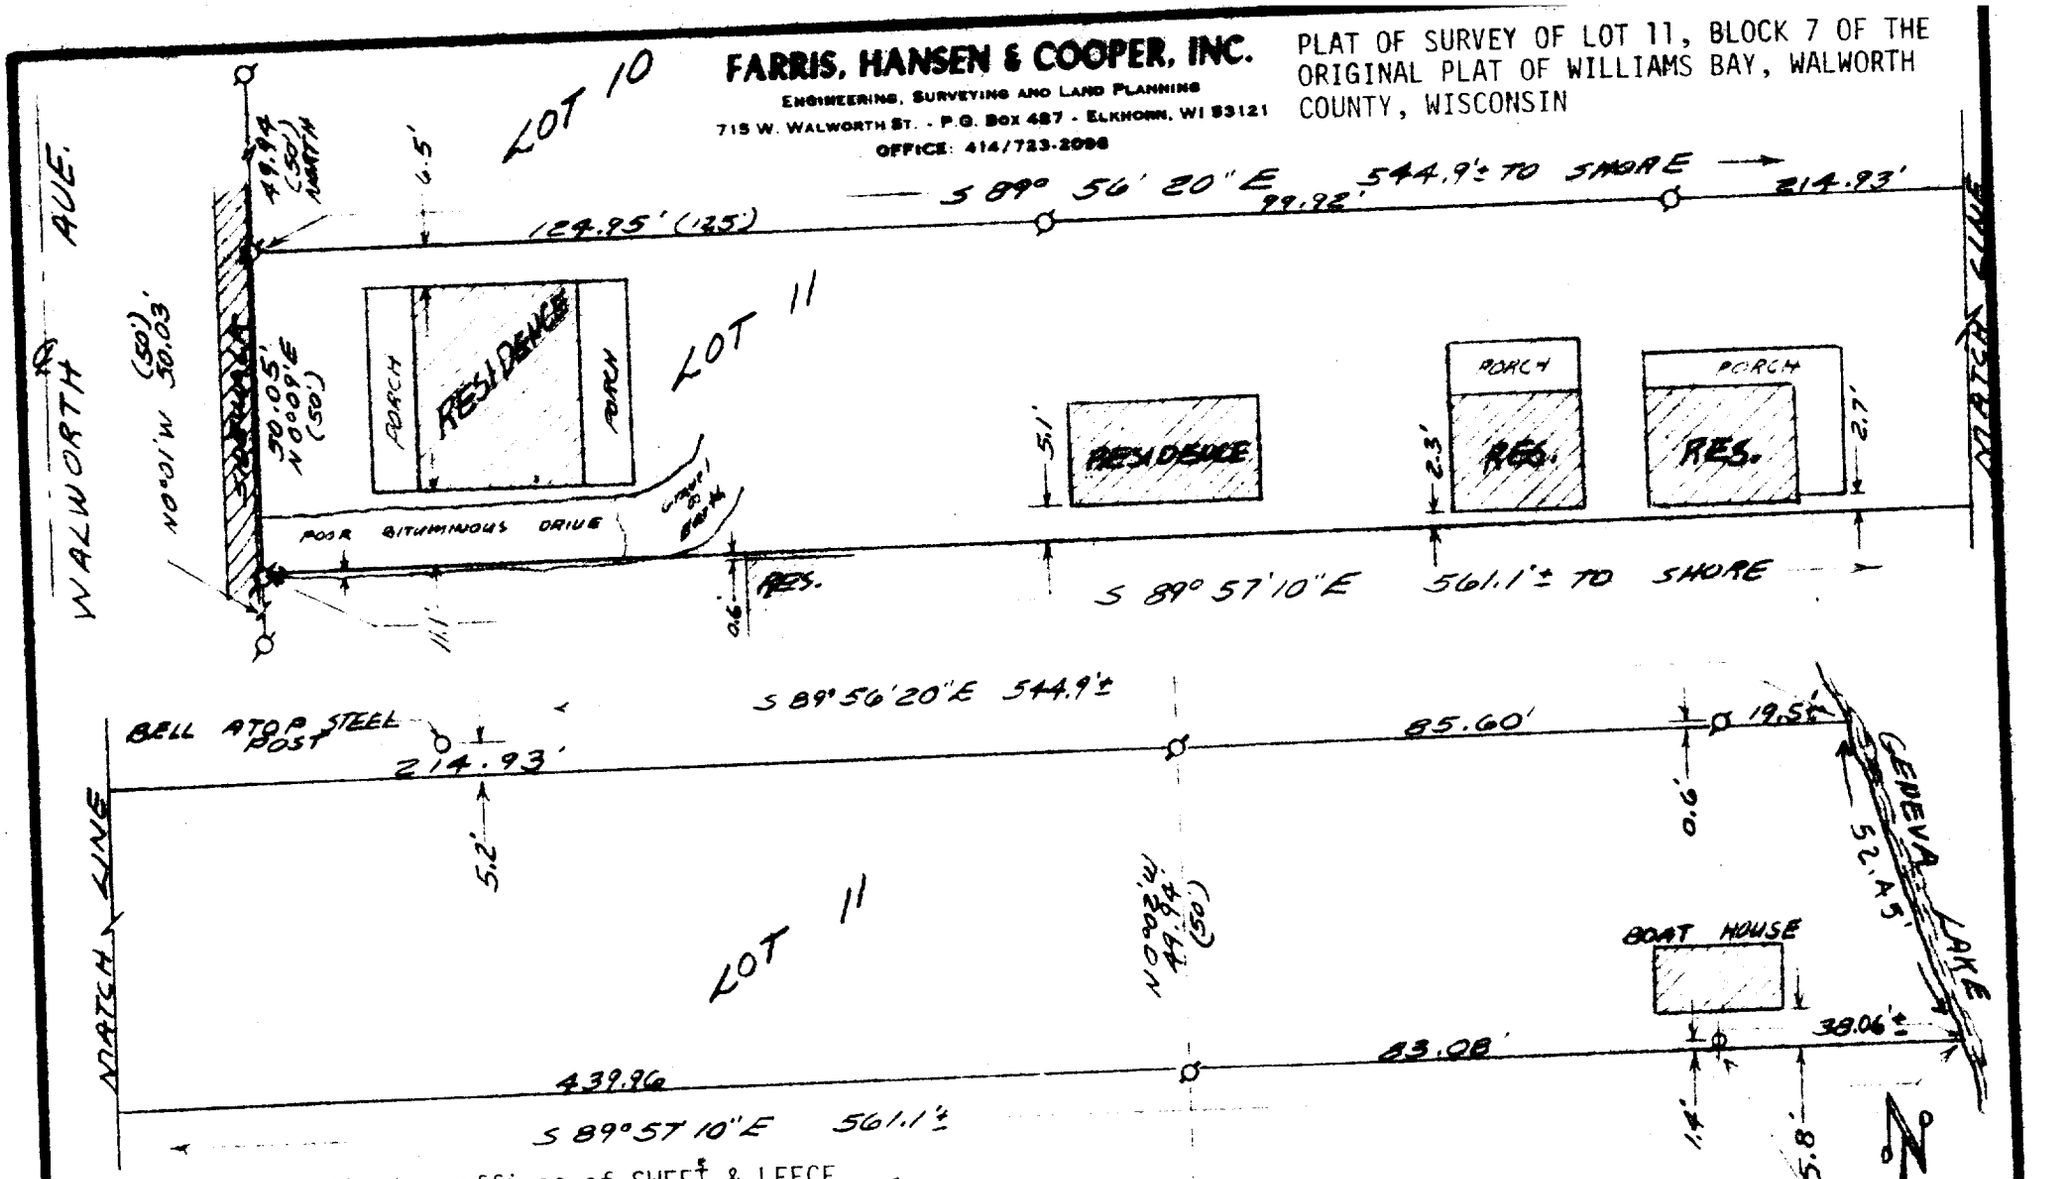

Work ordered by the Law offices of SWEET & LEECE
Elkhorn, Wisconsin for Richard W. Snidker, Jr.

WISCONSIN
ROBERT A. FARRIS
S-1293
ELKHORN, WIS
LAND SURVEYOR

I hereby certify that this Plat of Survey is a true and accurate representation of the lot lines and of the location of the structures shown to the best of my professional knowledge and belief.

Robert A. Farris

Dated this 29th day of March, 1983

(xxx) = Record Dimension
Ø = IRON PIPE STAKE FOUND

MAP SCALE 1" = 30'

DRAWING NUMBER 2074

11-429-F

OP-00094 NOTEBOOK 1303-9