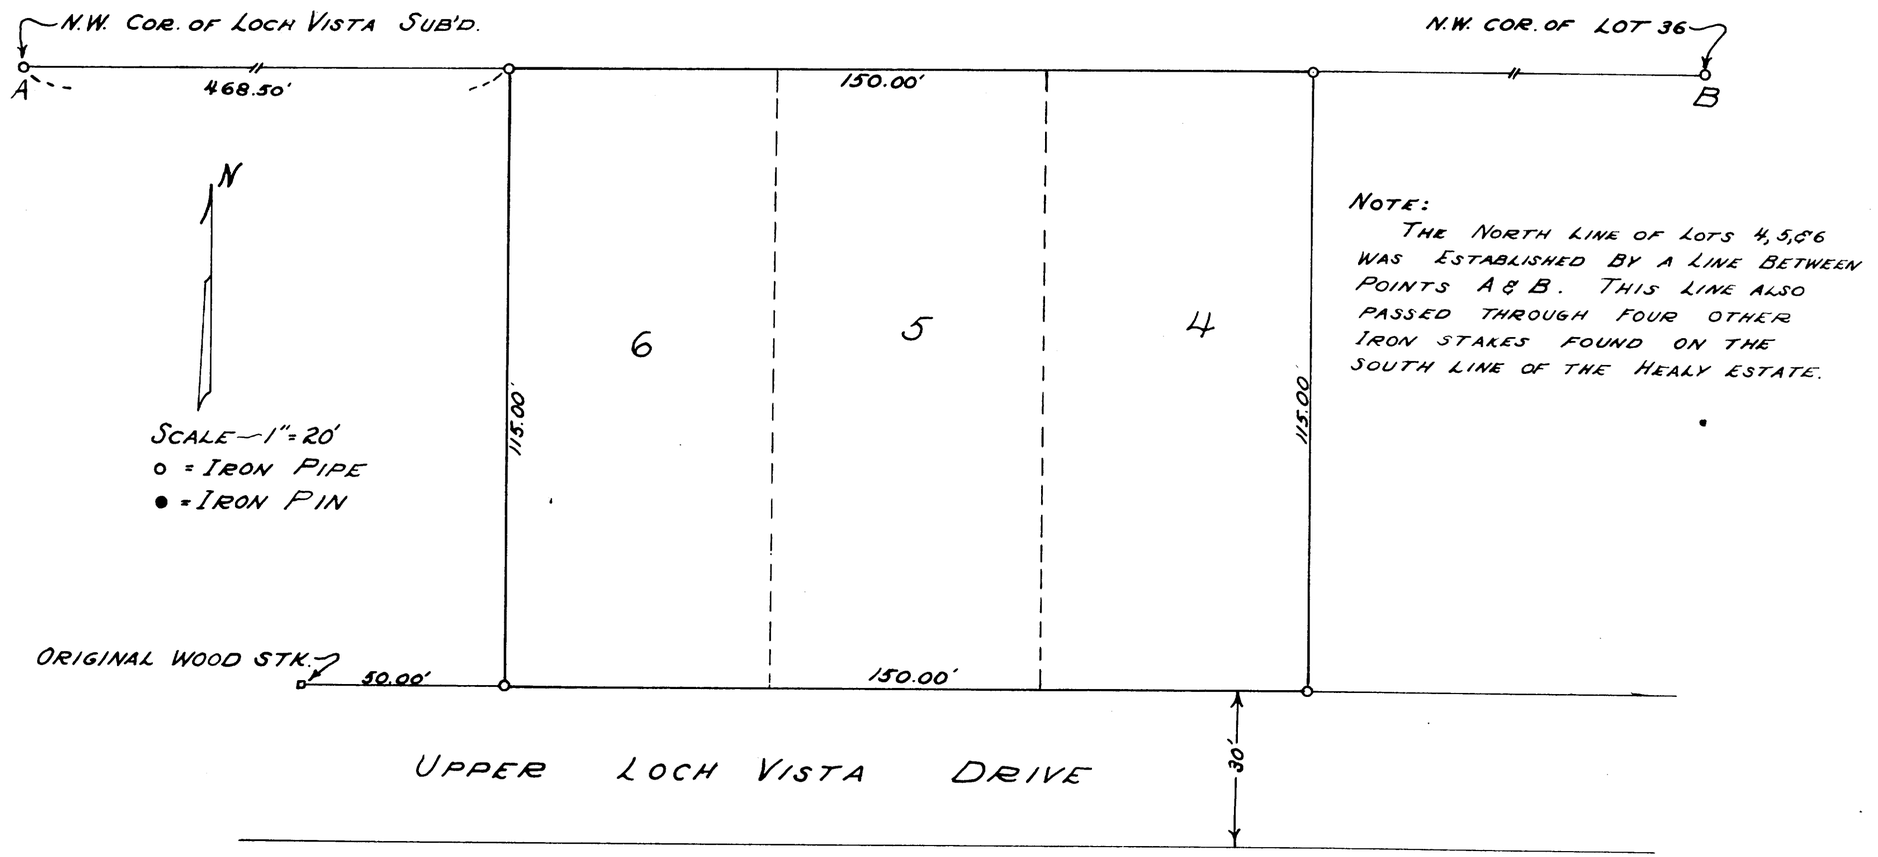


PLAT of SURVEY

LOTS 4, 5 & 6 OF LOCH VISTA SUBDIVISION No. 1, VILLAGE OF WILLIAMS BAY, WALWORTH COUNTY, WISCONSIN.

JULY, 1948

Lloyd L. Jensen
CO. SURVEYOR

11-42 J

WLW 3, 4, 5