
PLAT OF SURVEY OF LOT 48 OF CEDAR POINT PARK 1ST ADDITION
VILLAGE OF WILLIAMS BAY, WALWORTH COUNTY, WISCONSIN
FOR CRAIG CURRY

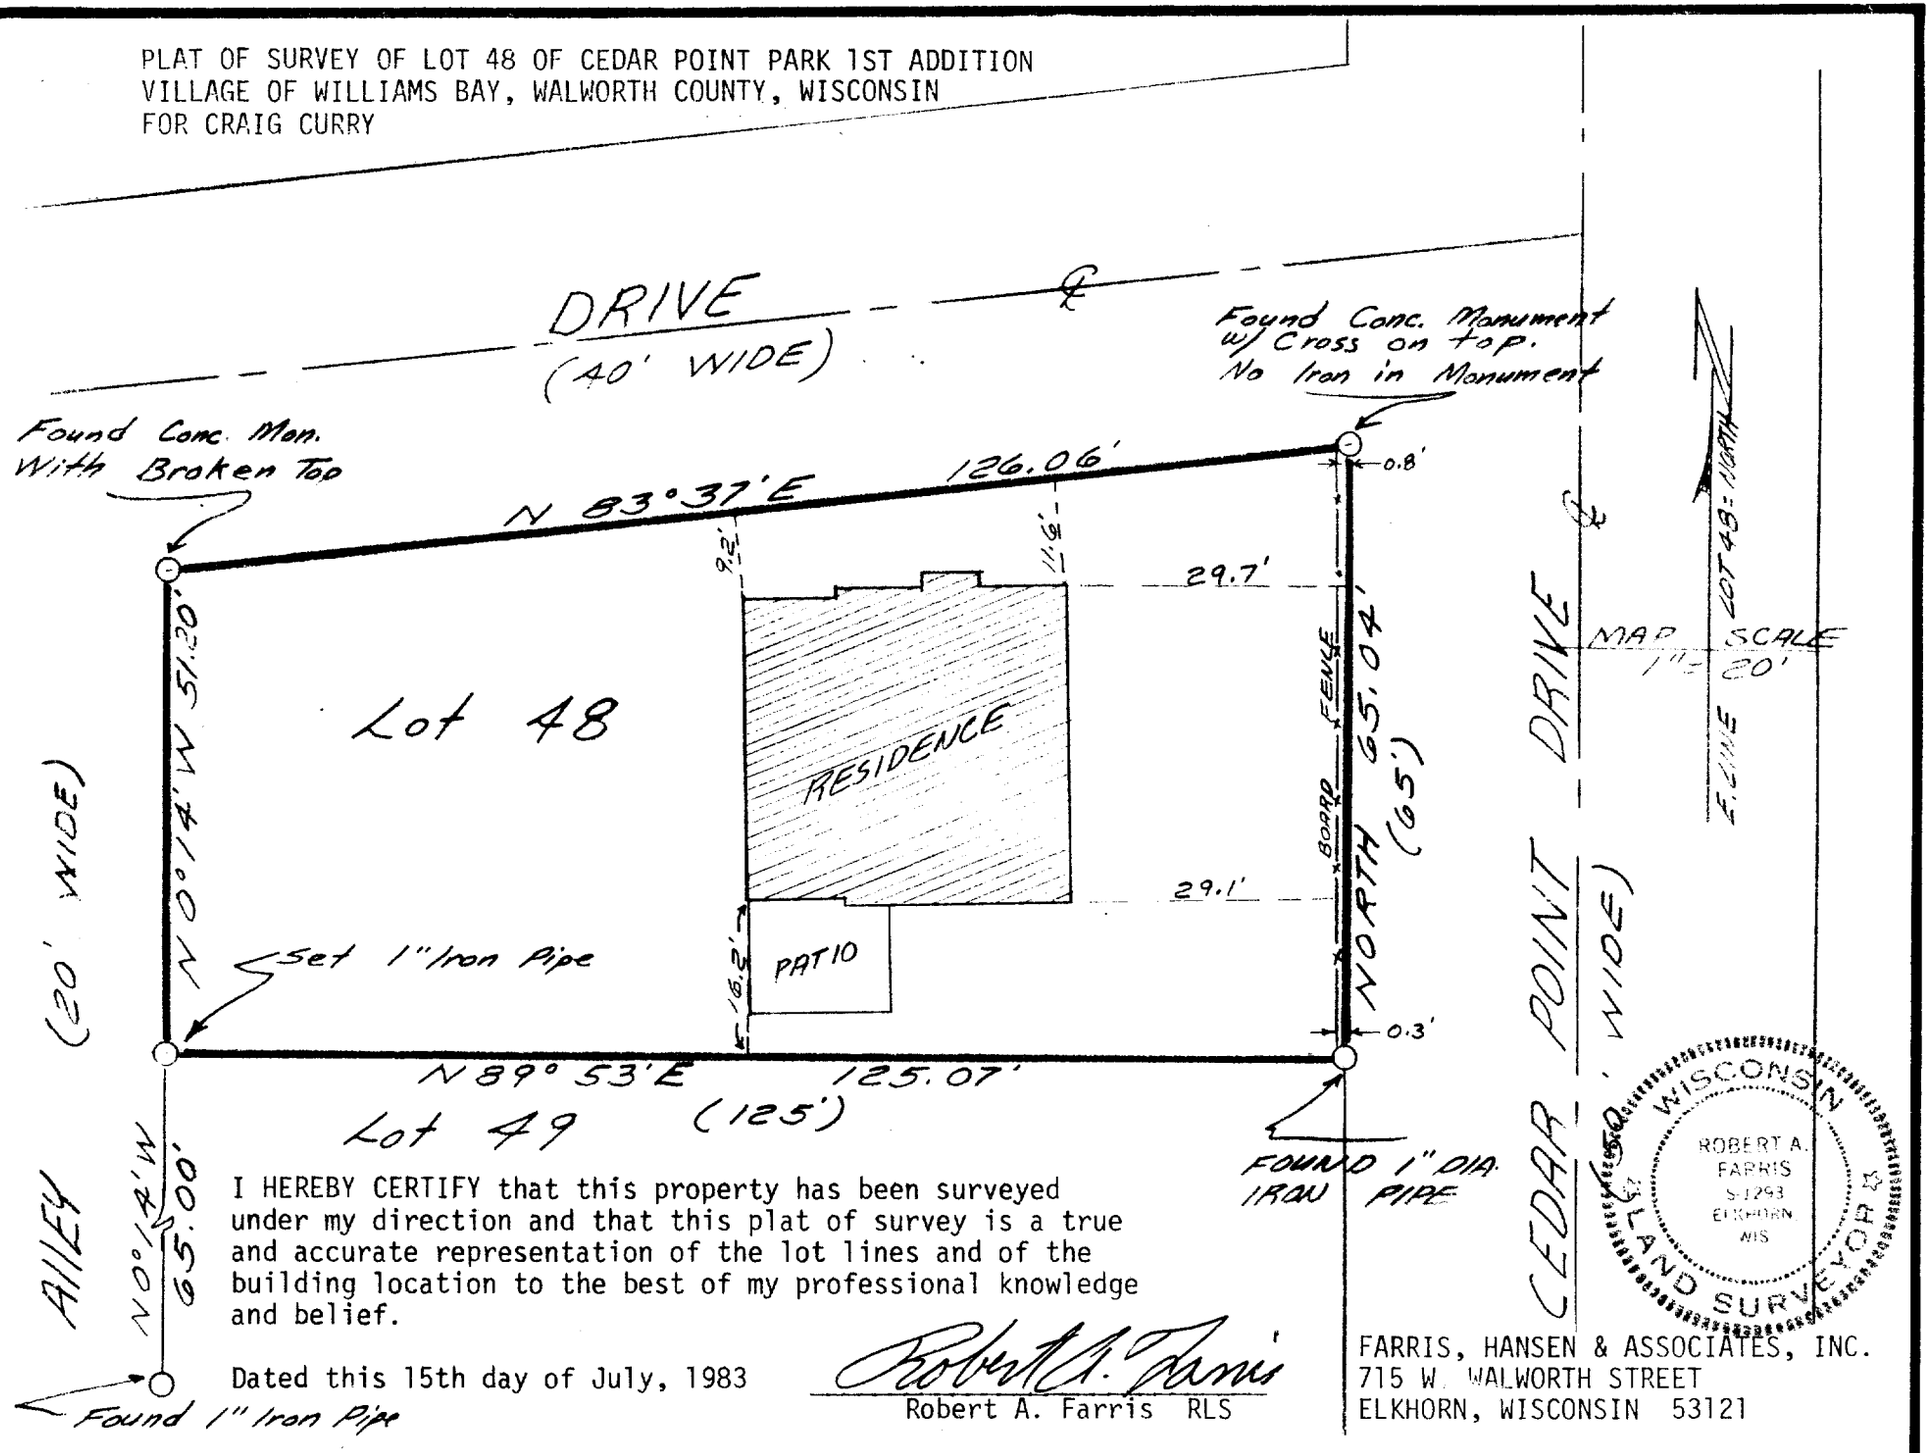

I HEREBY CERTIFY that this property has been surveyed under my direction and that this plat of survey is a true and accurate representation of the lot lines and of the building location to the best of my professional knowledge and belief.

Dated this 15th day of July, 1983

Robert A. Farris RLS

FARRIS, HANSEN & ASSOCIATES, INC.
715 W. WALWORTH STREET
ELKHORN, WISCONSIN 53121

DRAWING NUMBER 2131

WCF1-44

11-433-F