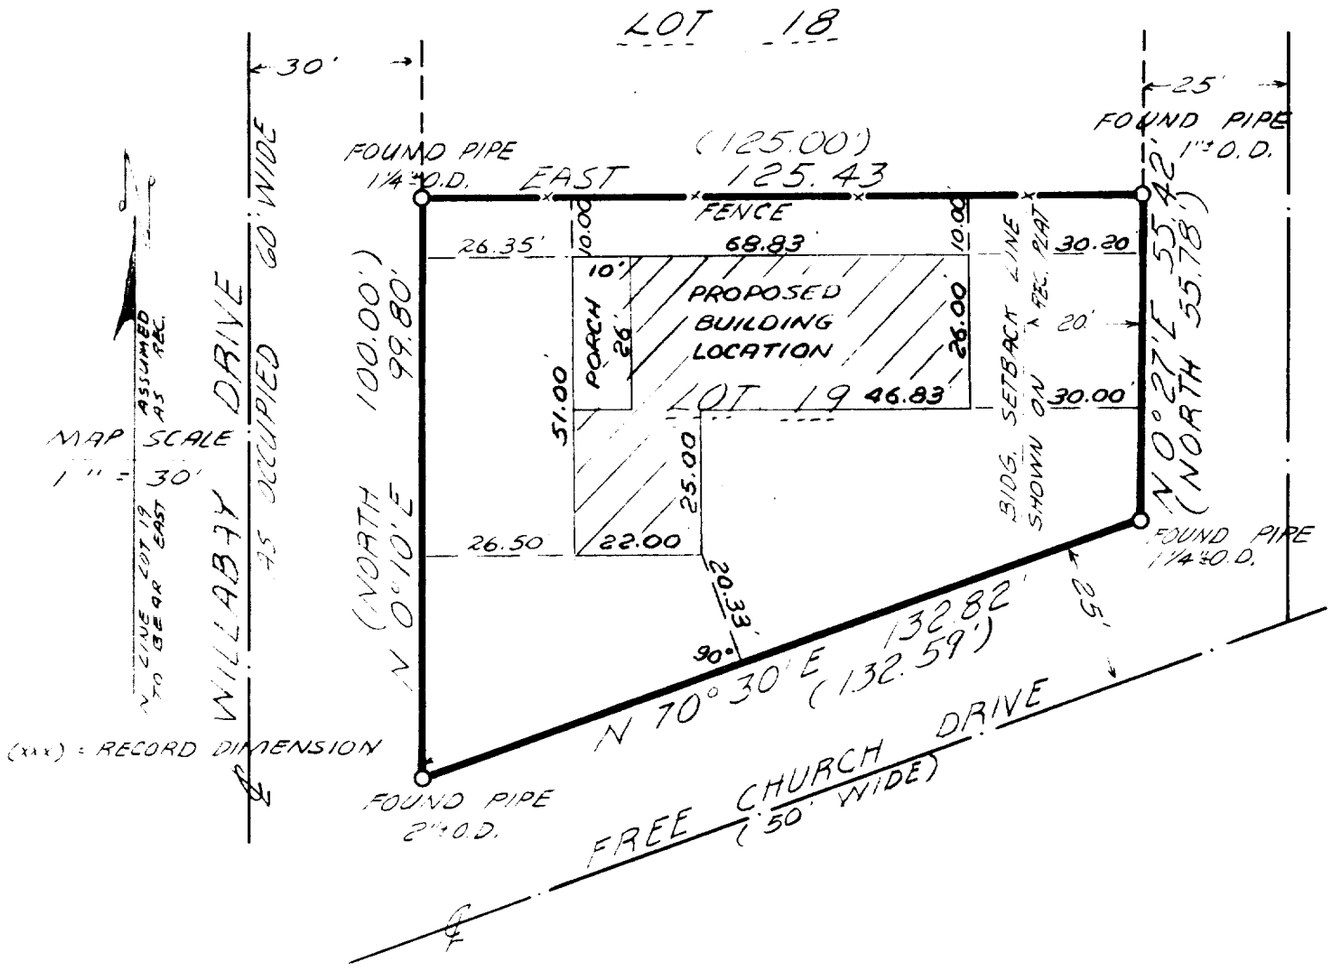


PLAT OF SURVEY OF LOT 19 OF EVANGELICAL FREE CHURCH SUBDIVISION located in the Northeast 1/4 of Section 6, Town 1 North, Range 17 East, Village of Williams Bay, Walworth County, Wisconsin.

WISCONSIN
ROBERT A. FARRIS
S-2253
ELKHORN, WIS.
LAND SURVEYOR

I hereby certify that at the direction of Glenn Roos the land described hereon was surveyed under my direction and that this Plat of Survey is a true and accurate representation of the lot lines to the best of my professional knowledge and belief.

Robert A. Farris RLS

Plat drafted and signed this 23rd day of MAY, 1983

Date of Field Work -- 12 December, 1980

PROPOSED BLDG. LOC ADDED 5/31/83

Farris, Hansen & Associates Inc.
Elkhorn, Wisconsin

Project No. 1792

11-434-F