
DUNHAM SURVEYING, S.C.
SURVEYING & SUBDIVIDING
DELAVAN, WISCONSIN 53115

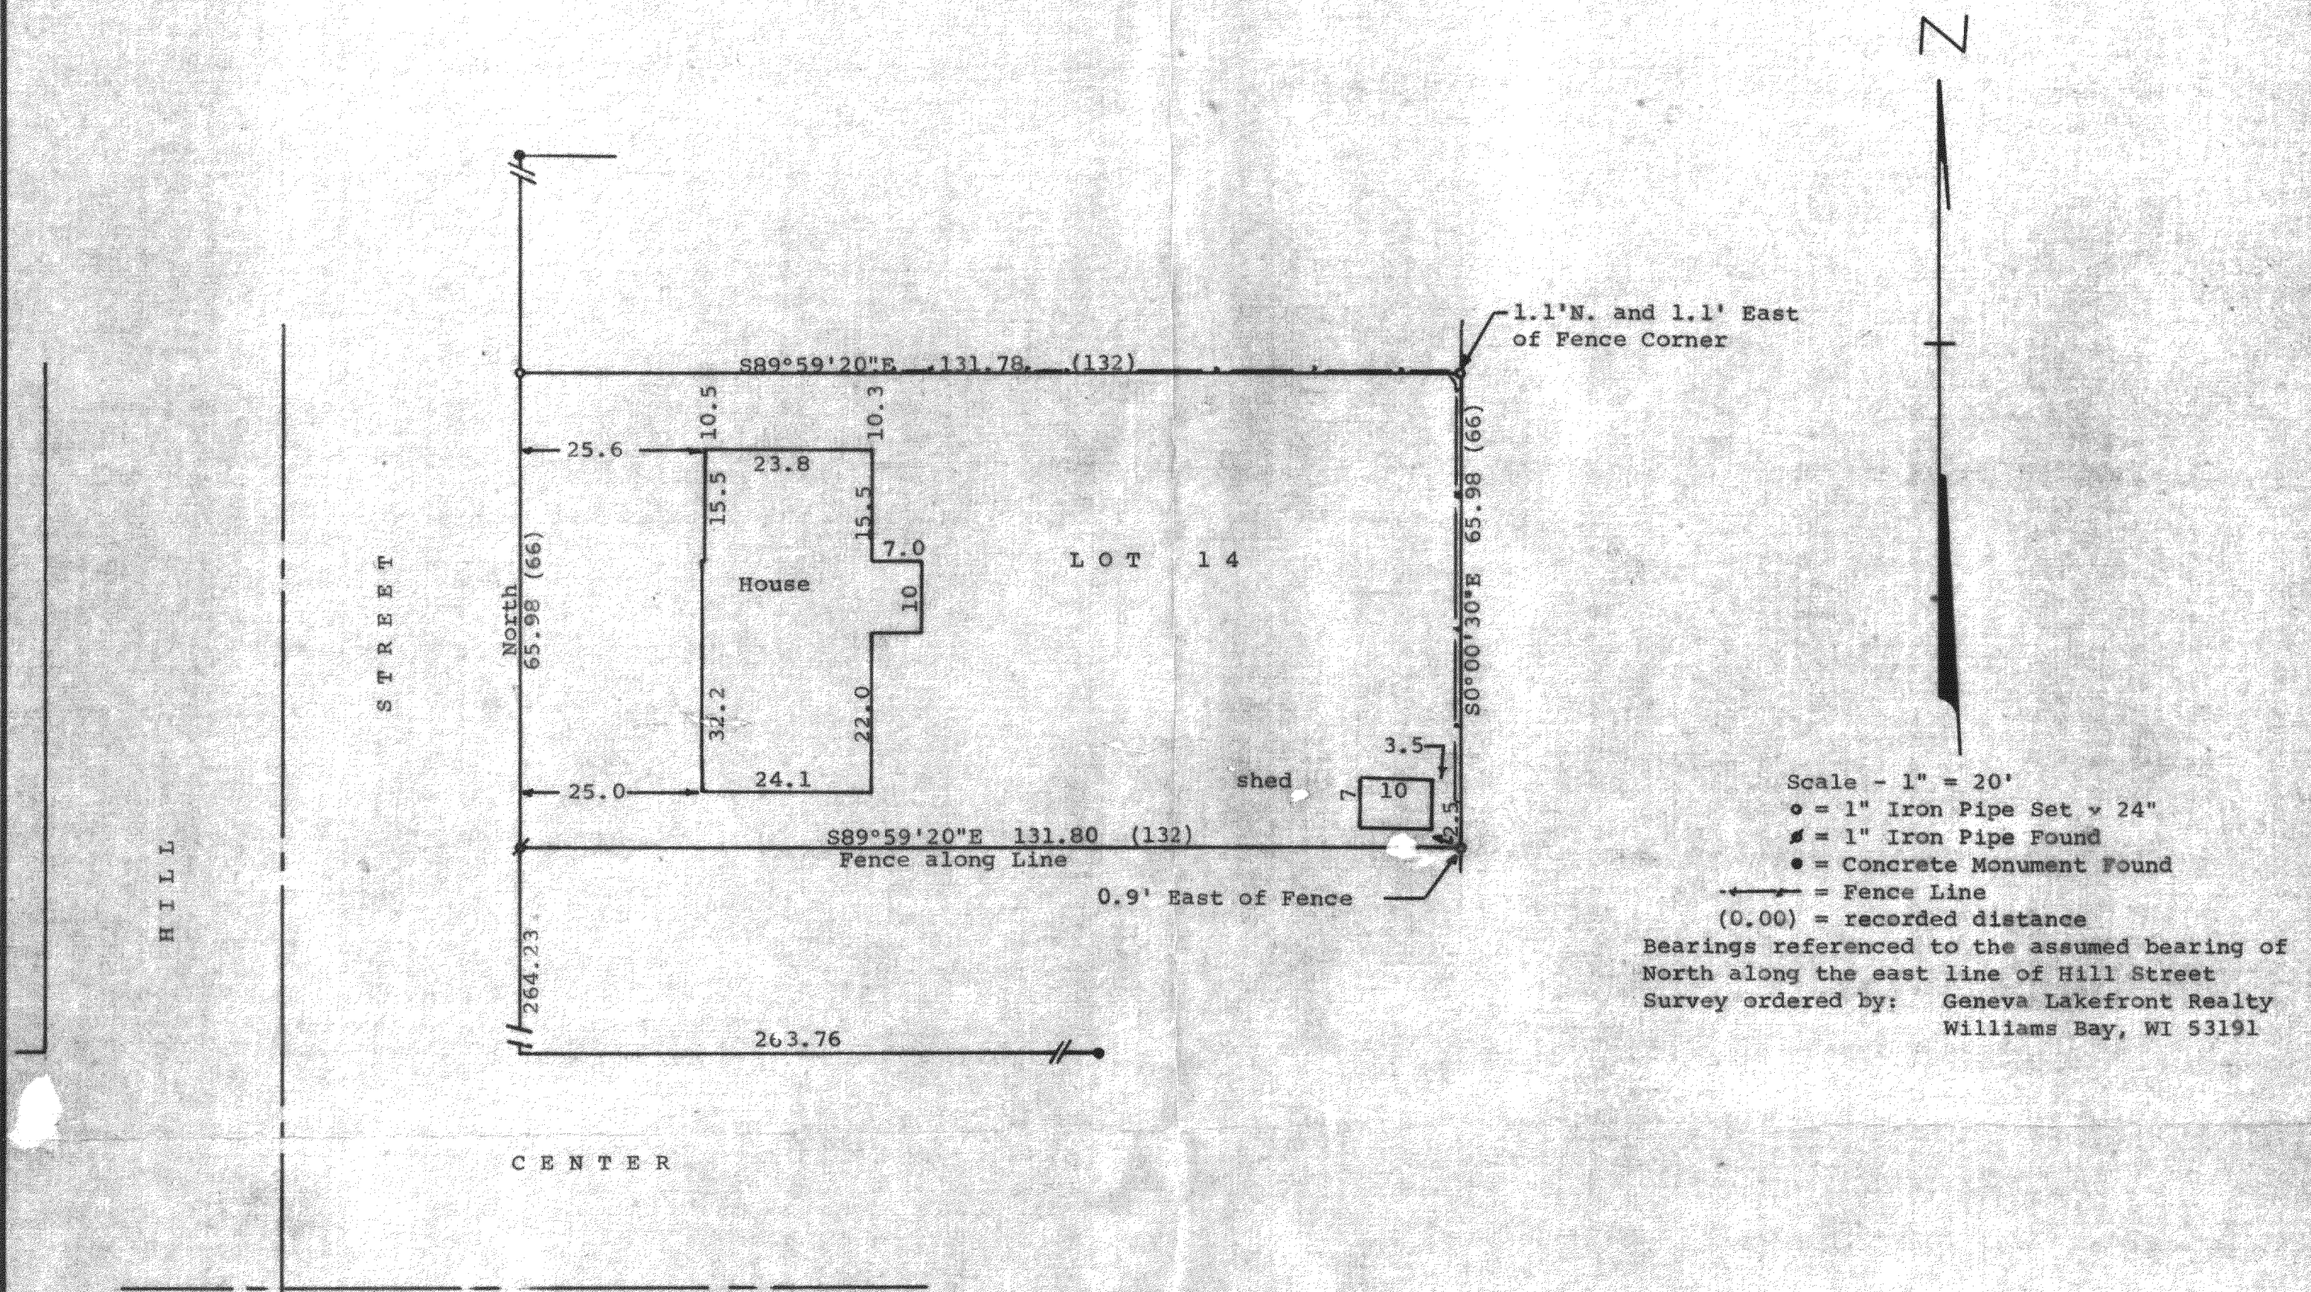

Scale - 1" = 20'
○ = 1" Iron Pipe Set ⌄ 24"
⌀ = 1" Iron Pipe Found
● = Concrete Monument Found
·+·+· = Fence Line
(0.00) = recorded distance
Bearings referenced to the assumed bearing of North along the east line of Hill Street
Survey ordered by: Geneva Lakefront Realty
Williams Bay, WI 53191

STATE OF WISCONSIN)
COUNTY OF WALWORTH) SS

I, George T. Dunham, Surveyor, certify that I have surveyed the property described as follows:

Lot numbered Fourteen (14) in Block numbered Thirteen (13) of Williams Second Addition to the Village of Williams Bay, Walworth County, Wisconsin,

and that the map shown above is a true representation thereof and shows the size and location of the property, its exterior boundaries, the location of all visible structures and dimensions of all principal buildings thereon, boundary fences, apparent easements, roadways, and visible encroachments, if any, and that I have surveyed the property hereon described according to the official records to the best of my knowledge and belief.

December 26, 1983

George T. Dunham
George T. Dunham, Surveyor

WISCONSIN
GEORGE T. DUNHAM
DELAVAN, WIS.
S-306
LAND SURVEYOR

WOP-D0197

11-435-D

K & E 10-9159