


DUNHAM SURVEYING, S. C.
SURVEYING & SUBDIVIDING
DELAVER, WISCONSIN 53115

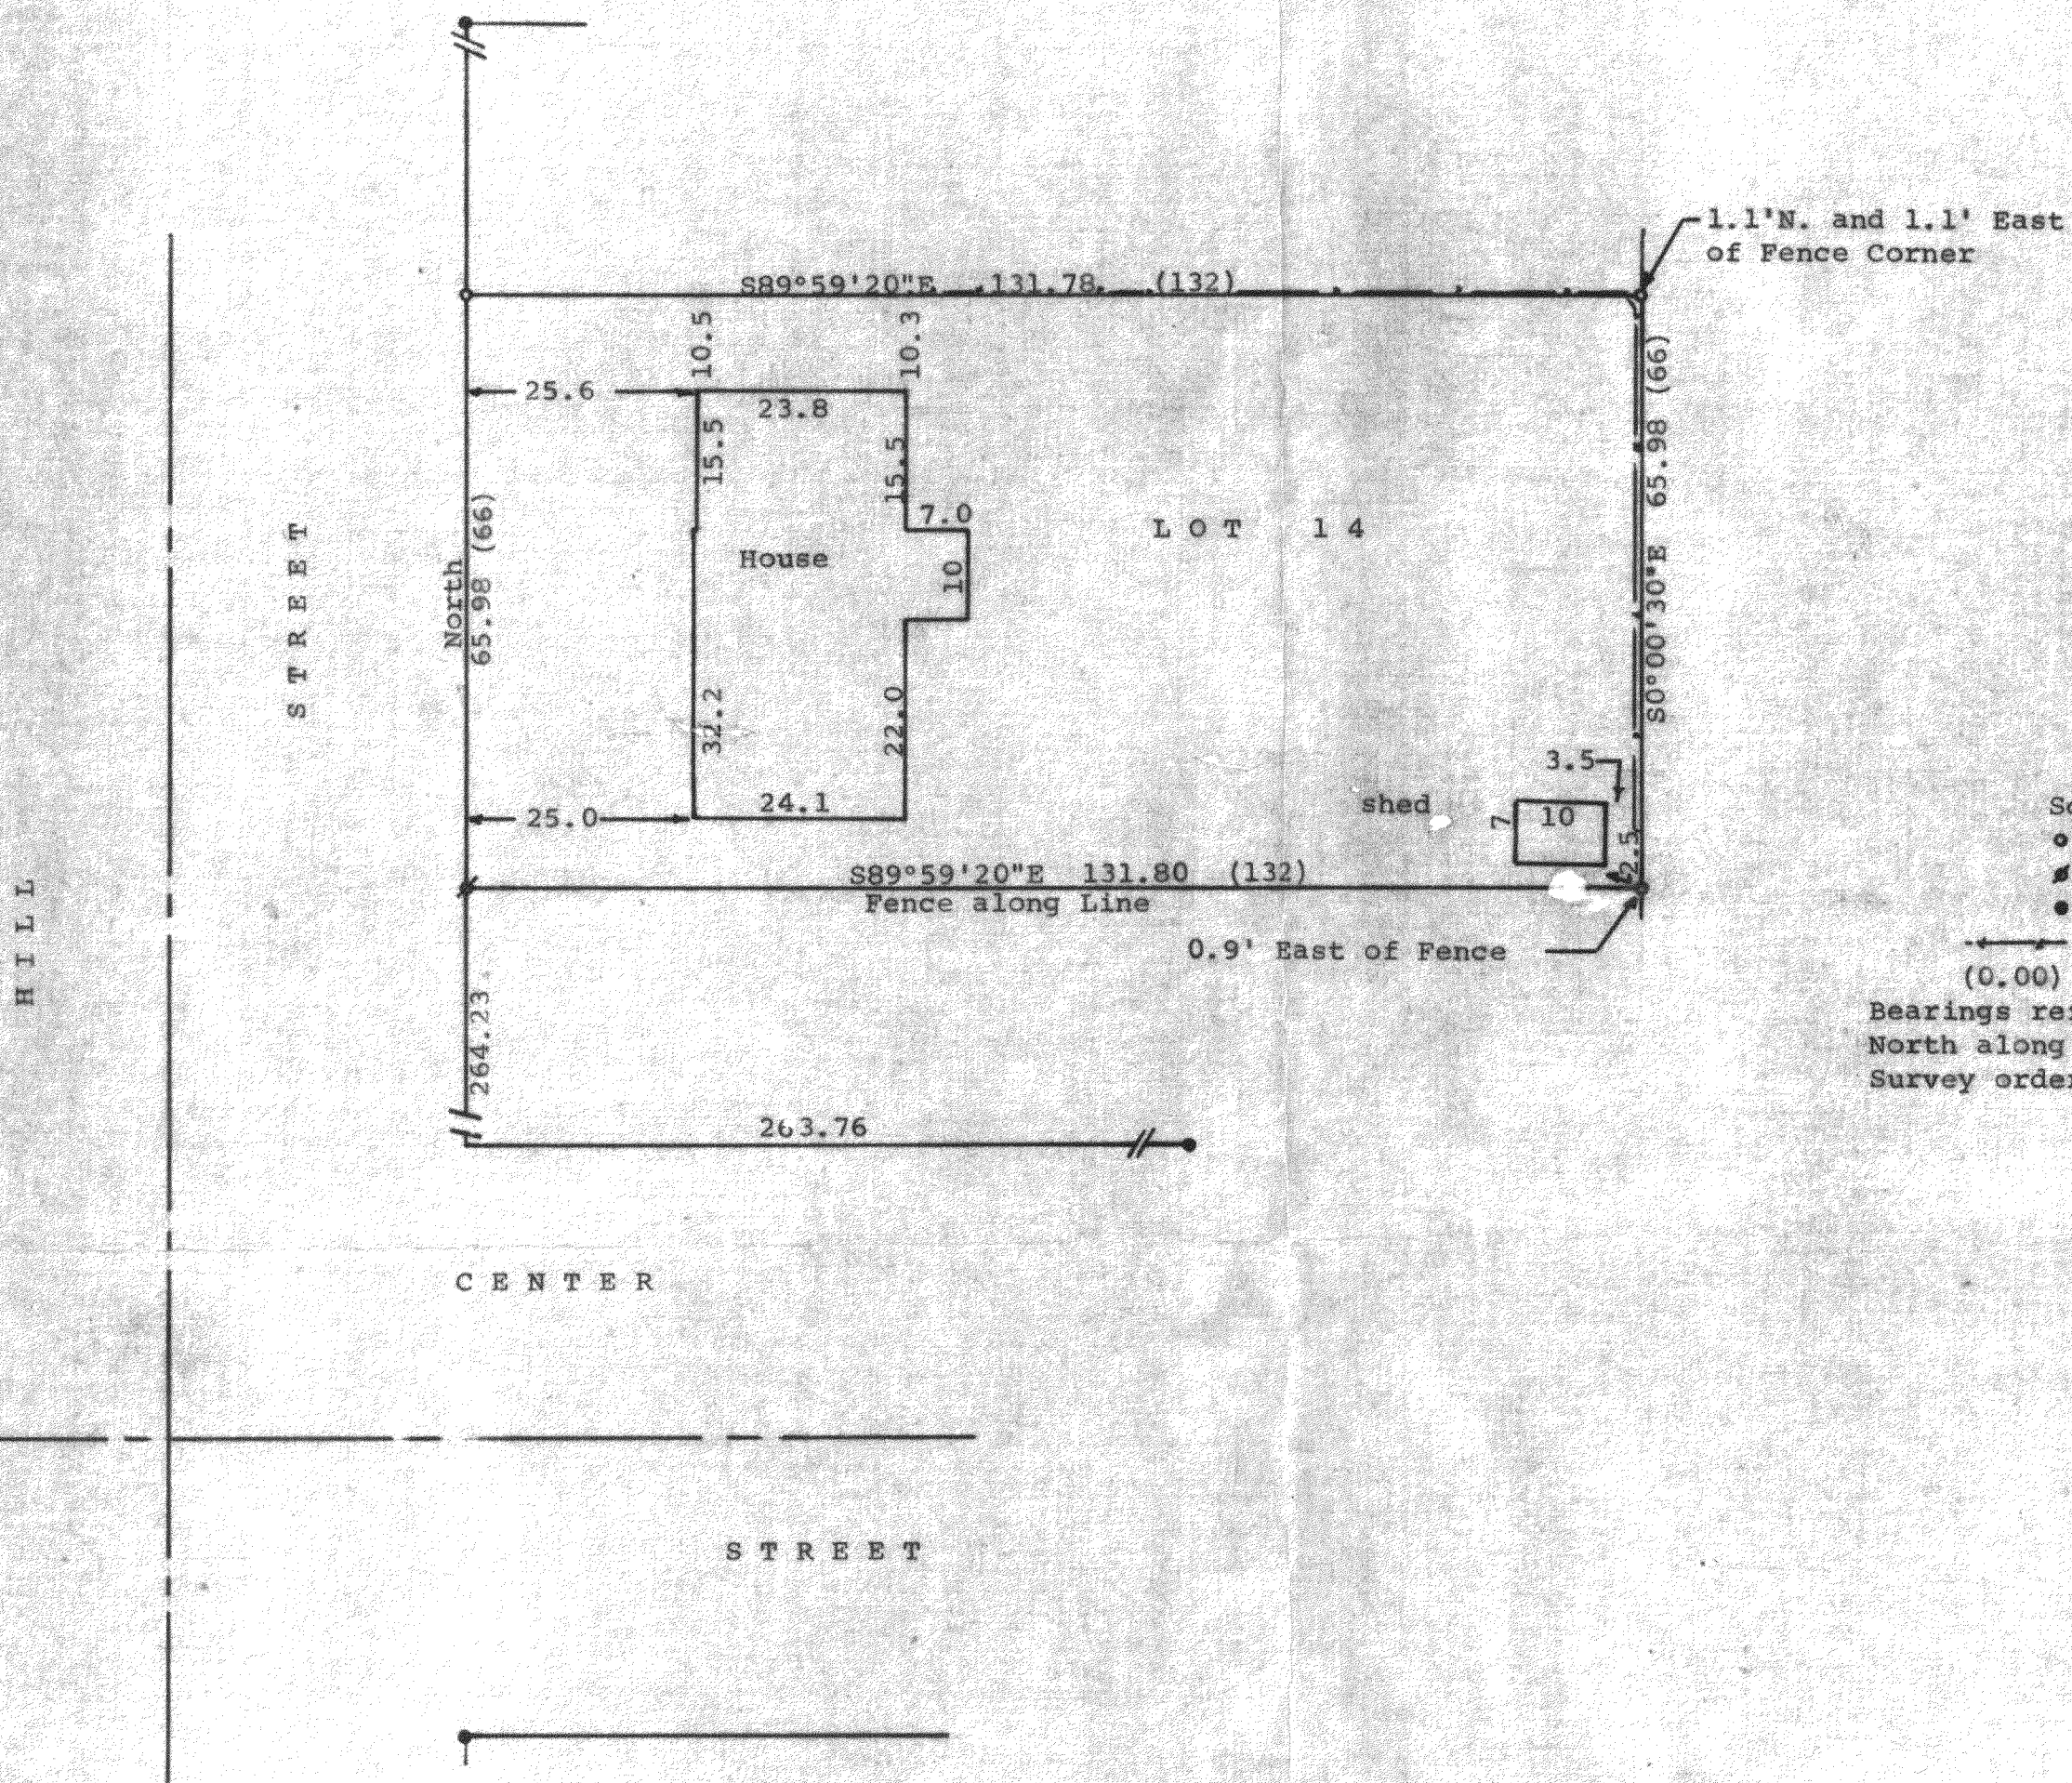

Scale - 1" = 20'
 ○ = 1" Iron Pipe Set x 24"
 ● = 1" Iron Pipe Found
 ● = Concrete Monument Found
 --- = Fence Line
 (0.00) = recorded distance

Bearings referenced to the assumed bearing of
 North along the east line of Hill Street
 Survey ordered by: Geneva Lakefront Realty
 Williams Bay, WI 53191



STATE OF WISCONSIN) SS
 COUNTY OF WALWORTH)

I, George T. Dunham, Surveyor, certify that I have surveyed the
 property described as follows:

Lot numbered Fourteen (14) in Block numbered Thirteen (13) of
 Williams Second Addition to the Village of Williams Bay, Walworth
 County, Wisconsin,

and that the map shown above is a true representation thereof and shows the
 size and location of the property, its exterior boundaries, the location of all
 visible structures and dimensions of all principal buildings thereon, boundary
 fences, apparent easements, roadways, and visible encroachments, if any, and
 that I have surveyed the property hereon described according to the official
 records to the best of my knowledge and belief.

December 26, 1983

George T. Dunham
 George T. Dunham, Surveyor

