
PLAT OF SURVEY
LOT 21 WILLABAY WOODS
VILLAGE OF WILLIAMS BAY
WALWORTH CO. WI.

(XXX) RECORD DIMENSION
O = IRON PIPE SURVEY
STAKE FOUND.

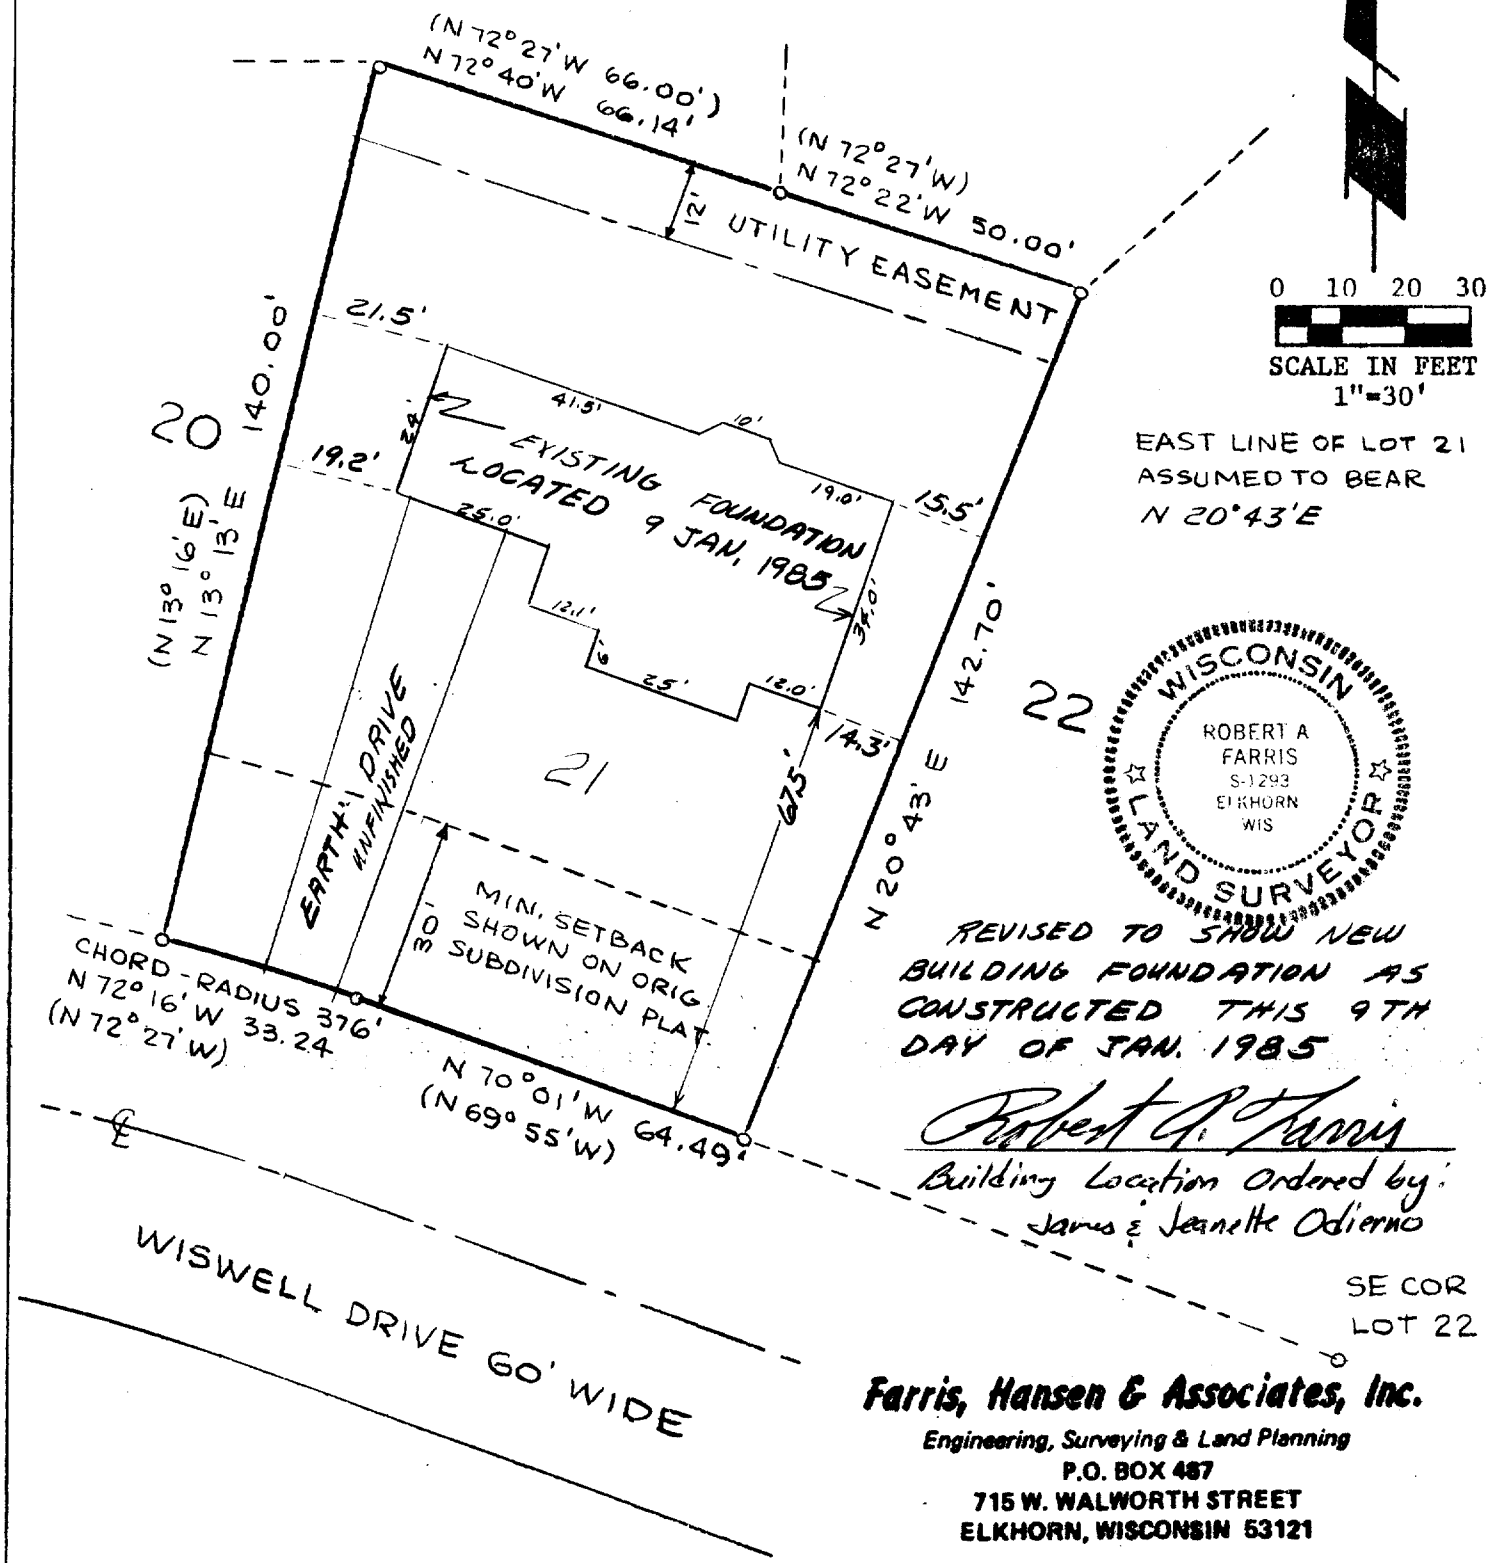

REVISED TO SHOW NEW BUILDING FOUNDATION AS CONSTRUCTED THIS 9TH DAY OF JAN. 1985

Robert A. Farris

Building Location Ordered by:
James & Jeanette Odierno

SE COR
LOT 22

Farris, Hansen & Associates, Inc.
Engineering, Surveying & Land Planning
P.O. BOX 487
715 W. WALWORTH STREET
ELKHORN, WISCONSIN 53121

I HEREBY CERTIFY THAT THIS PLAT IS A TRUE AND ACCURATE REPRESENTATION OF THE BOUNDRY LINES TO THE BEST OF MY KNOWLEDGE & BELIEF.

Robert A. Farris

ROBERT A. FARRIS

SURVEY ORDERED BY MRS. ELSIE LINKA FOR MR. ROBERT LINKA.

DATED 17 OCTOBER 1984
REVISED 9 JANUARY 1985

PROJECT NO. 2323

1 of 5 F