RECEIVED
OCT 3 0 1985

2461

FARRIS, HANSEN & ASSOCIATES, INC.

ENGINEERING, SURVEYING & LAND PLANNING

700 E. GRAINGER ST. - BOX 427 - ELKHORN, WI.

PHONE: 414-723-2068

LOT 11, WILLABAY WOODS


VILLAGE OF WILLIAMS BAY, WALWORTH COUNTY
WISCONSIN

I hereby certify that I have surveyed the above described property and that the above map is a true representation thereof and shows the size and location of the property, its exterior boundaries, the location of all visible structures and dimensions of all principal buildings thereon, boundary fences, apparent easements, roadways and visible encroachments, if any.
This survey is made for the use of the present owners of the property, and also those who purchase, mortgage, or guarantee the title thereto within one (1) year from the date hereof.

Robert A. Farris

WISCONSIN ROBERT A. FARRIS S-1201 ELKHORN WIS LAND SURVEYOR

RE-SURVEYED AND RE-CERTIFIED
THIS 6TH DAY OF SEPT., 1985.

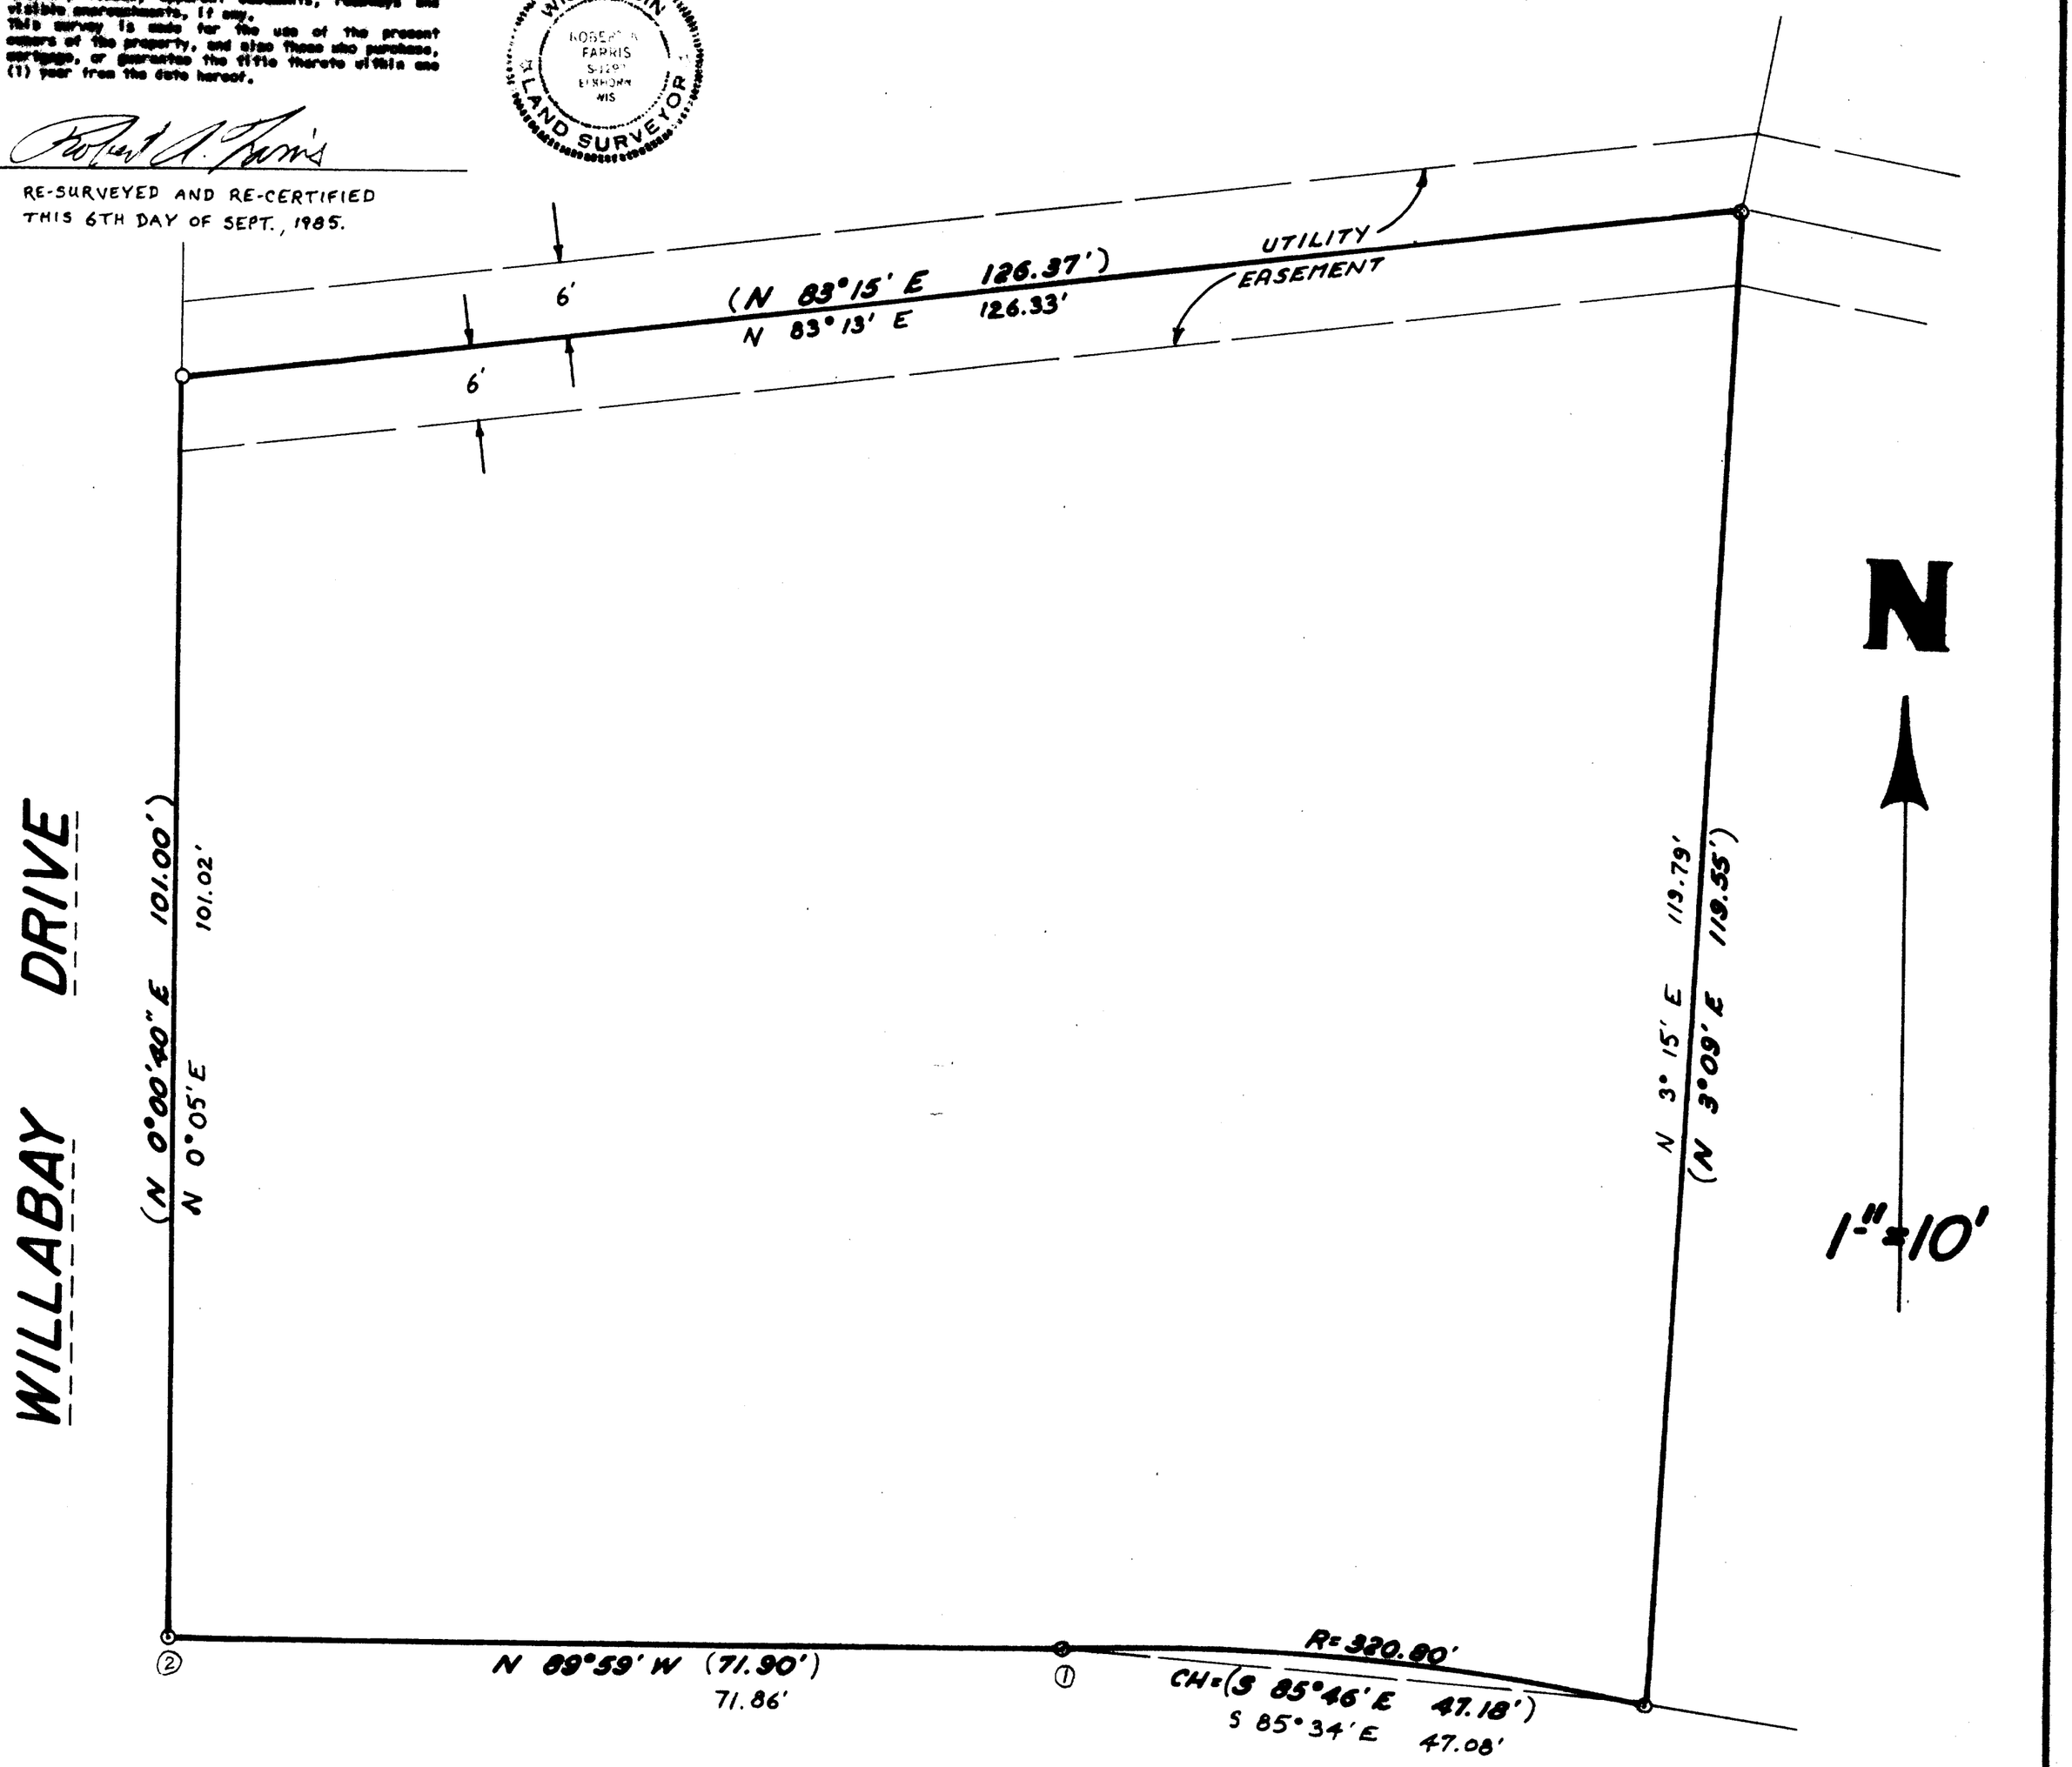

NOTE: LINE ①-② N 89° 59' W AS SHOWN ON THE SUBDIVISION PLAT OF WILLABAY WOODS.

PLAT OF SURVEY OF

LOT 11, WILLABAY WOODS, A SUBDIVISION LOCATED IN THE NORTHEAST 1/4 OF SECTION 6, TOWN 1 NORTH, RANGE 17 EAST, VILLAGE OF WILLIAMS BAY, WALWORTH COUNTY, WIS.

WORK ORDERED BY: MIDWEST REALTY

⊙—— 2" DIA. IRON PIPE FOUND
○—— 1" DIA. IRON PIPE FOUND

WISCONSIN ROBERT A. FARRIS S-1201 ELKHORN WIS LAND SURVEYOR

I HEREBY CERTIFY THAT THIS PLAT IS A TRUE AND ACCURATE REPRESENTATION OF THE LOT LINES TO THE BEST OF MY PROFESSIONAL KNOWLEDGE AND BELIEF.

Robert A. Farris — 26 Nov. 1982
ROBERT A. FARRIS, RLS — DATE

PROJECT NO. 2461

11-459-5