FARRIS, HANSEN & ASSOCIATES, INC.

ENGINEERING, SURVEYING & LAND PLANNING

7 RIDGEWAY COURT - BOX 487 - ELKHORN, WI.

RECEIVED
OCT 30 1985
W.S.

LOT 60, WILLABAY WOODS


VILLAGE OF WILLIAMS BAY, WALWORTH COUNTY

WISCONSIN

I HEREBY CERTIFY THAT I HAVE SURVEYED THE ABOVE DESCRIBED PROPERTY AND THAT THE ABOVE MAP IS A TRUE REPRESENTATION THEREOF AND SHOWS THE SIZE AND LOCATION OF THE PROPERTY, ITS EXTERIOR BOUNDARIES, THE LOCATION OF ALL VISIBLE STRUCTURES AND DIMENSIONS OF ALL PRINCIPAL BUILDINGS THEREON, BOUNDARY FENCES, APPARENT EASEMENTS, ROADWAYS AND VISIBLE ENCROACHMENTS, IF ANY.
THIS SURVEY IS MADE FOR THE USE OF THE PRESENT OWNERS OF THE PROPERTY, AND ALSO THOSE WHO PRUCHASE, MORTGAGE, OR GUARANTEE THE TITLE THERETO WITHIN ONE (1) YEAR FROM THE DATE HEREON.

Robert A. Farris

ROBERT A. FARRIS, R.L.S.
re-surveyed and re-certified
DATED THIS 25 DAY OF SEPTEMBER, 1985.

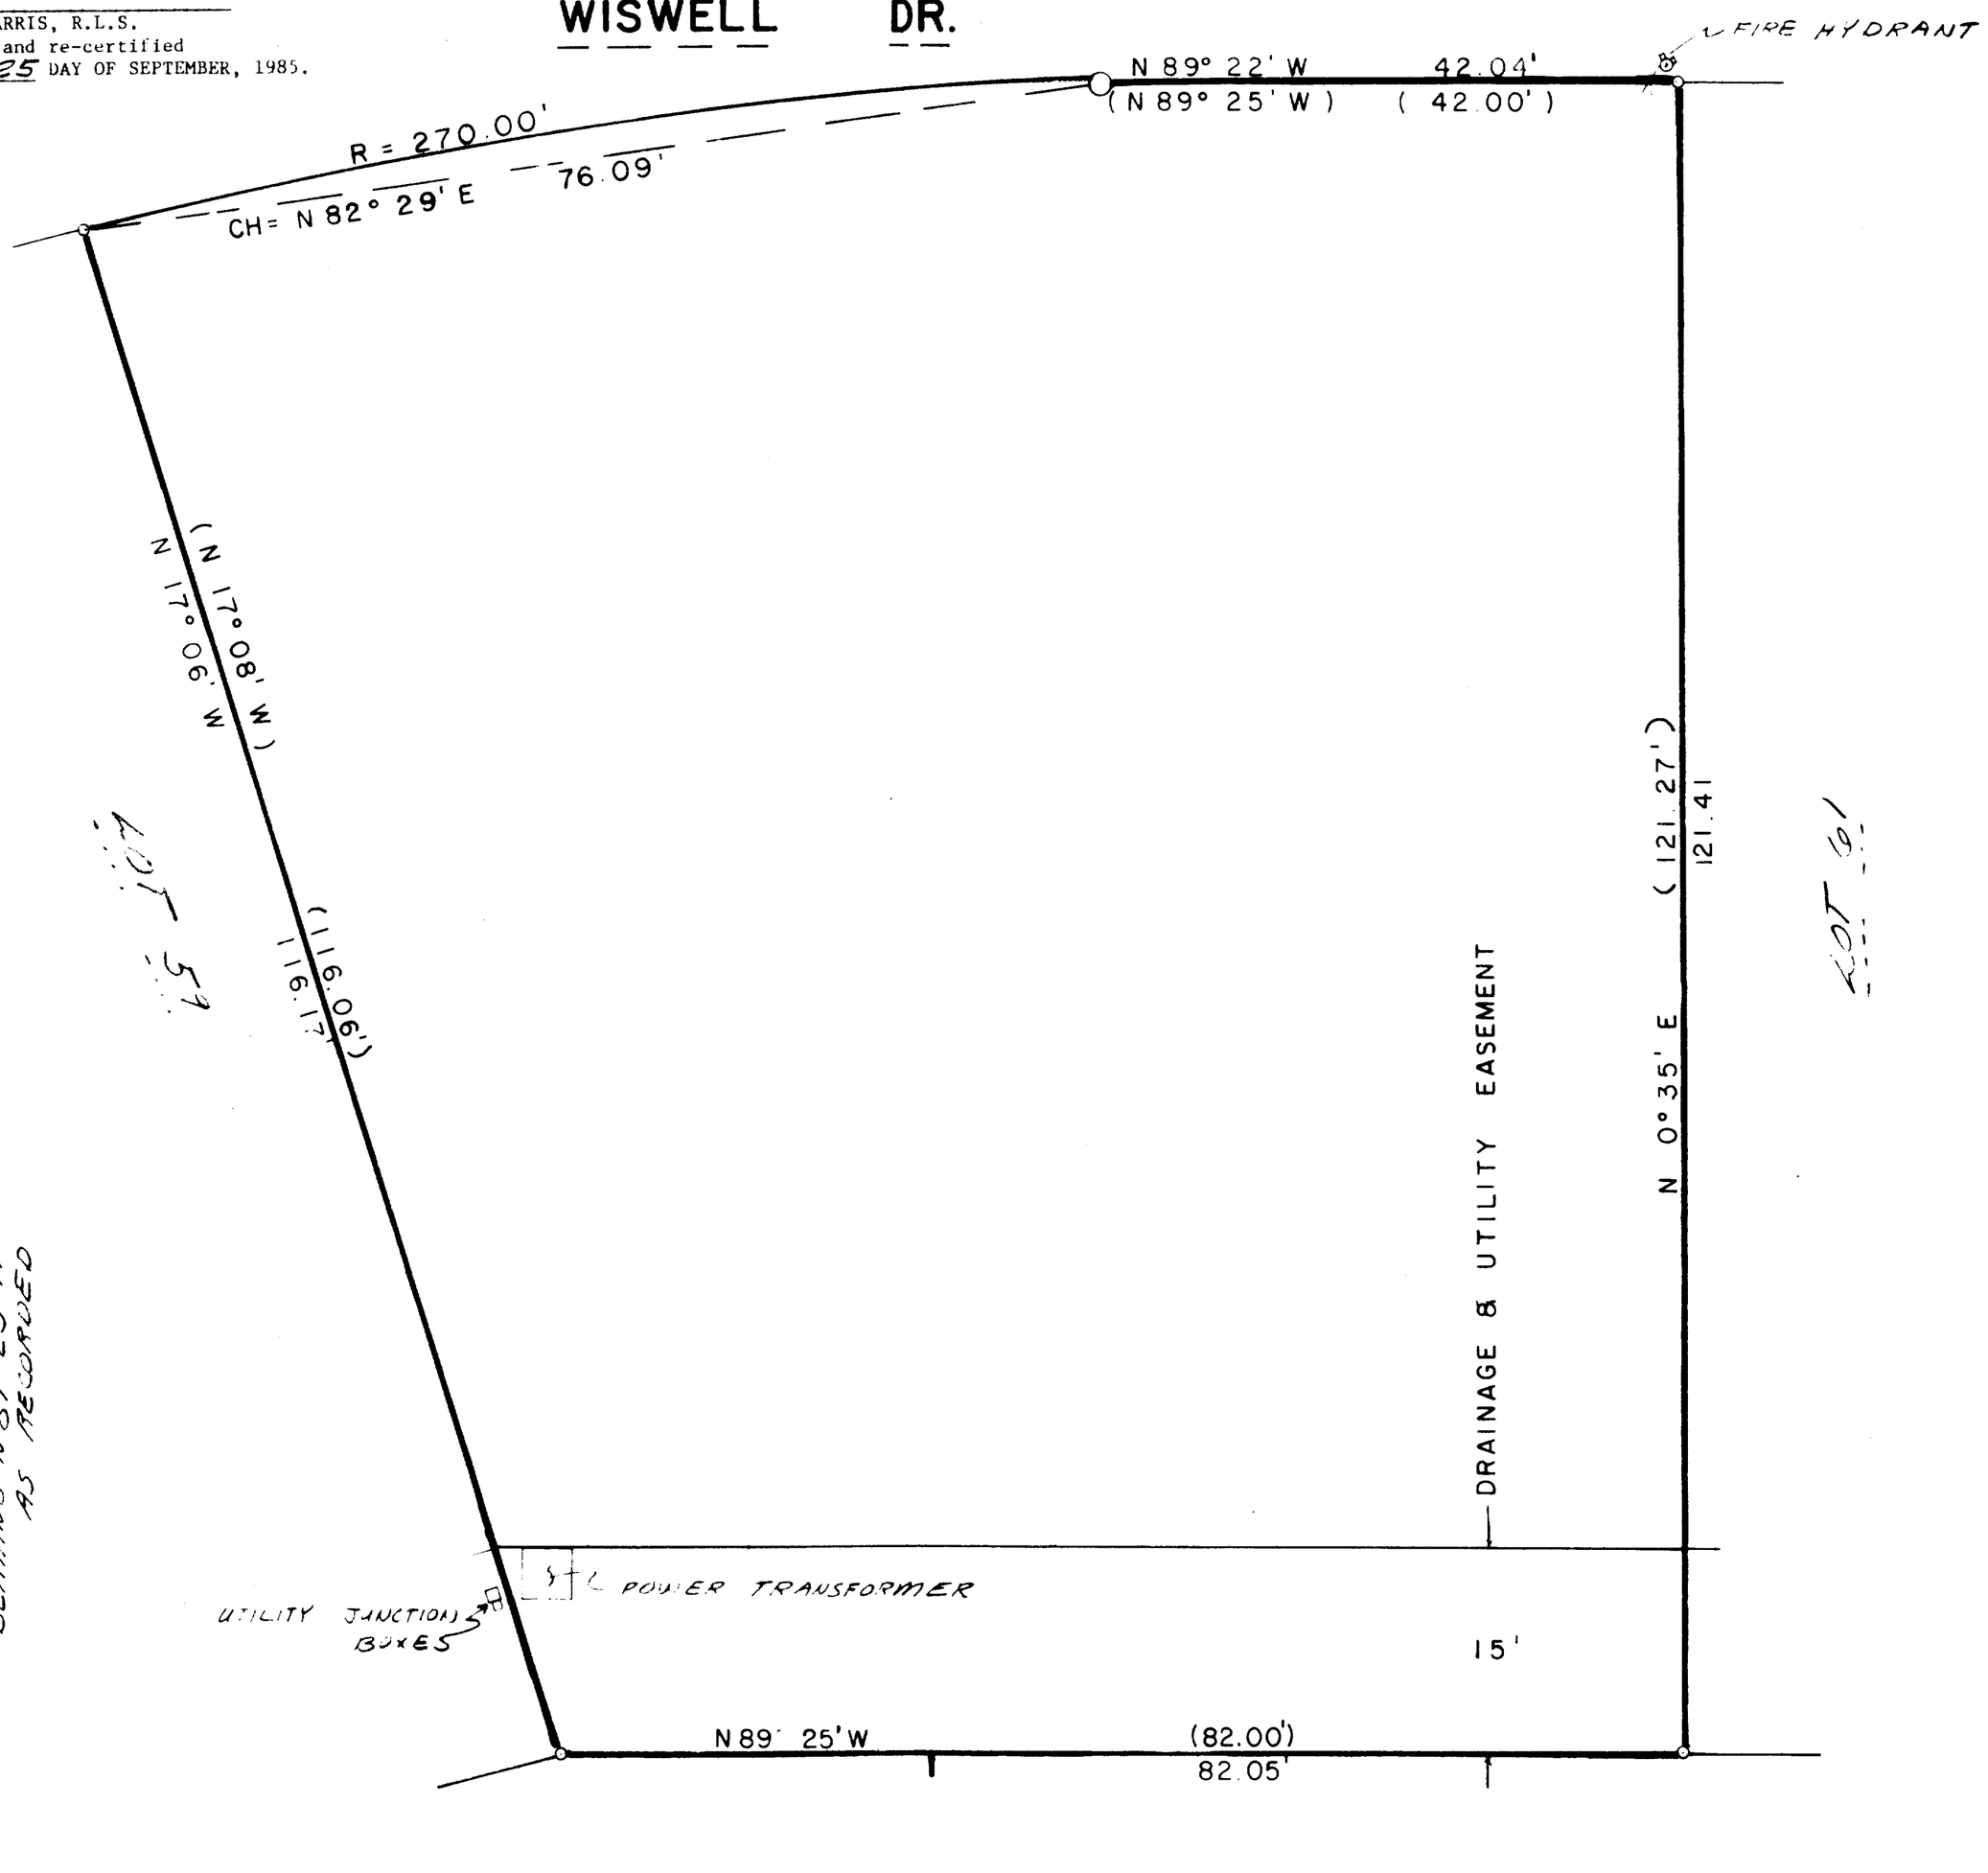

○ ----2" Dia. Iron Pipe Found
o ----1" Dia. Iron Pipe Found

WORK ORDERED BY: MIDWEST REALTY

WISCONSIN
ROBERT A FARRIS
S-1290
ELKHORN WIS
LAND SURVEYOR

PLAT OF SURVEY

LOT 60, WILLABAY WOODS, A SUBDIVISION LOCATED IN THE NORTHEAST 1/4 OF SECTION 6, TOWN 1 NORTH, RANGE 17 EAST, VILLAGE OF WILLIAMS BAY, WALWORTH COUNTY, WISC.

PROJECT NO. 2475

11-454-F