
RECEIVED
AUG 19 1986

DUNHAM SURVEYING, S.C.

SURVEYING & SUBDIVIDING
DELAVAN, WISCONSIN 53115

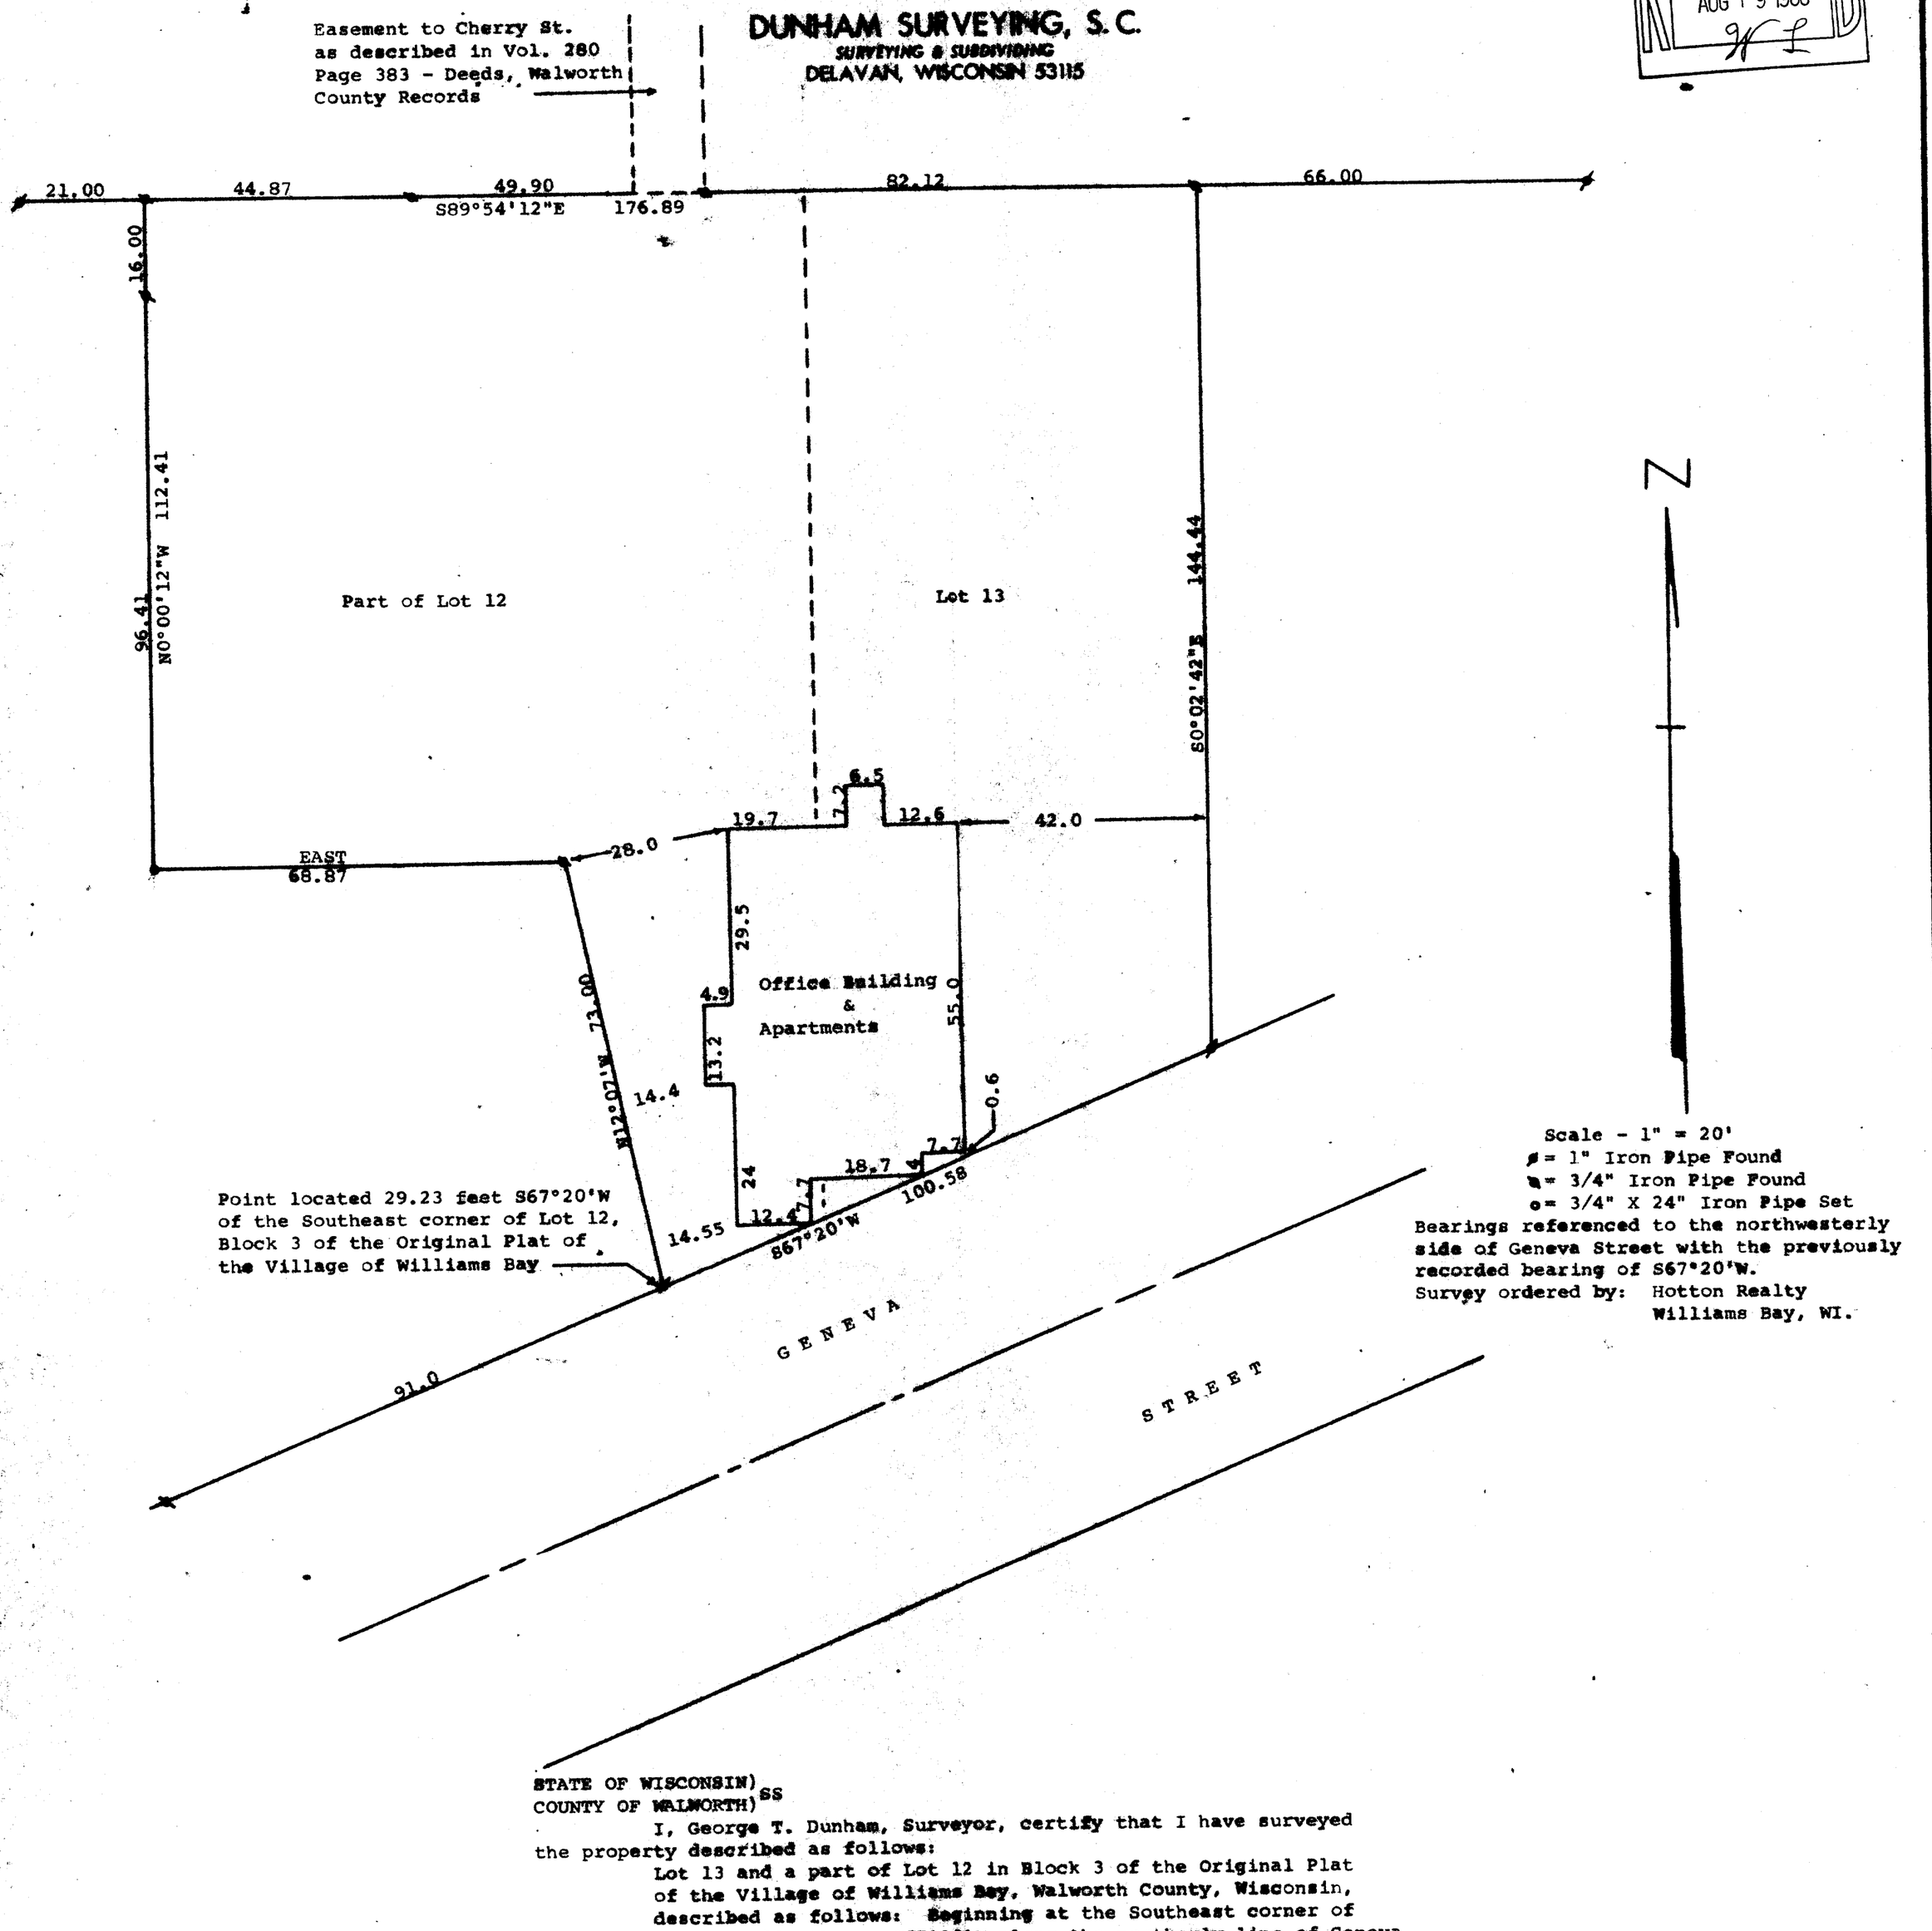

Scale - 1" = 20'
● = 1" Iron Pipe Found
◔ = 3/4" Iron Pipe Found
○ = 3/4" X 24" Iron Pipe Set
Bearings referenced to the northwesterly side of Geneva Street with the previously recorded bearing of S67°20'W.
Survey ordered by: Hotton Realty
Williams Bay, WI.

STATE OF WISCONSIN)
COUNTY OF WALWORTH) SS

I, George T. Dunham, Surveyor, certify that I have surveyed the property described as follows:

Lot 13 and a part of Lot 12 in Block 3 of the Original Plat of the Village of Williams Bay, Walworth County, Wisconsin, described as follows: Beginning at the Southeast corner of said Lot 12; thence S67°20'W along the northerly line of Geneva St. 29.23 feet; thence N12°07'W 73.00 feet; thence West 68.87 feet; thence N0°00'12"W 112.41 feet to the northerly line of said Lot 12; thence S89°54'12"E 176.89 feet to the northeast corner of said Lot 13; thence S0°02'42"E 144.44 feet to the southeast corner of said Lot 13; thence S67°20'W 71.35 feet to the place of beginning,

and that the above map is a true representation thereof and shows the size and location of the property, its exterior boundaries, the location of all visible structures and dimensions of all principal buildings thereon, boundary fences, apparent easements, roadways and visible encroachments, if any, and that I have surveyed the property hereon described according to the official records, to the best of my knowledge and belief.

September 1985

George T. Dunham, Surveyor

WISCONSIN
GEORGE T. DUNHAM
S-306
DELAVAN WIS.
LAND SURVEYOR

WOP-39

11-463D