
RECEIVED
SEP 30 1985

KOLB LAND CONSULTING, INC.

LAND SURVEYING · SUBDIVIDING · LAND PLANNING

929 WILLIAMS STREET LAKE GENEVA, WISCONSIN 53147 414-248-3697

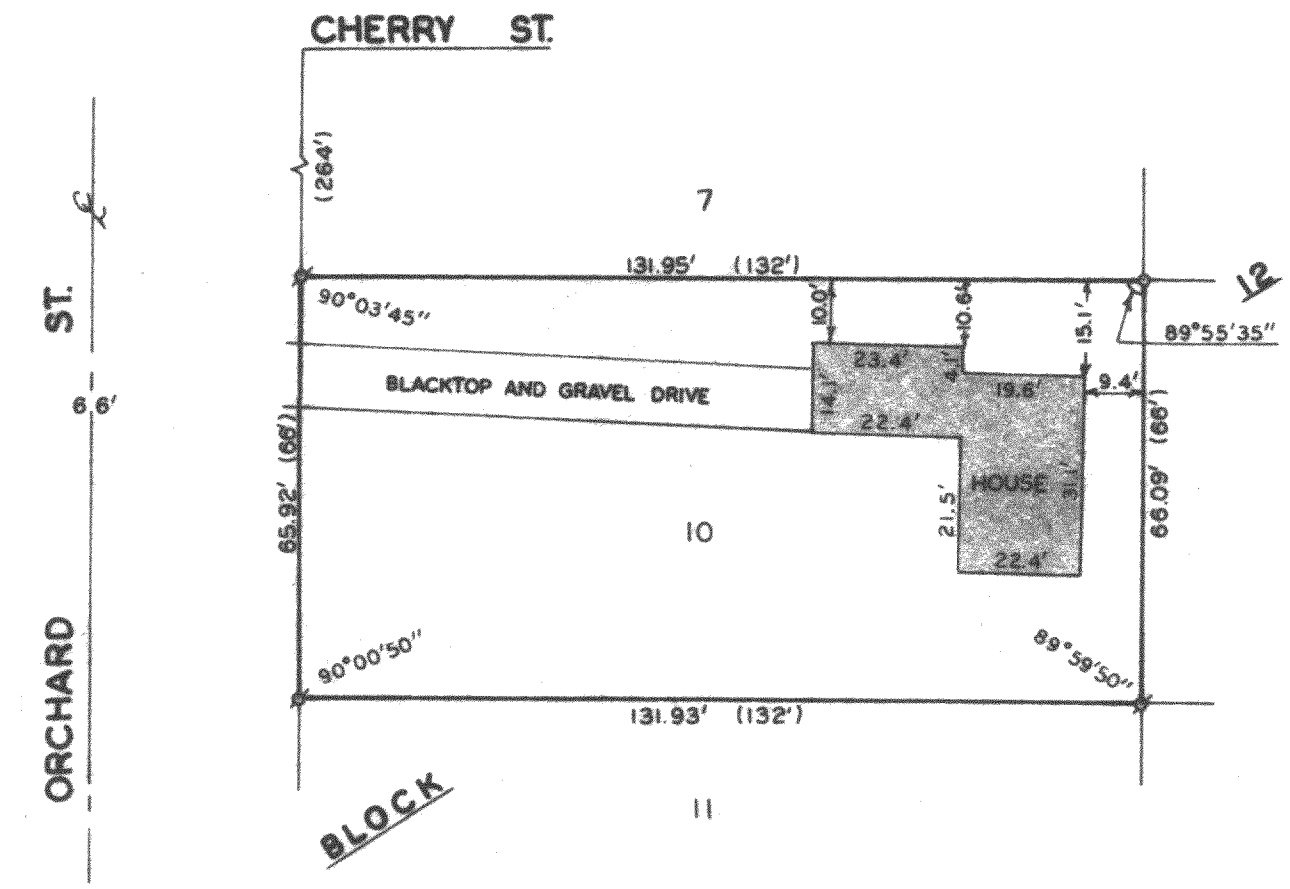

PLAT OF SURVEY OF

LOT 10, BLOCK 12, WILLIAMS 2ND ADDITION, VILLIAGE OF WILLIAMS BAY, WALWORTH COUNTY, WISCONSIN.

OWNER: WILLIAM B. MC PARTLIN

WISCONSIN
HAROLD H. KOLB
S-187
LAKE GENEVA, WIS
LAND SURVEYOR

SCALE - 1"=30'

LEGEND
- ⌀ IRON PIPE FOUND
- o IRON PIPE SET
- ( ) RECORDED AS

I, HAROLD H. KOLB, DO HEREBY CERTIFY THAT I HAVE SURVEYED THE PROPERTY HEREON DESCRIBED ACCORDING TO THE OFFICIAL RECORDS, AND THAT THE PLAT HEREON IS A CORRECT REPRESENTATION OF THE LOT LINES TO THE BEST OF MY KNOWLEDGE AND BELIEF.

Harold H. Kolb

HAROLD H. KOLB

WISCONSIN REGISTERED LAND SURVEYOR, S- 187

DATE APRIL 2, 1985

REVISED

REVISED

WOP-00180

11-466-K