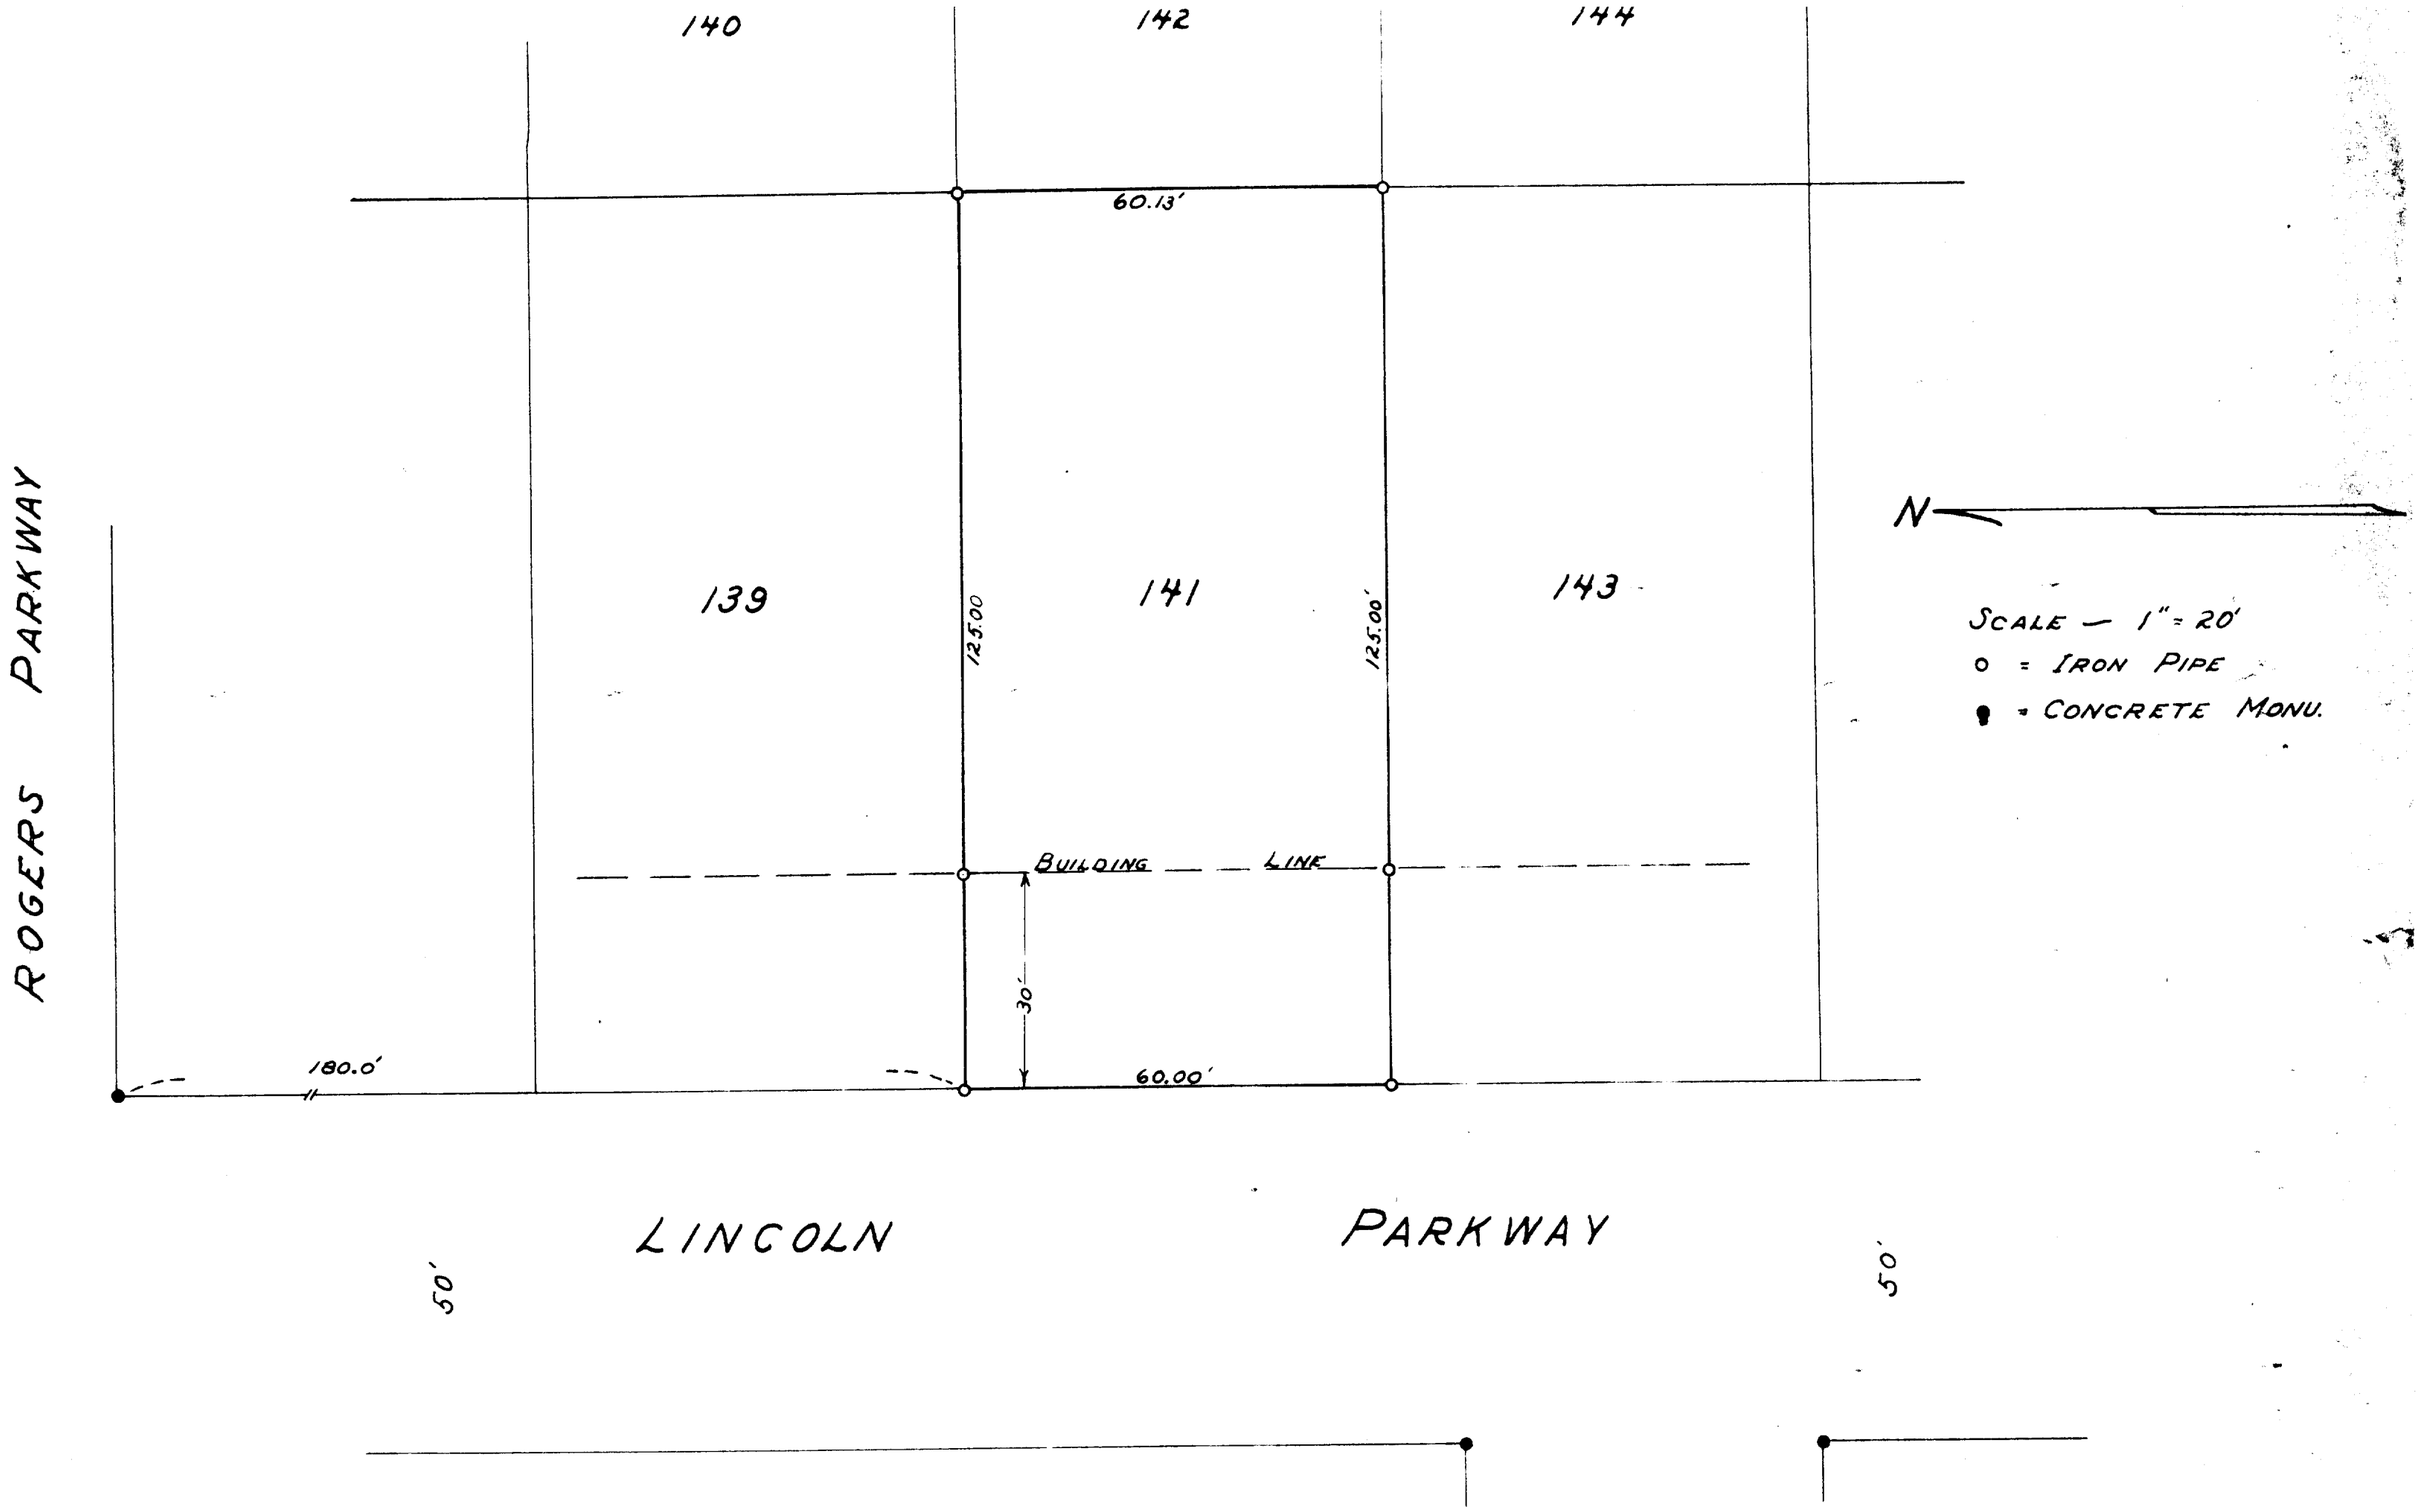

PLAT of SURVEY

LOT 141 OF CEDAR POINT PARK ORIGINAL IN THE VILLAGE OF WILLIAMS BAY, WALWORTH COUNTY, WISCONSIN.

OCTOBER 1948

Floyd L. Jensen
SURVEYOR

11-48

WCP-114