
PLAT OF SURVEY

OF

LOT 125 AND PART OF LOT 124, CEDAR POINT PARK 2ND ADDITION, LOCATED IN THE NE¼ OF SECTION 6, T1N R17E, VILLAGE OF WILLIAMS BAY, WALWORTH COUNTY, WISCONSIN.

RECEIVED
OCT 14 1986

℄ HIGHLAND ROAD

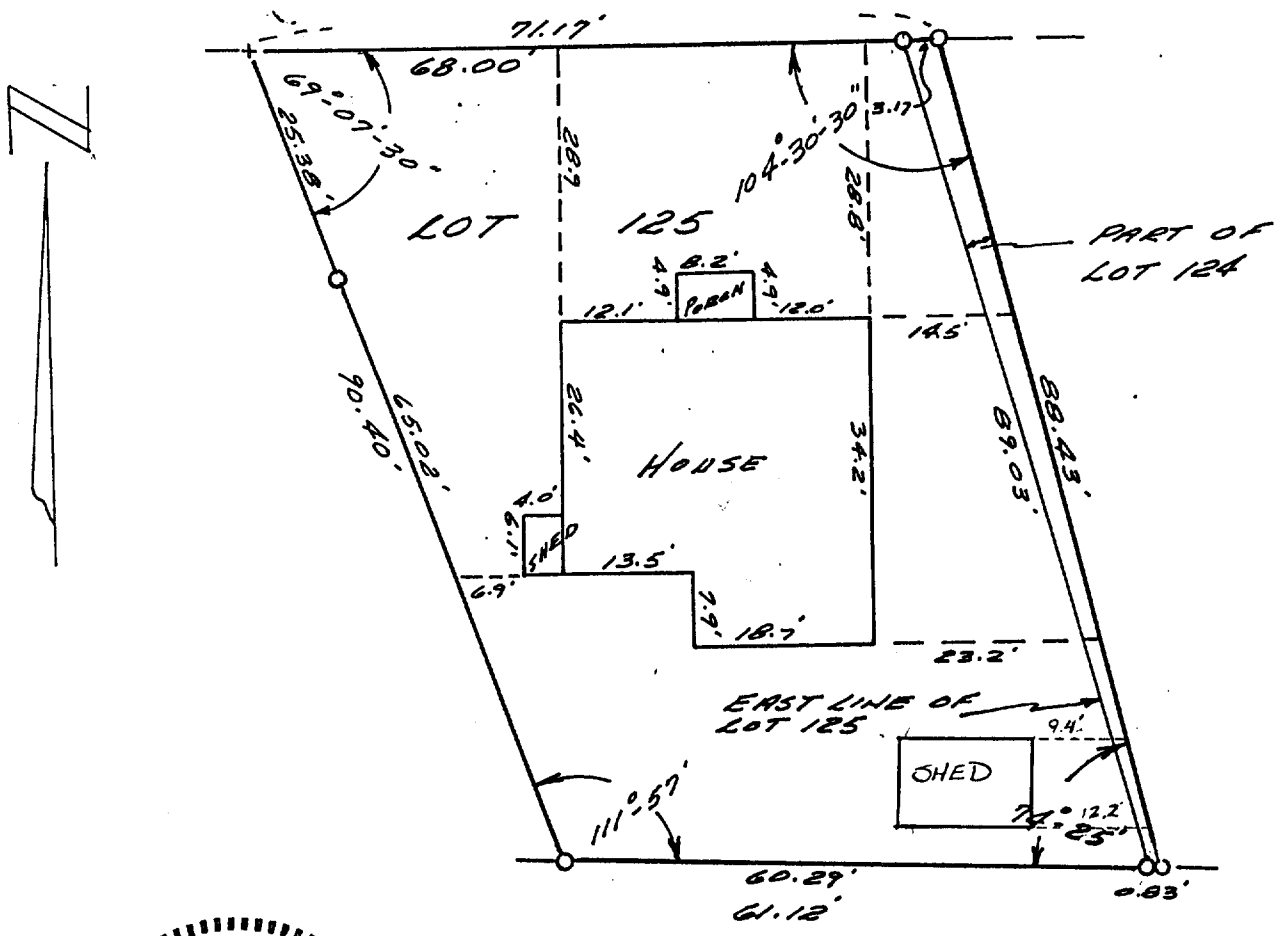

Recertified by: Jensen Surveying & Mapping S.C.
45 S. Wis. P.O. Box 322
Elkhorn, Wisconsin. 53121
June 25, 1986.

Thomas P.A. Jensen S-1084

WISCONSIN
THOMAS P. A. JENSEN
S-1084
ELKHORN, WIS.
LAND SURVEYOR

SURVEY AND PLAT BY

JENSEN & JOHNSON, INC.

CIVIL ENGINEERS AND SURVEYORS

Elkhorn, Wisconsin

LEGEND

- ∅ — Iron Pipe SET
- ● — Concrete Monument
- Scale 1" = 20
- o — IRON PIPE FOUND
- \+ — CHISEL CROSS CUT FOUND

WE CERTIFY: That we have surveyed the above described property and that the plat shown hereon is an accurate survey and a true representation thereof and correctly shows the exterior boundary lines and all divisions of said property, AND ALL BUILDINGS THEREON.

Date JULY 23, 1973 Thomas P.A. Jensen

[redacted],

Wisconsin Registered Land Surveyor, No. S-[redacted] 1084

POST 175H

1986052

11-511