
PLAT OF SURVEY OF LOT 11 OF BLOCK 13 OF WILLIAMS 2ND. ADD. VILLAGE OF WILLIAMS BAY, WALWORTH COUNTY, WIS.

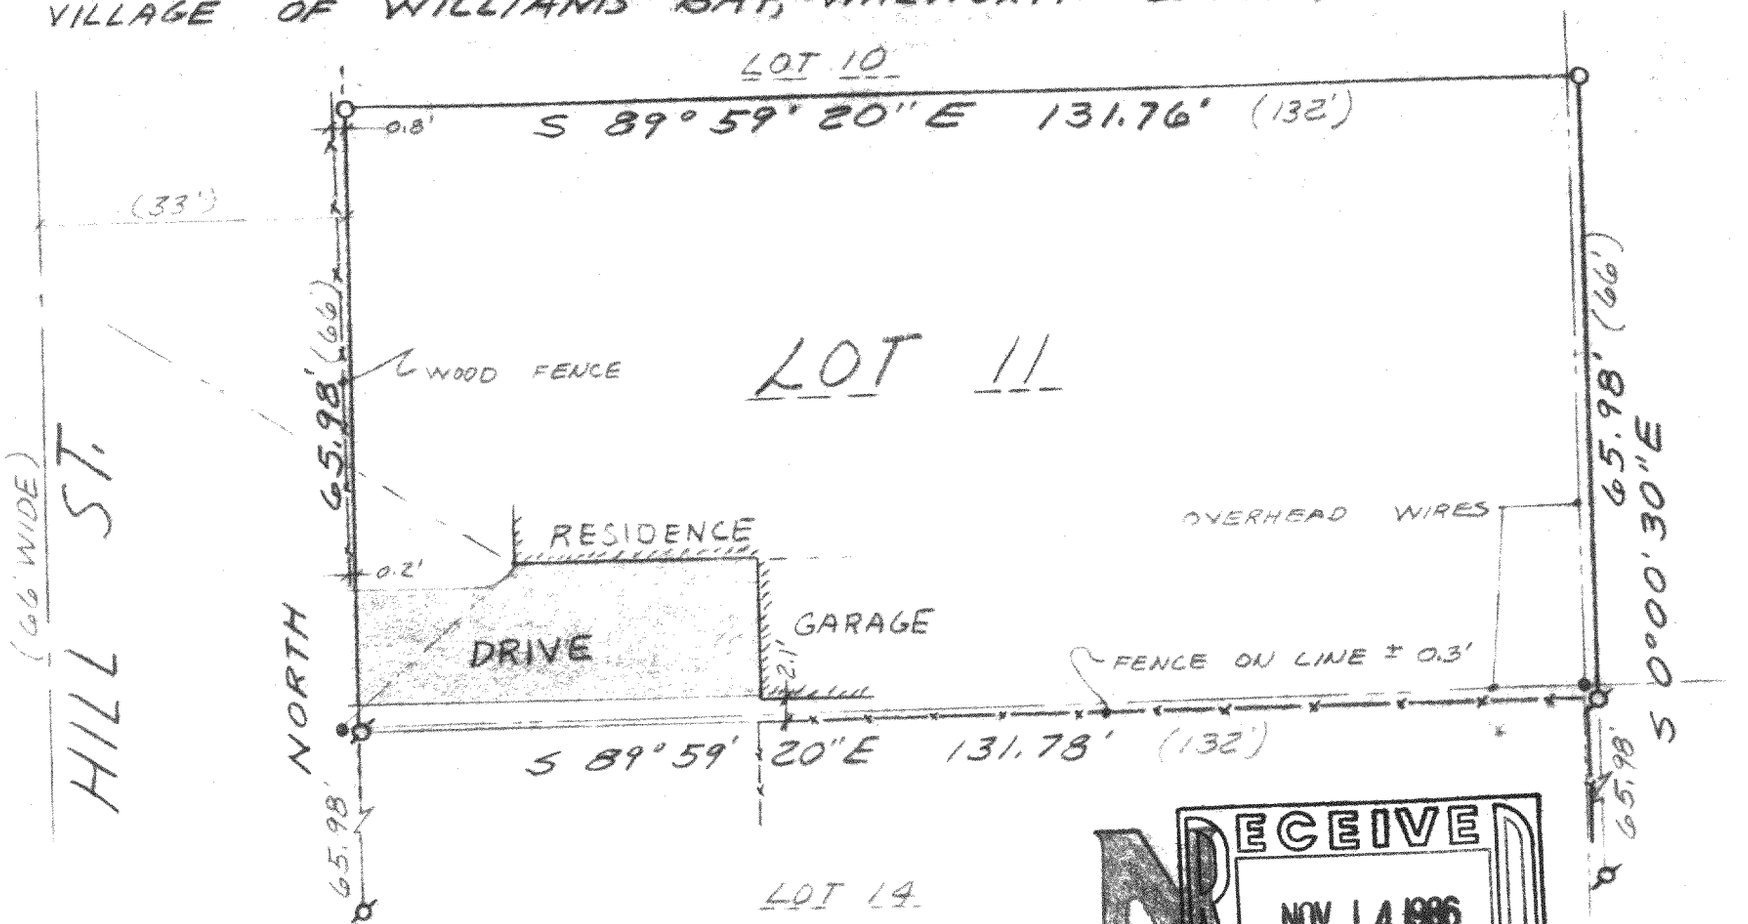

FARRIS, HANSEN & ASSOCIATES, INC.
7 Ridgeway Ct.
Elkhorn, WI 53121

RECEIVED
NOV 14 1986

Legend

- ∅ = FOUND IRON PIPE STAKE
- ○ = SET 3/4" X 24" IRON REBAR STAKE
- ● = UTILITY POLE
- (XXX) = RECORD DIMENSION

SCALE 1"=20'

WORK ORDERED BY MIDWEST REALTY

I HEREBY CERTIFY THIS PLAT TO BE A TRUE AND ACCURATE REPRESENTATION OF THE BOUNDARY LINES OF LOT 11 TO THE BEST OF MY PROFESSIONAL KNOWLEDGE & BELIEF.

WISCONSIN
ROBERT A FARRIS
S-1291
ELKHORN WIS
LAND SURVEYOR

Robert A. Farris

DATED NOV 12, 1986

DRAWING NUMBER 2692

WOP-194A

11-520F