
FARRIS, HANSEN & ASSOCIATES, INC.
7 RIDGEWAY COURT ELKHORN, WI
414-723-2098

RECEIVED
NOV 14 1986

Plat of Survey of lot 36 of Willabay Woods
Located in the Northeast 1/4 of the Northeast
1/4 of Section 6, Town 1 North, Range 17 East
Village of Williams Bay, Walworth County Wisconsin

WORK ORDERED BY: Midwest Realty
FOR: WILLABAY SHORES DEVELOPMENT CO.

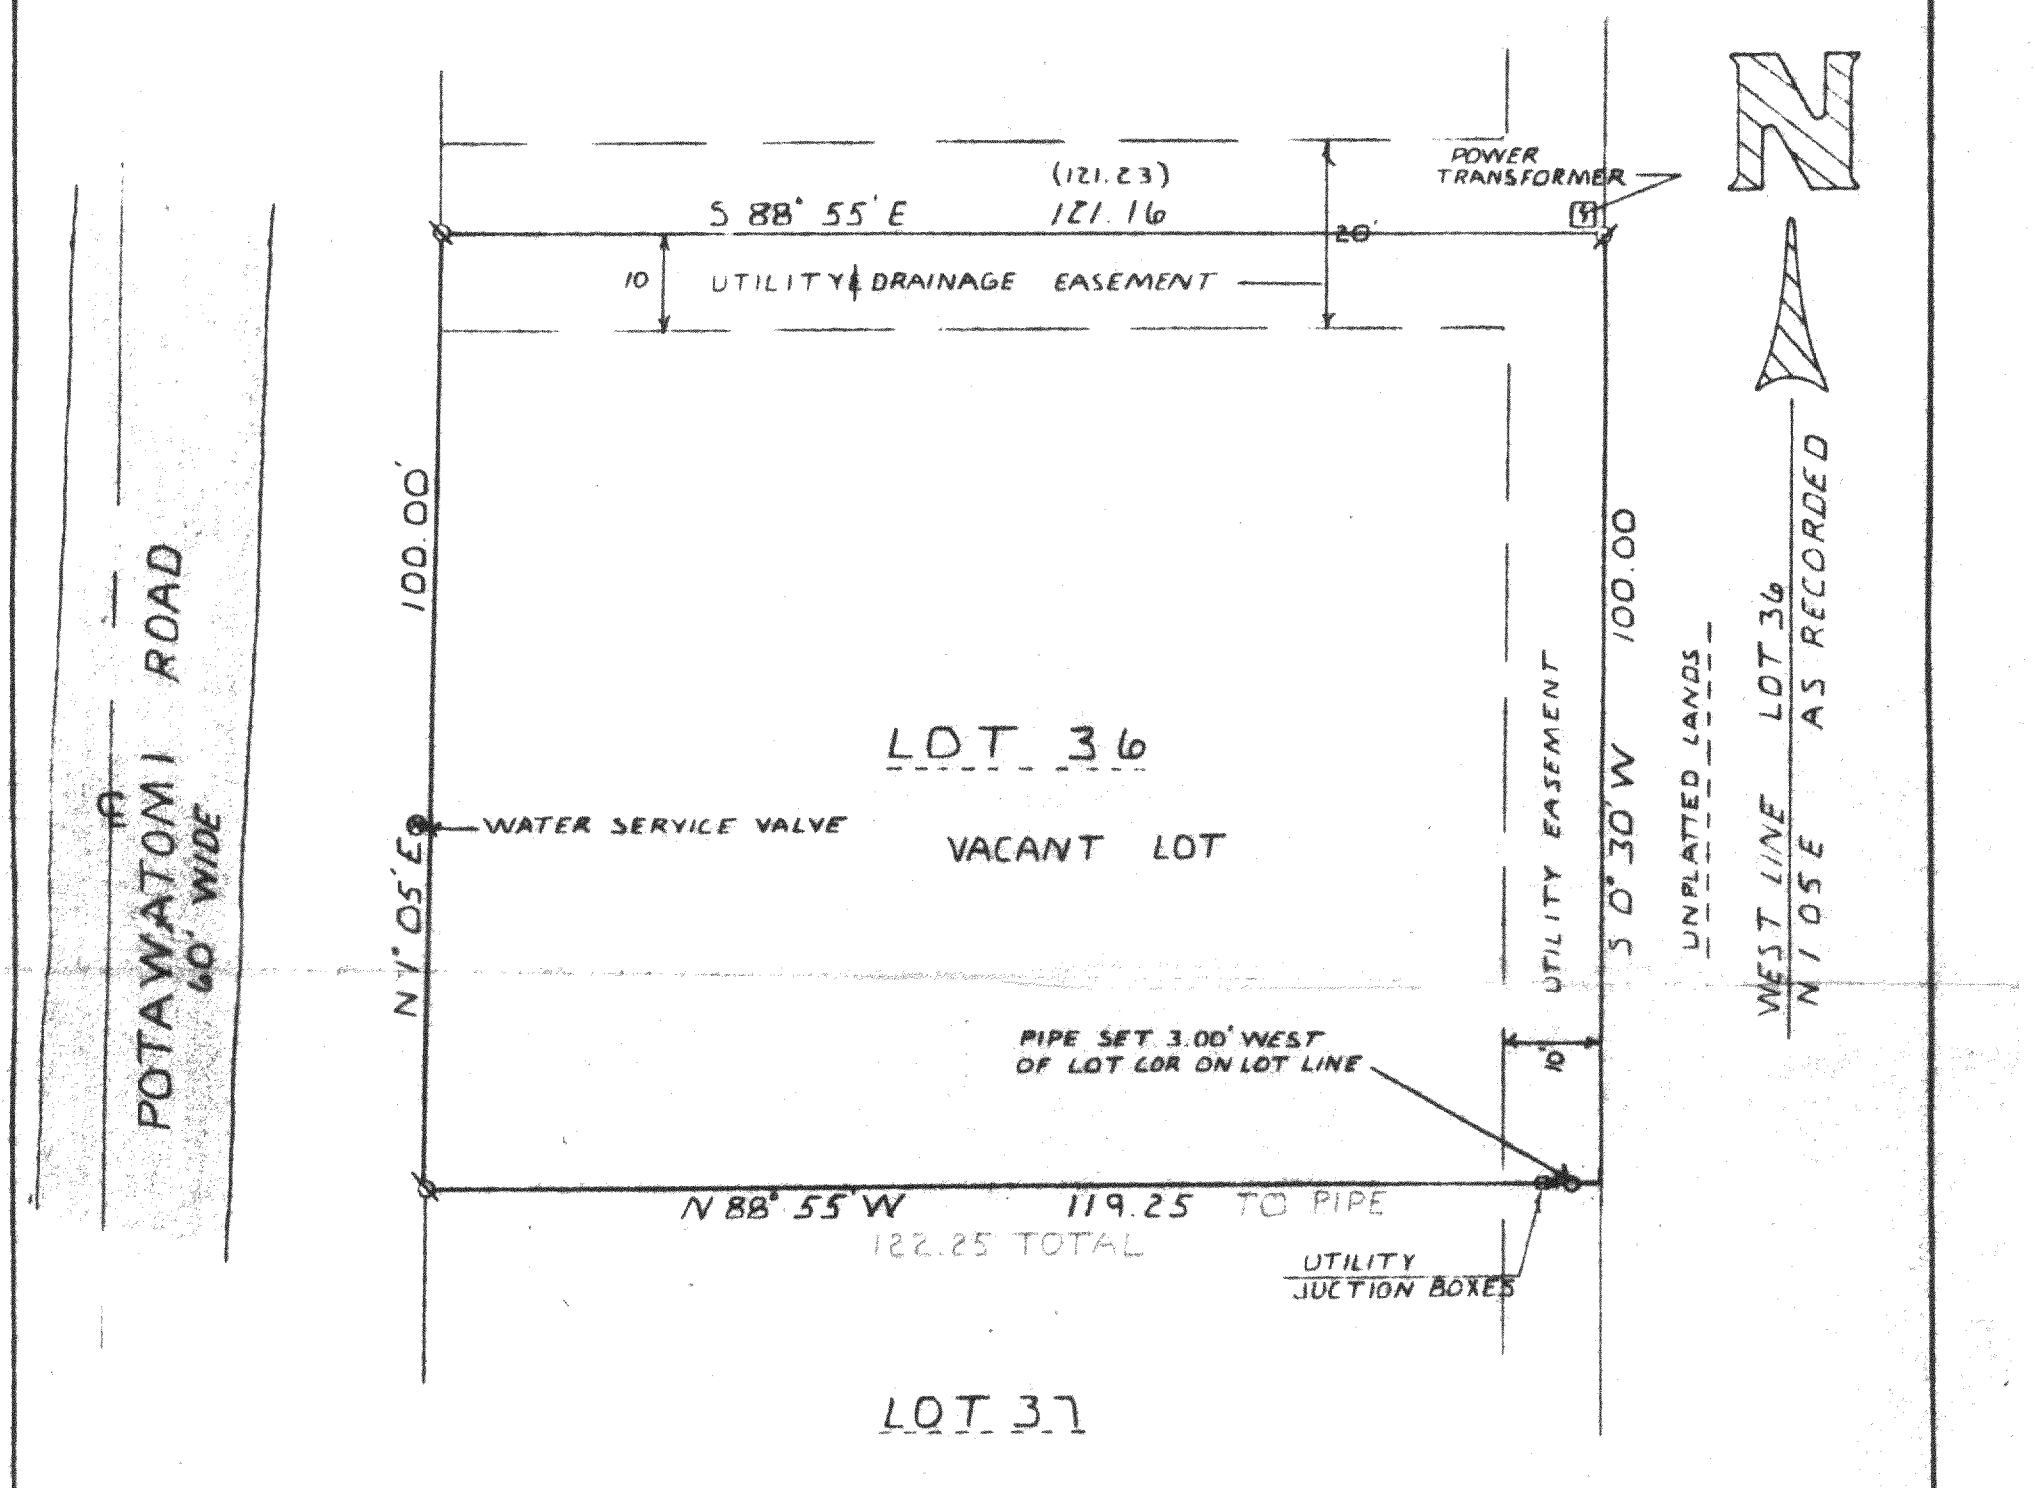

LEGEND

Ø = Iron Pipe Survey Stake Found
O = Iron Pipe Survey Stake Set
(XXX)= Record Dimension

WISCONSIN
ROBERT A FARRIS
S-1291
ELKHORN
WIS
LAND SURVEYOR

CERTIFICATE

I hereby certify that the above described property has been surveyed under my direction and that the above map is a true representation thereof and shows the size and location of the property, its exterior boundaries, the location of all visible structures and dimensions of all principal buildings thereon, boundary fences, apparent easements, roadways and visible encroachments, if any.
This survey is made for the use of the present owners of the property, and also for those who purchase, mortgage, or guarantee the title thereto within one (1) year from the date hereof.

Robert A. Farris, R.L.S.

Dated this 24th day of Sept, 1986 PROJECT NO. 2662

WWW-36

11-521F