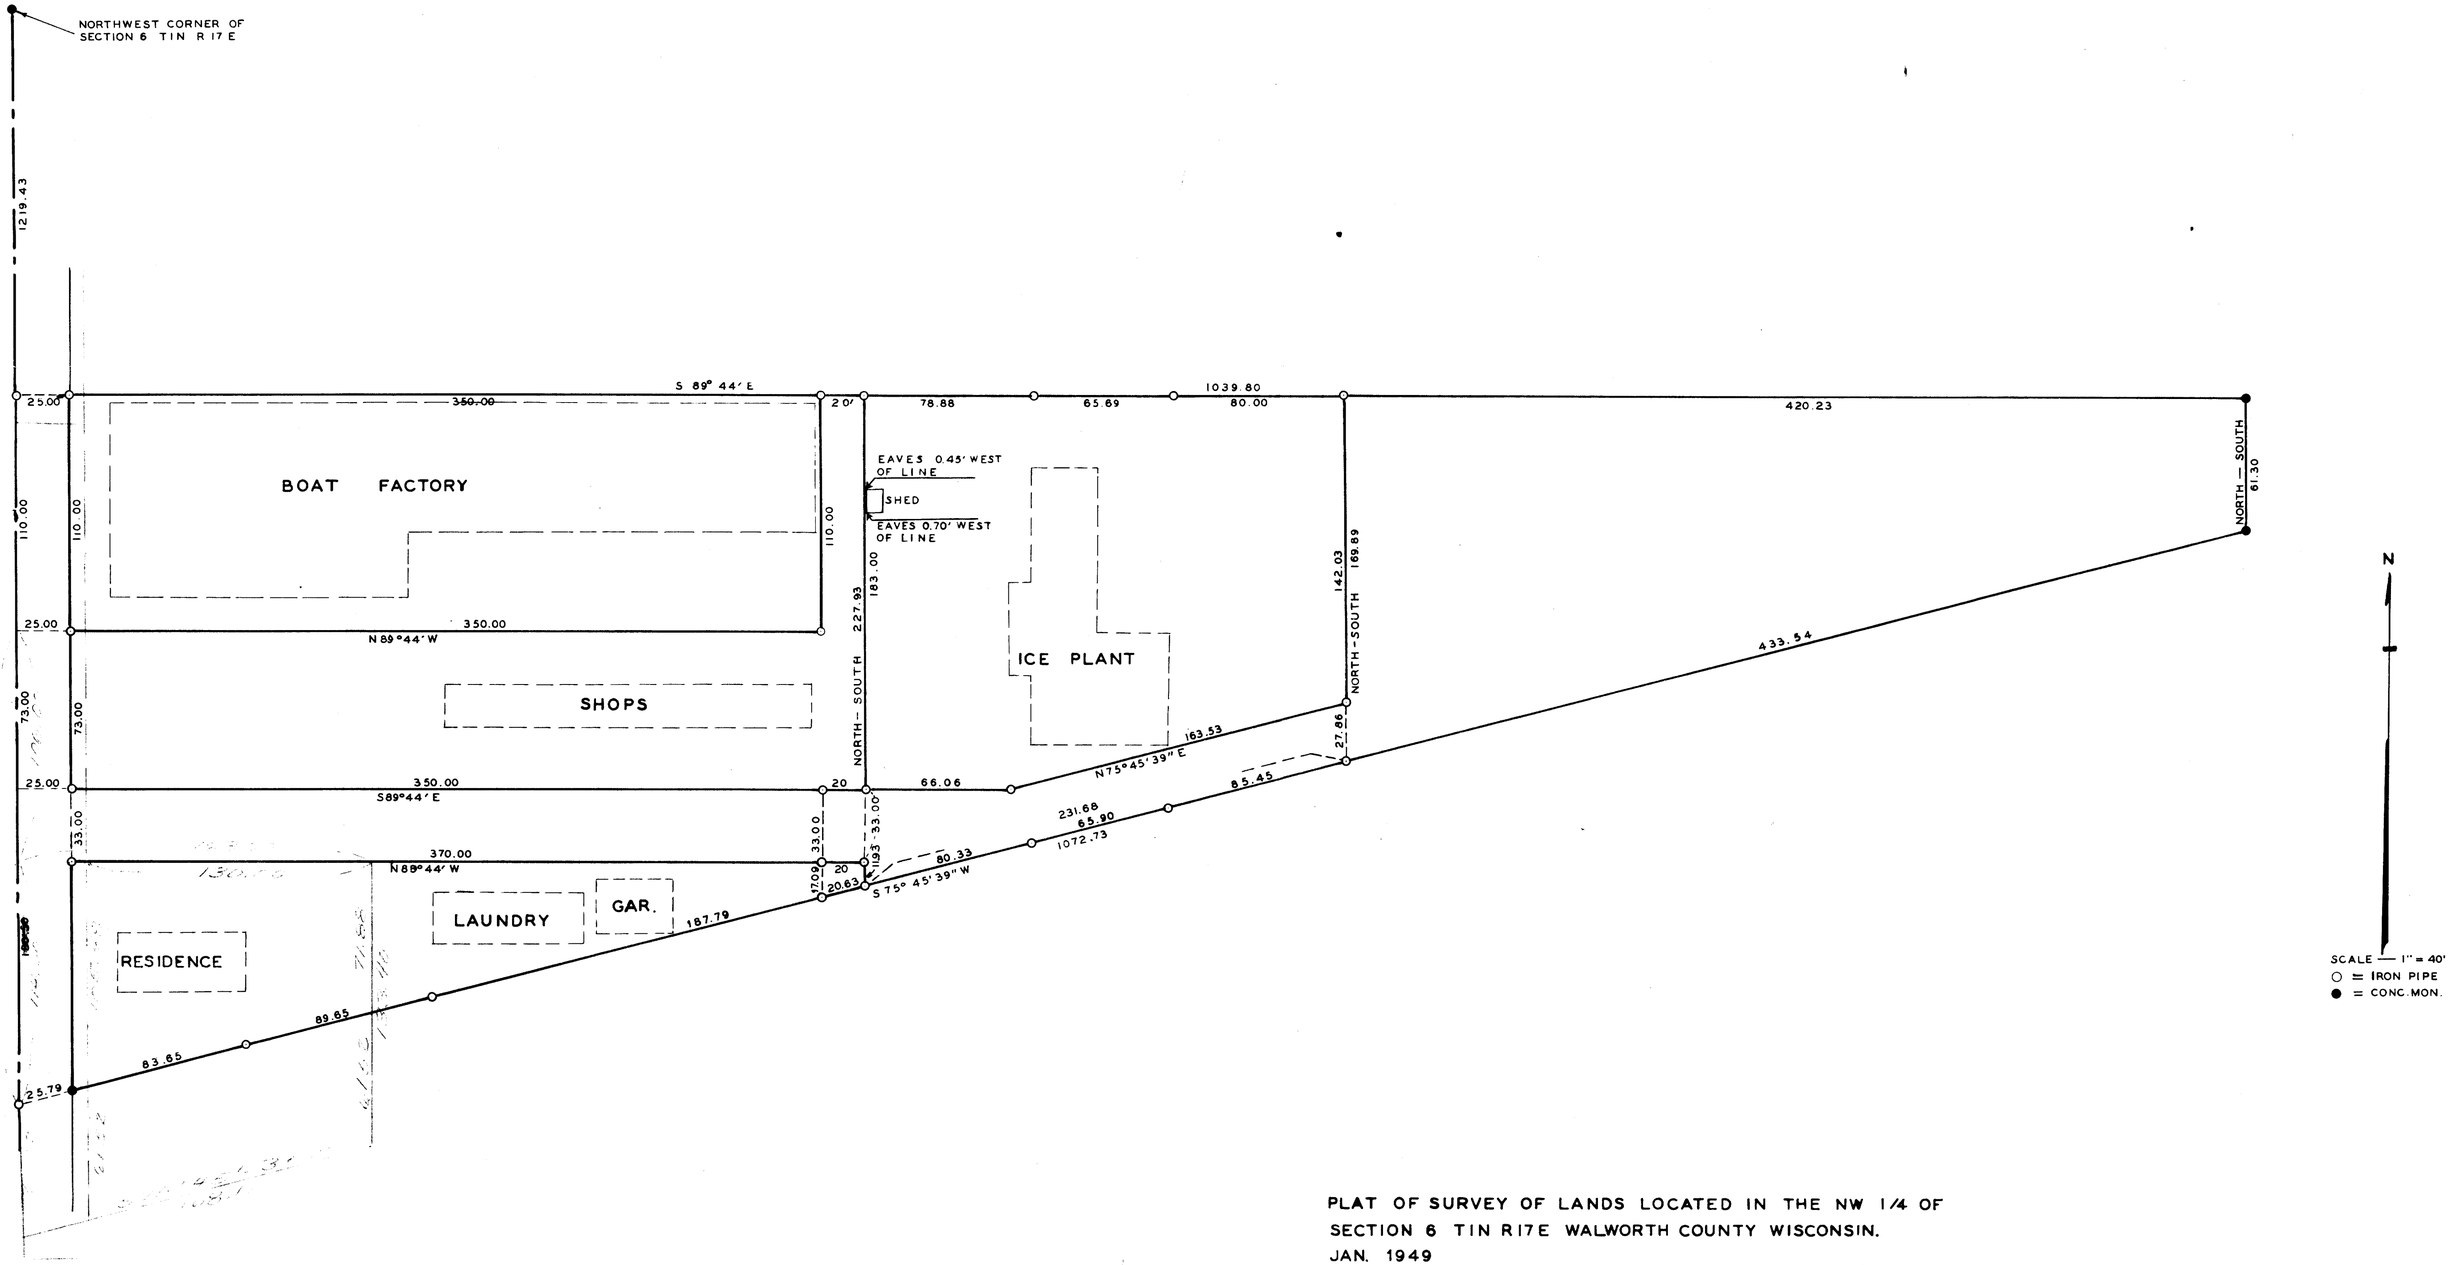


PLAT OF SURVEY OF LANDS LOCATED IN THE NW 1/4 OF SECTION 6 T1N R17E WALWORTH COUNTY WISCONSIN.
JAN. 1949

REVISED - DECEMBER, 1951
Floyd L. Jensen
SURVEYOR
Floyd L. Jensen
SURVEYOR JULY 1955

H. E. Johnson
SURVEYOR

UP-43
UP-44
UP-45 & UP-48

11-59 J