
119/72

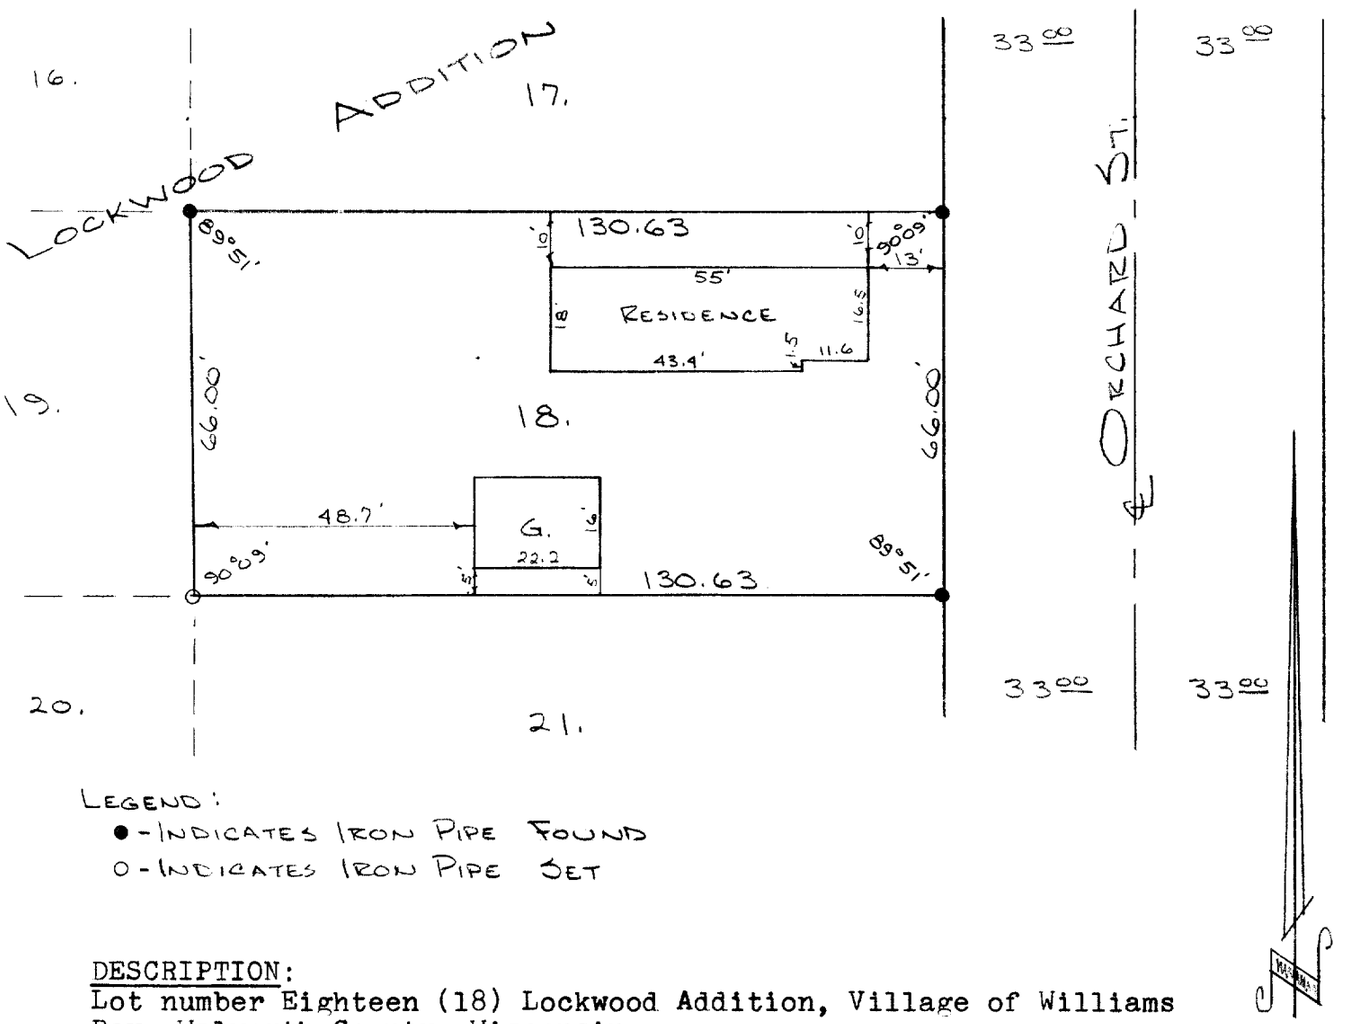

LEGEND:
- ● - INDICATES IRON PIPE FOUND
- O - INDICATES IRON PIPE SET

DESCRIPTION:
Lot number Eighteen (18) Lockwood Addition, Village of Williams Bay, Walworth County, Wisconsin.

CERTIFICATE:
I, James F. Biagi, surveyor, do hereby certify that I have surveyed the lands hereon described.

September 27, 1972

James F. Biagi RLS #272

WISCONSIN JAMES F.

WLW-15

11-5B