
WALWORTH COUNTY
SURVEYING & MAPPING
LAKE GENEVA, WISCONSIN

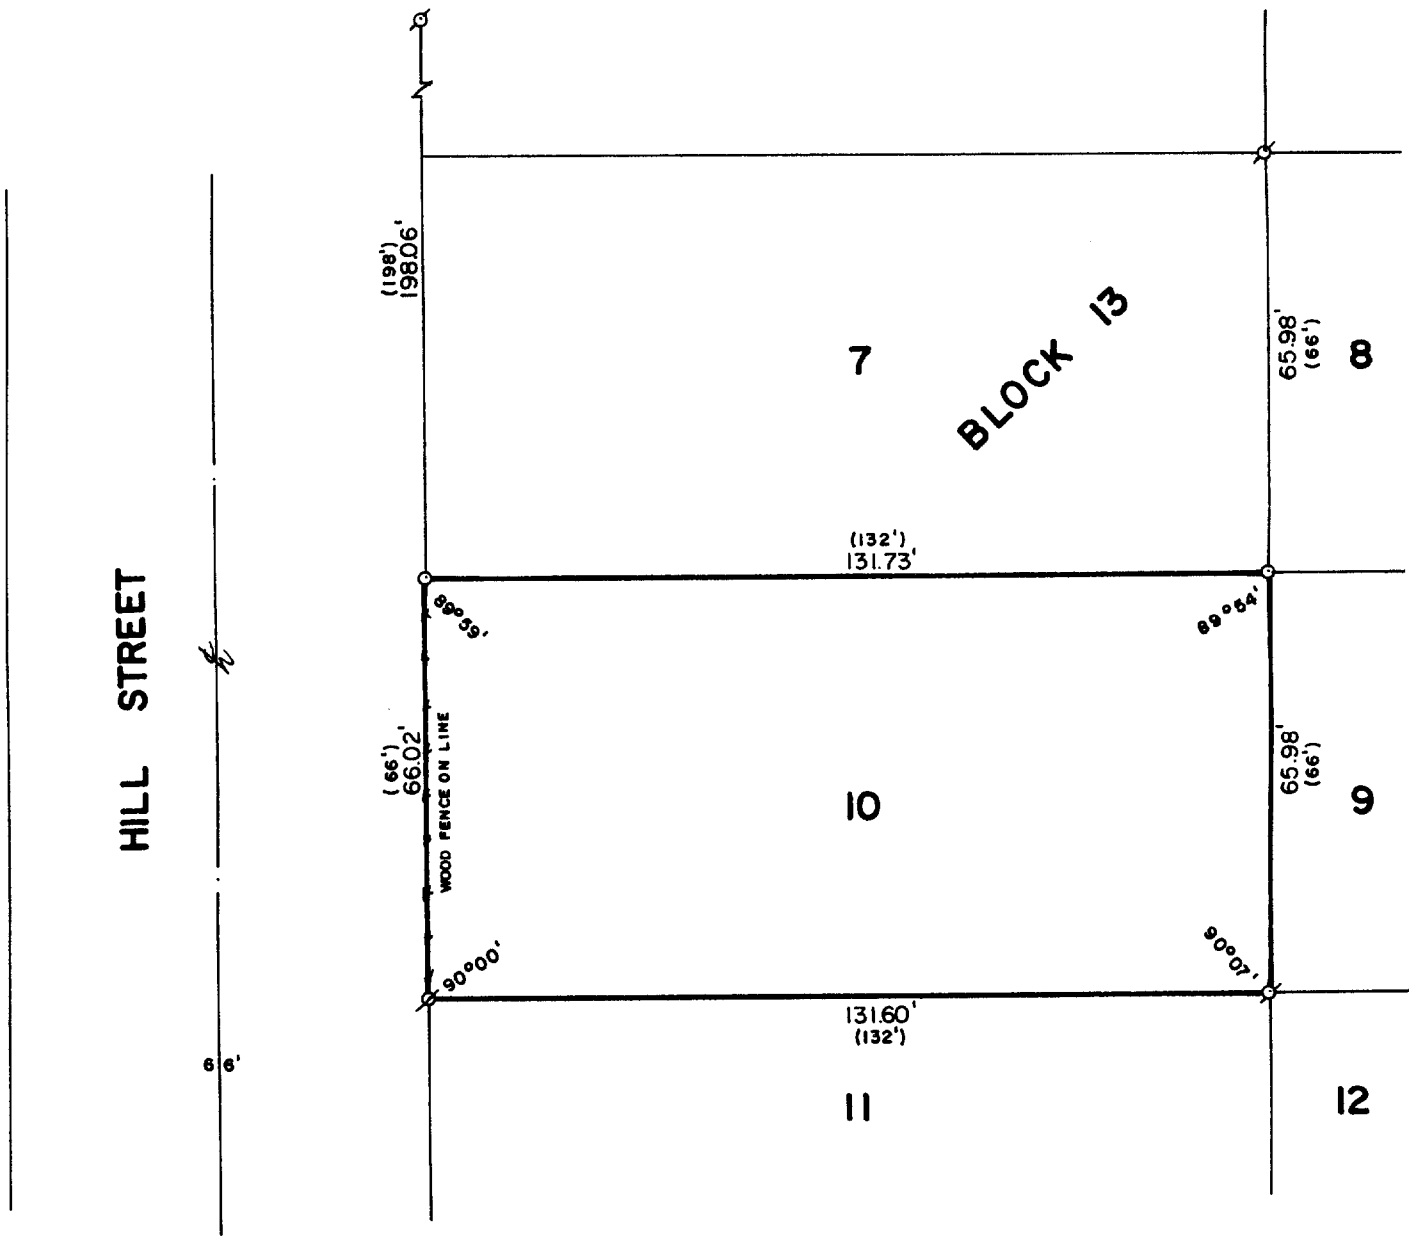

RECEIVED
MAY 9 1988

PLAT OF SURVEY OF

LOT 10, BLOCK 13 OF WILLIAMS SECOND ADDITION TO THE VILLAGE OF WILLIAMS BAY, WALWORTH COUNTY, WISCONSIN.

ORDERED BY: ASSURED REALTY
P. O. BOX 367
WILLIAMS BAY, WISCONSIN
53191

SCALE: 1"=30'

⌀ -IRON PIPE FOUND
⌀ -IRON ROD FOUND
o -IRON ROD PLACED
()-RECORDED AS

I, ROBERT M. BAERENWALD, DO HEREBY CERTIFY THAT I HAVE SURVEYED THE PROPERTY HEREON DESCRIBED ACCORDING TO THE OFFICIAL RECORDS AND THAT THE PLAT HEREON IS A CORRECT REPRESENTATION OF THE PROPERTY LINES TO THE BEST OF MY KNOWLEDGE AND BELIEF.

Robert M. Baerenwald
ROBERT M. BAERENWALD
WISCONSIN REGISTERED LAND SURVEYOR, S-1508

March 2, 1988
DATE JOB NO. 1428

NOTE: THIS IS NOT A CERTIFIED COPY UNLESS SEALED.

W08-194

11-629