


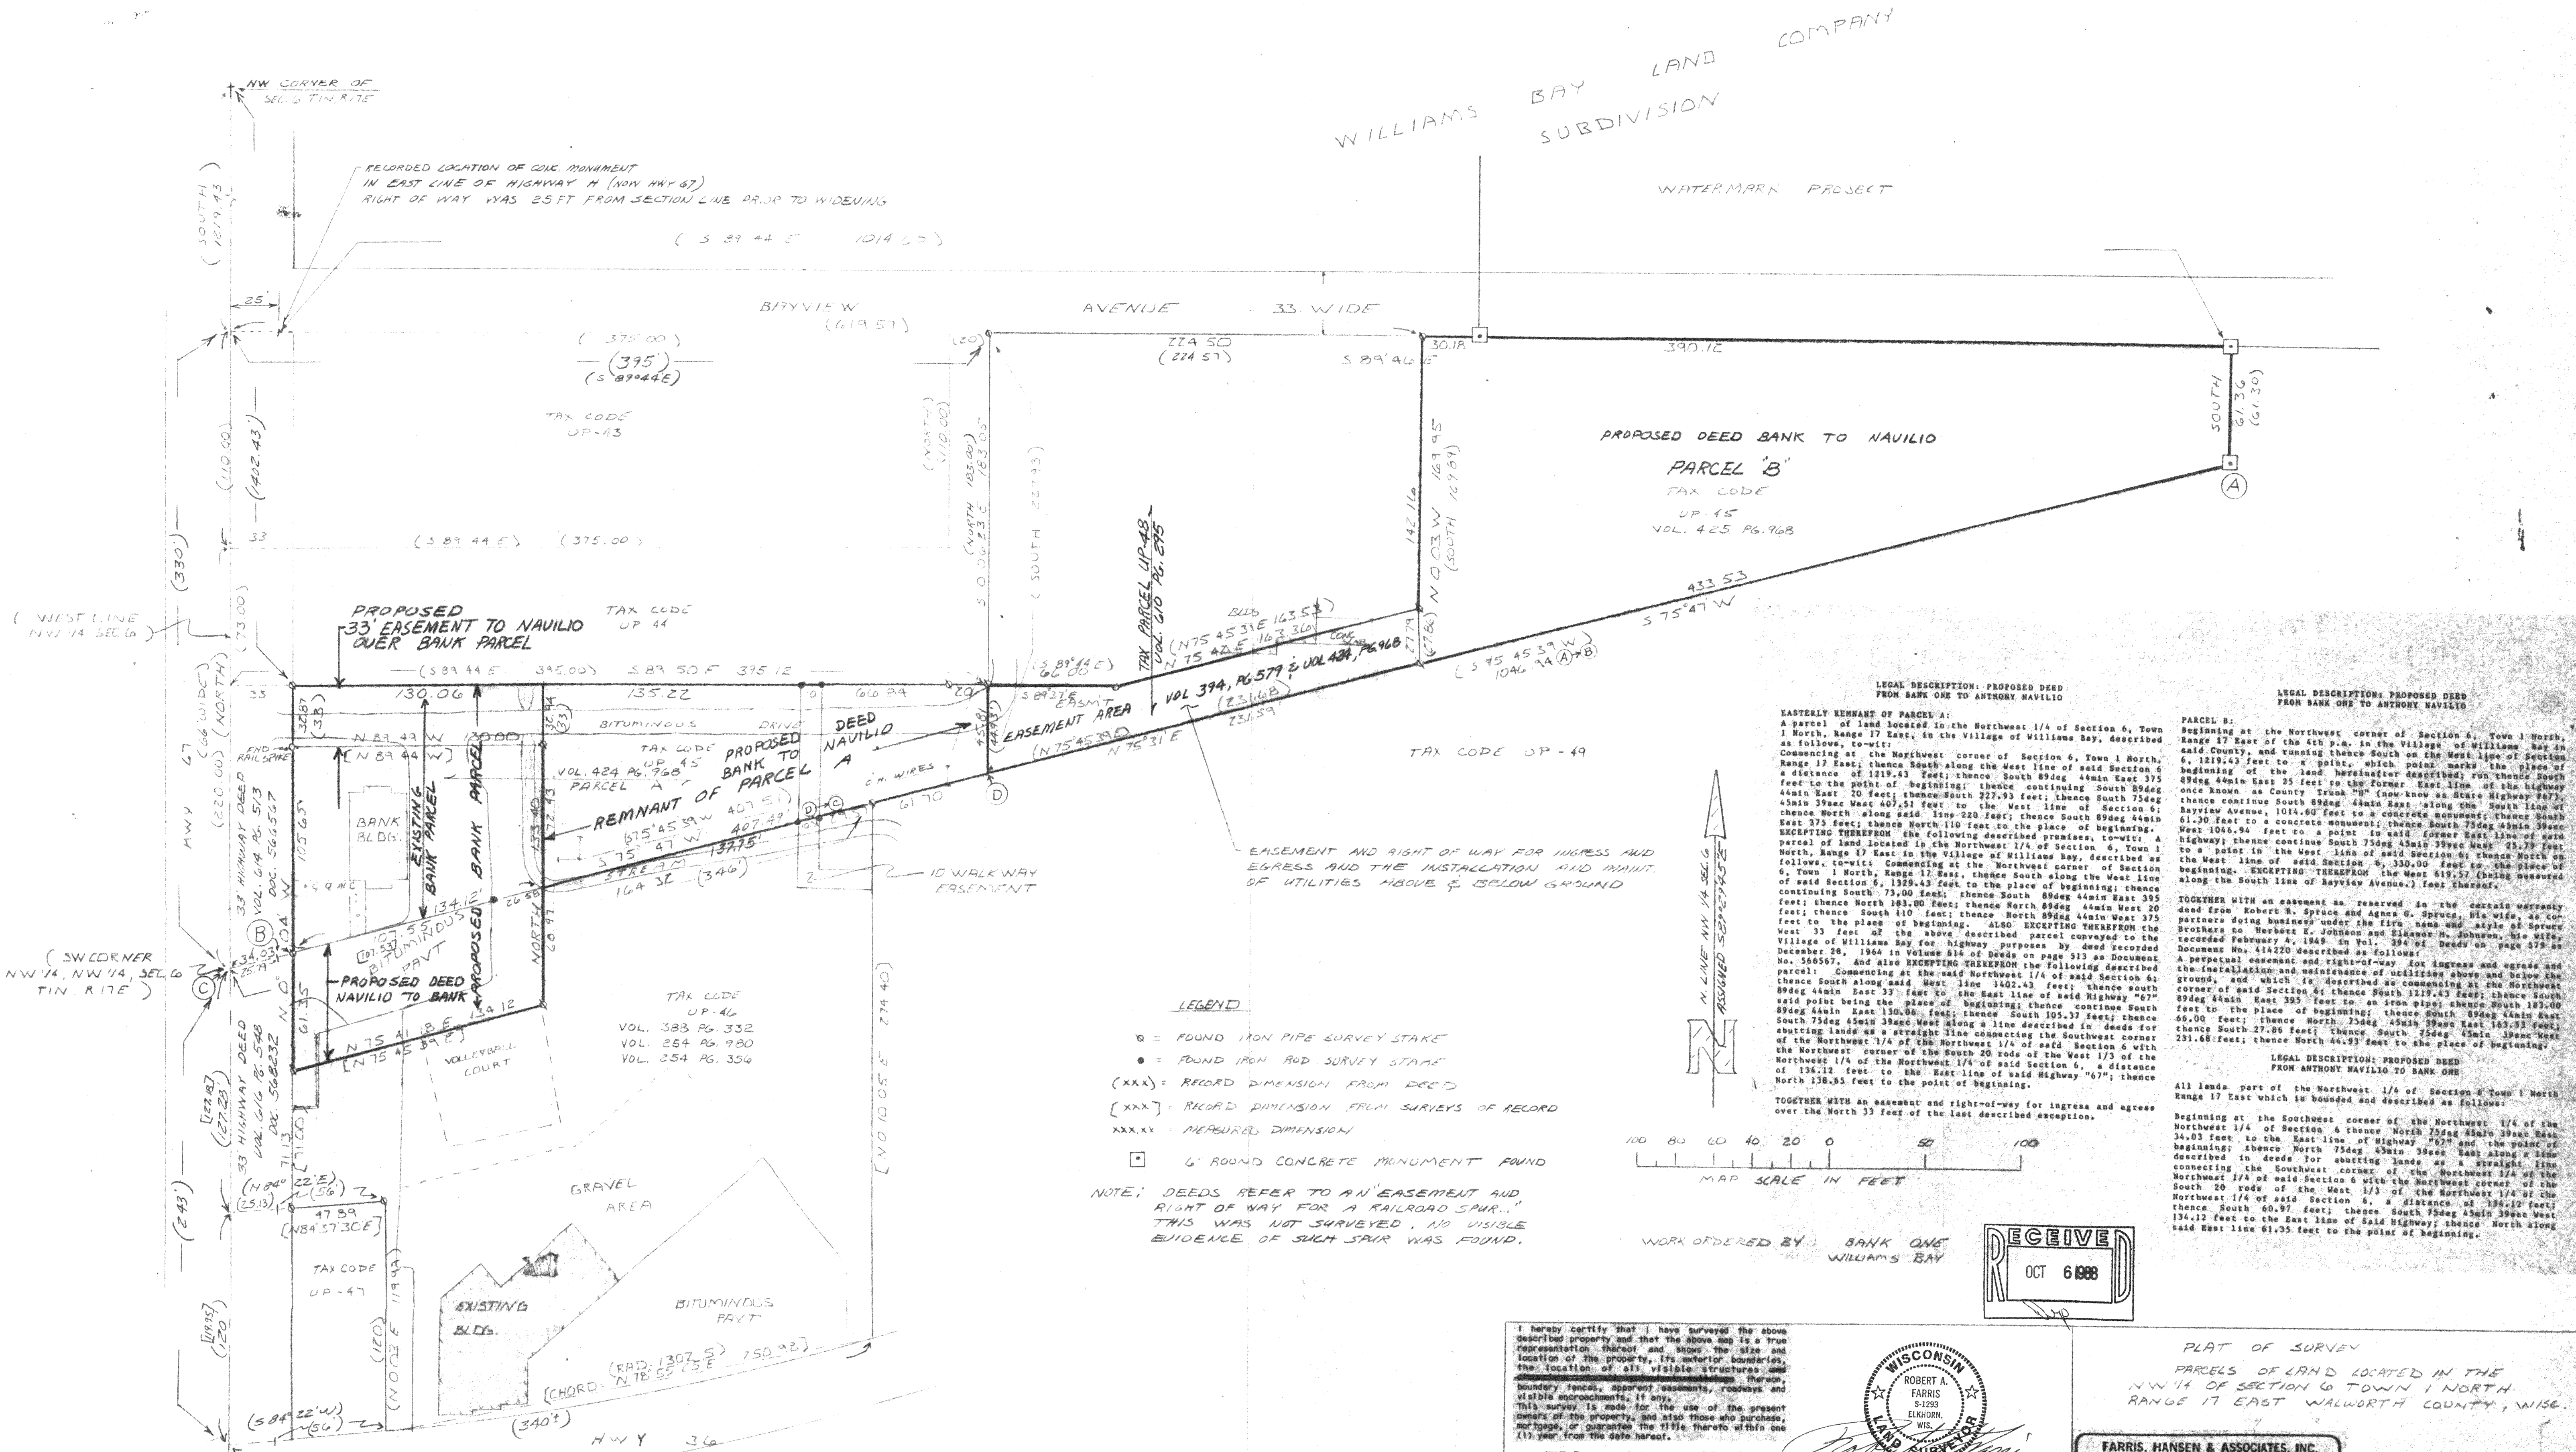

NOTE: DEEDS REFER TO AN "EASEMENT AND RIGHT OF WAY FOR A RAILROAD SPUR". THIS WAS NOT SURVEYED, NO VISIBLE EVIDENCE OF SUCH SPUR WAS FOUND.

LEGEND

- = FOUND IRON PIPE SURVEY STAKE
- = FOUND IRON ROD SURVEY STAKE
- (xxx) = RECORD DIMENSION FROM DEED
- [xxx] = RECORD DIMENSION FROM SURVEYS OF RECORD
- xxx.xx = MEASURED DIMENSION
- = 6" ROUND CONCRETE MONUMENT FOUND

MAP SCALE IN FEET

100 80 60 40 20 0 20 40 60 80 100

WORK ORDERED BY BANK ONE WILLIAMS BAY

RECEIVED OCT 6 1988

PLAT OF SURVEY


FARRIS, HANSEN & ASSOCIATES, INC.
Engineers, Architects, Surveyors
7 Ridgeway Court, P.O. Box 437
ELKHORN, WISCONSIN 53121
Office: (414) 723-2088

PROJ. #3052

11-677