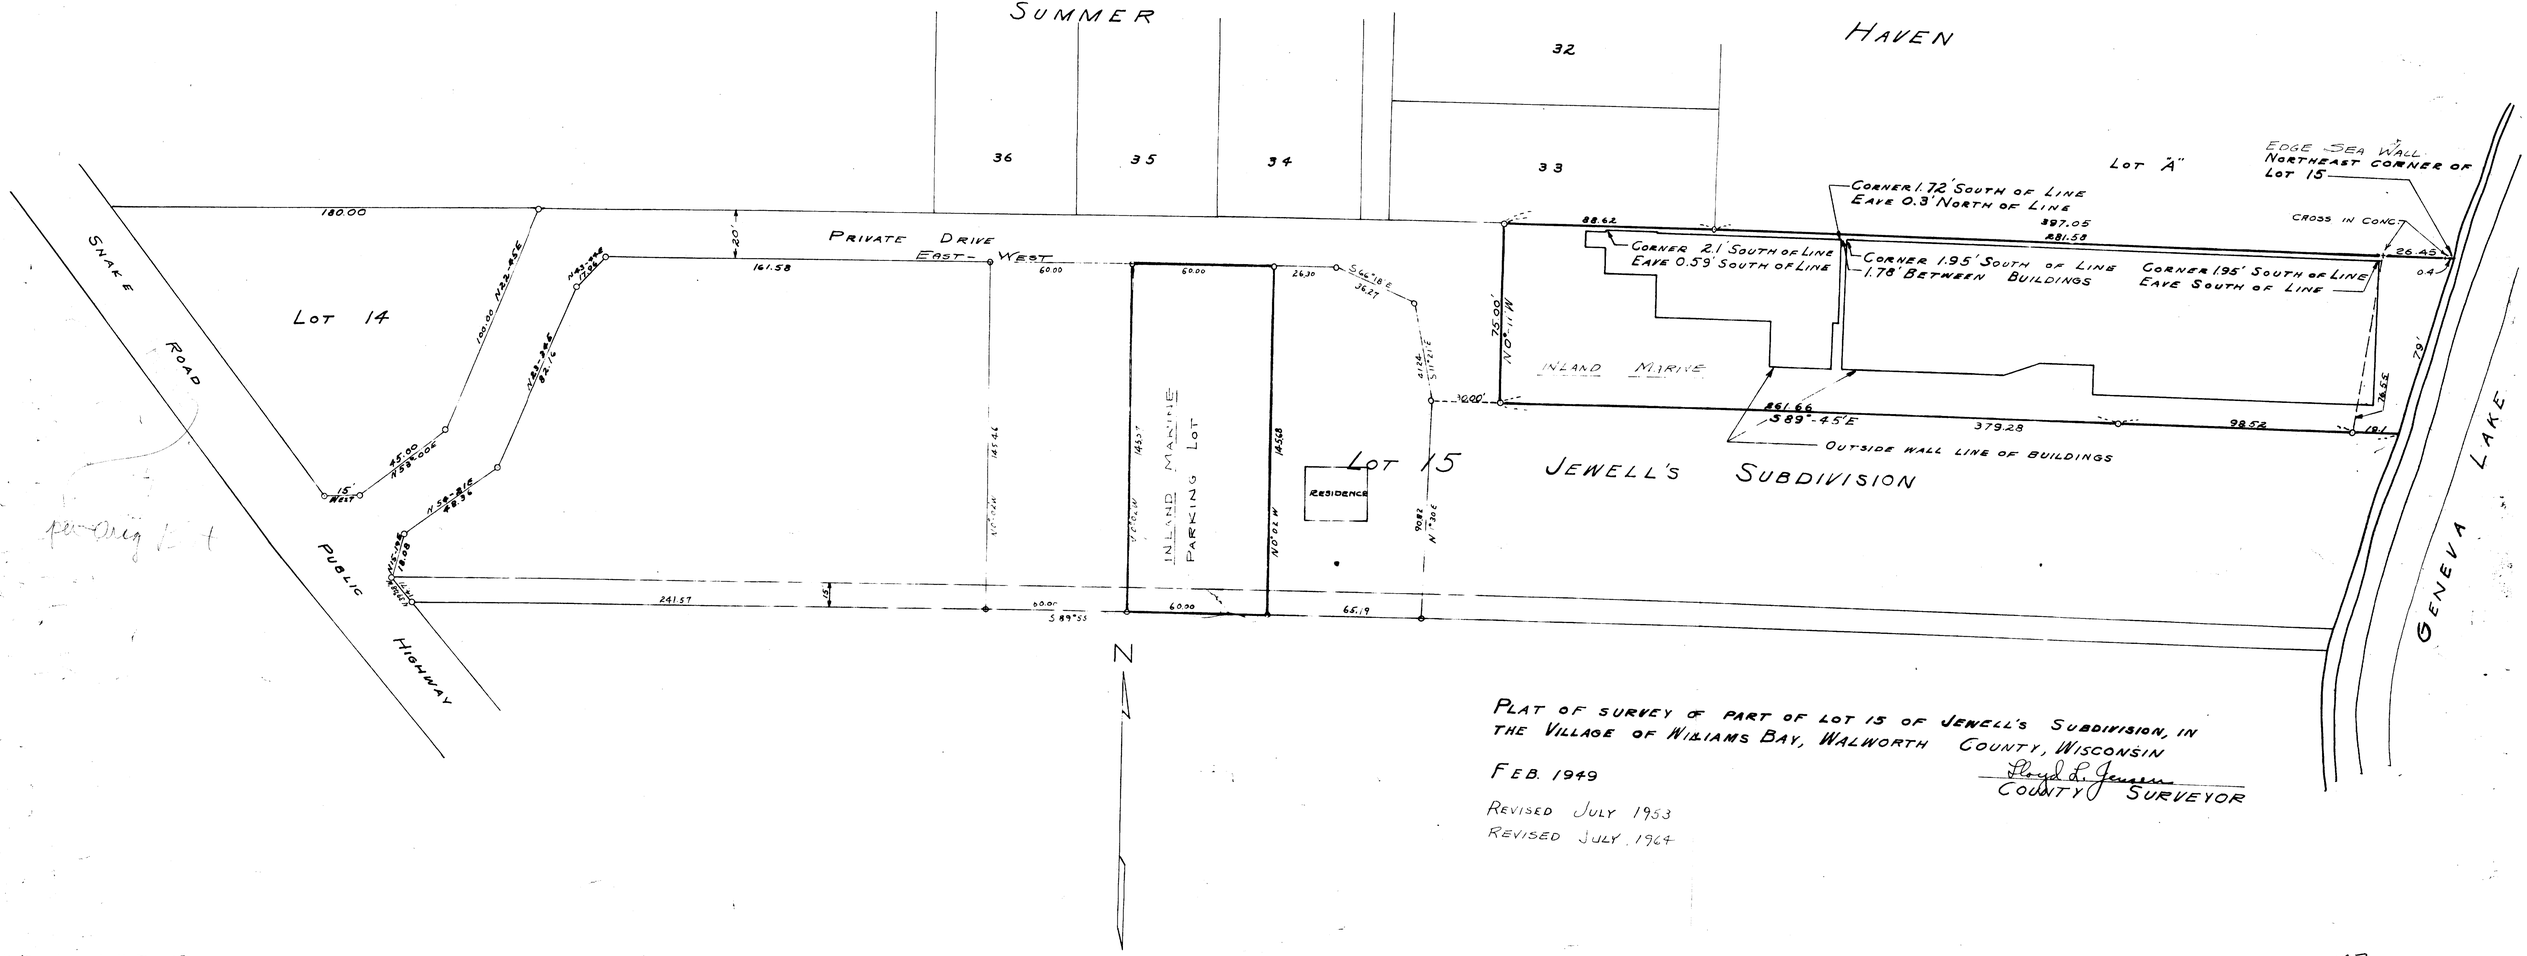


PLAT OF SURVEY OF PART OF LOT 15 OF JEWELL'S SUBDIVISION, IN THE VILLAGE OF WILLIAMS BAY, WALWORTH COUNTY, WISCONSIN

FEB. 1949

REVISED JULY 1953

REVISED JULY 1964

Lloyd L. Jensen
COUNTY SURVEYOR

WJ-14 + WJ-15

11-67