
#91/72

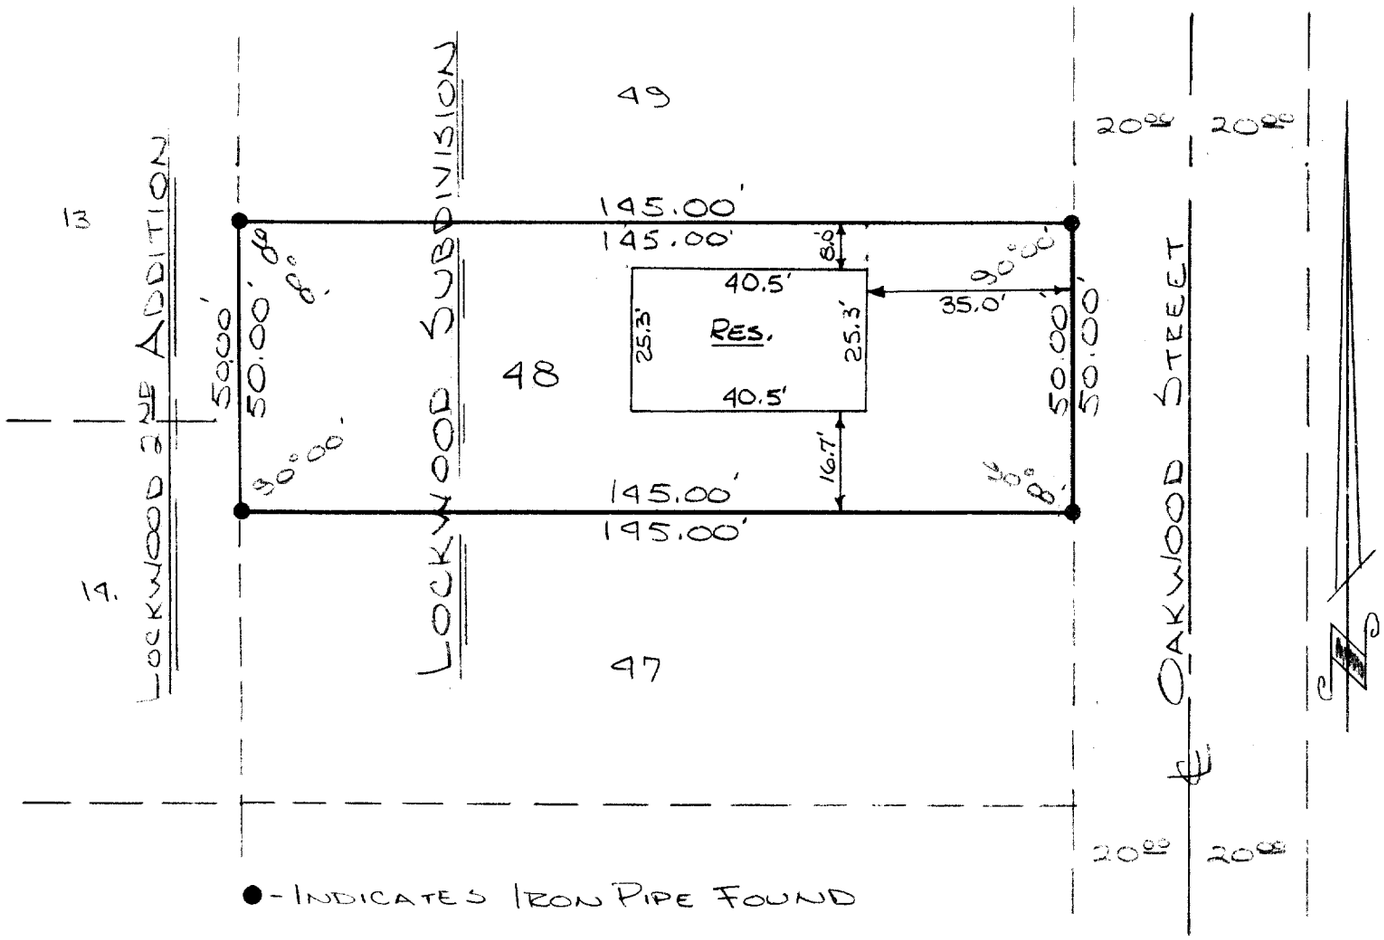

DESCRIPTION:
All of Lot number Forty-Eight (48) Lockwood Subdivision, in the Village of Williams Bay, Walworth County, Wisconsin.

CERTIFICATE:
I, James F. Biagi, surveyor, do hereby certify that I have surveyed the lands hereon described.

July 24, 1972

James F. Biagi RLS#272

WISCONSIN JAMES F. BIAGI MILWAUKEE, WIS. LAND SURVEYOR

RE-CERTIFICATION

November 14,1972

Joseph M Biagi RLS#12

11-6B