


DUNHAM SURVEYING, S. C.
SURVEYING & SUBDIVIDING
DELAVER, WISCONSIN 53115

N

POINT
CEDAR

DRIVE

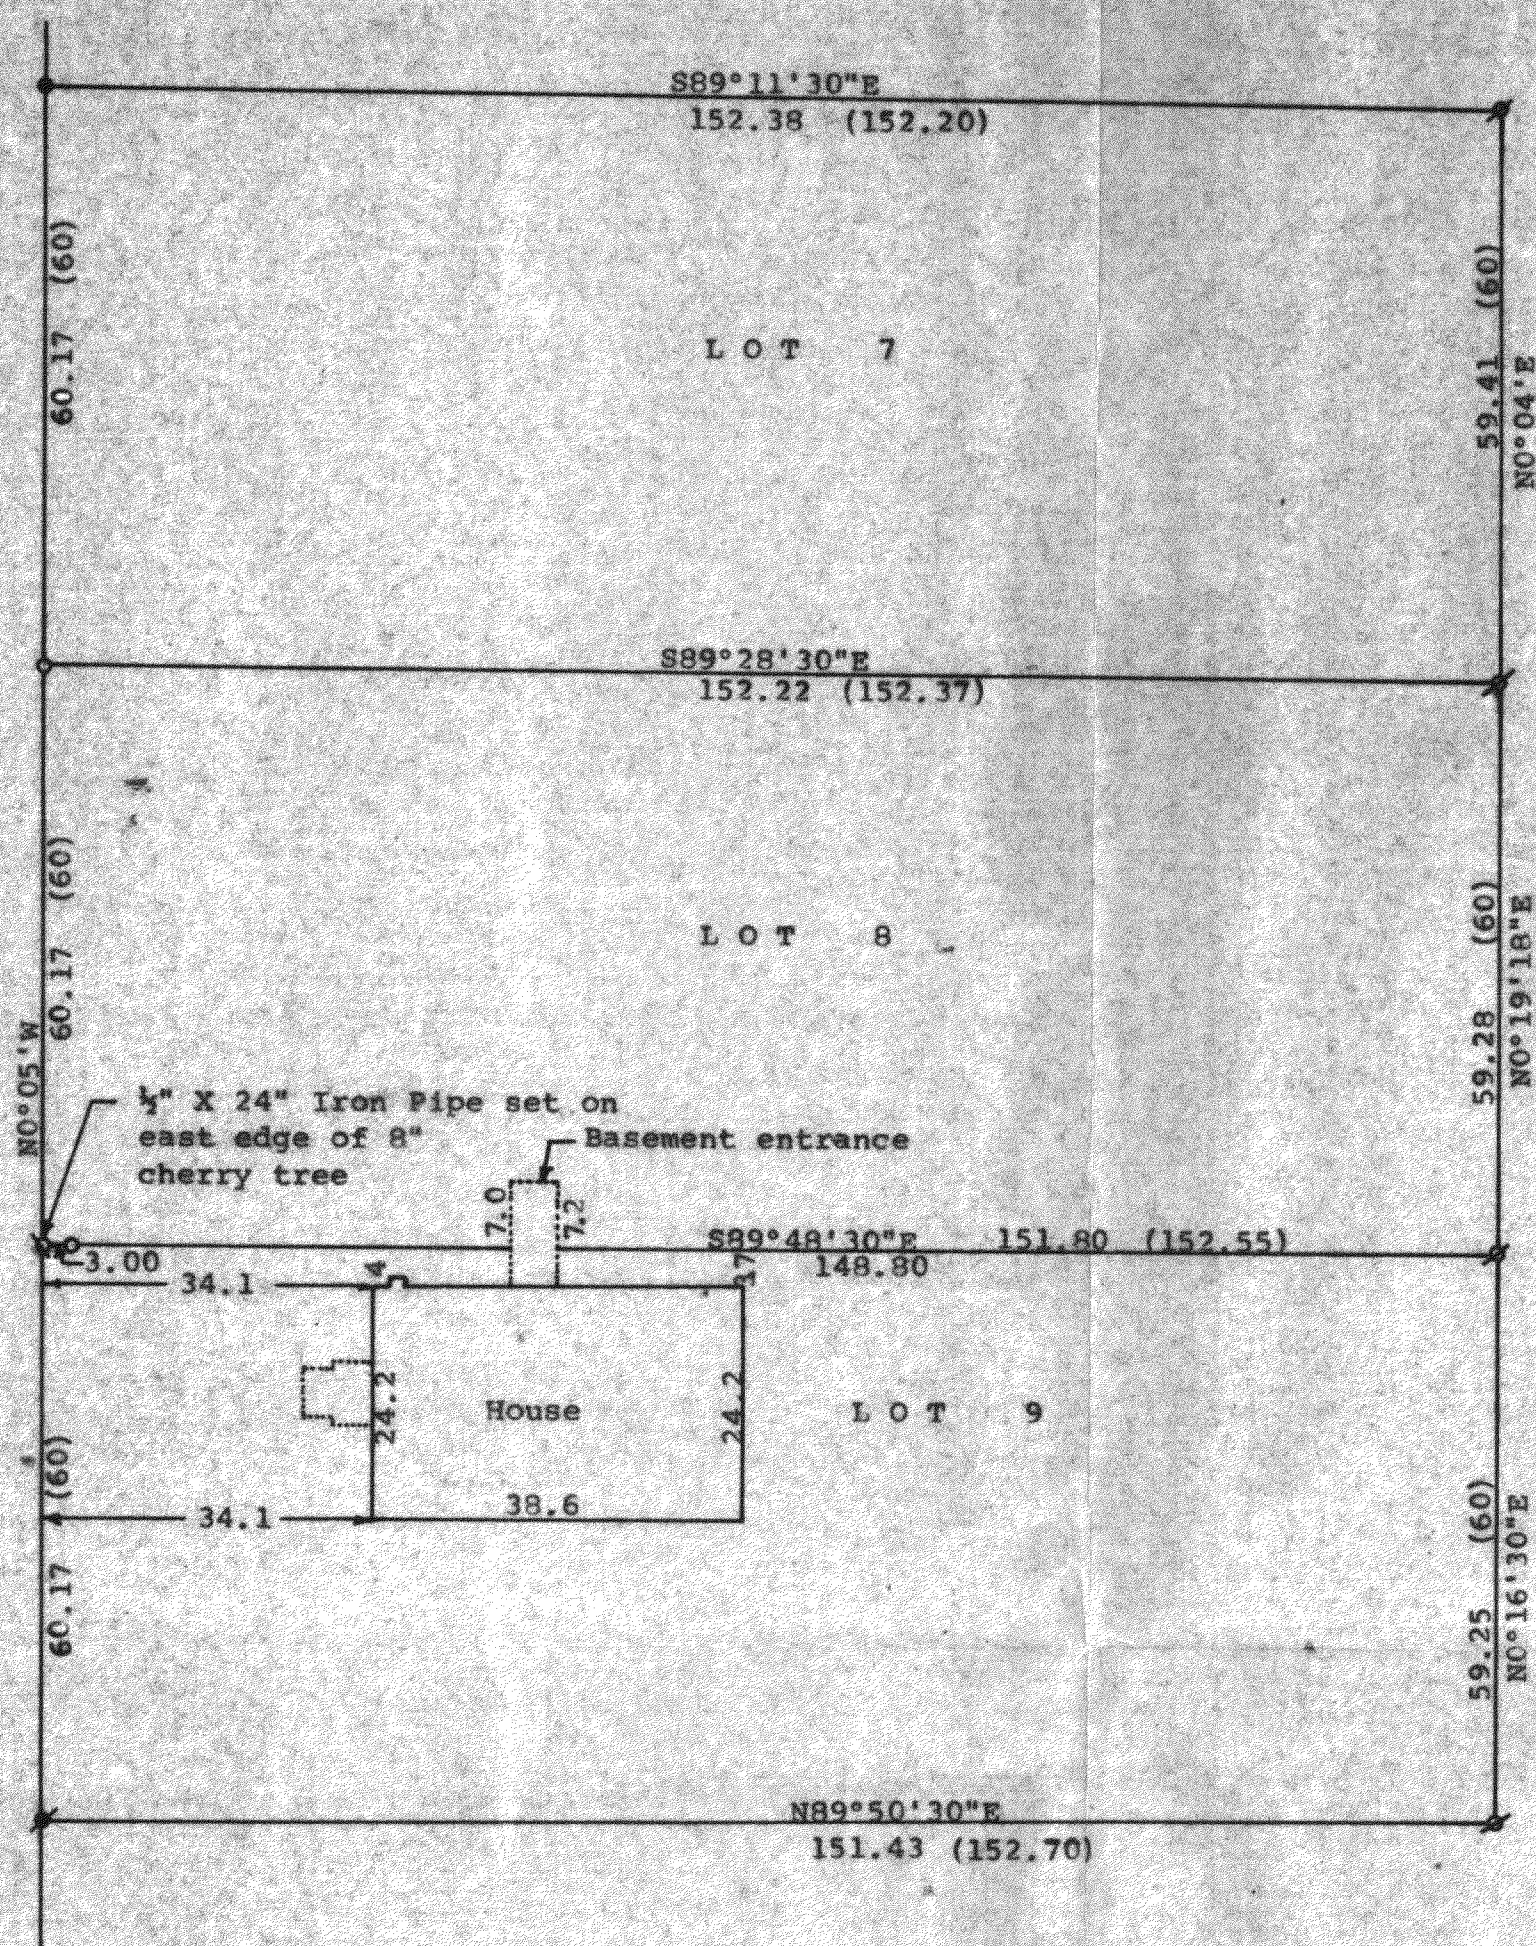

Scale - 1" = 20'
 3/4" = 3/4" Iron Pipe Found
 5/8" = 5/8" Iron Rod Found
 1/2" X 24" = 1/2" X 24" Iron Pipe Set
 3/4" X 24" = 3/4" X 24" Iron Pipe Set
 Bearings referenced to the east line of
 Cedar Point Drive with the assumed bearing
 of N0°05'W
 Survey ordered by: The Rauland Agency
 118 Kenosha
 Walworth, WI 53184
 1 1/2" = 1 1/2" Iron Pipe Found
 (0.00) = recorded distance

STATE OF WISCONSIN)
COUNTY OF WALWORTH)

I, George T. Dunham, Surveyor, certify that I have surveyed the property described as follows:

Lots 7, 8, and 9 in Block 1 of Harbor View Subdivision located in the Village of Williams Bay, Walworth County, Wisconsin and that the map shown hereon is a correct representation thereof and shows the size and location of the property, its exterior boundaries, the location of all visible structures and dimensions of all principal buildings thereon, boundary fences, apparent easements, roadways and visible encroachments, if any, and that I have surveyed the property hereon described, according to the official records, to the best of my knowledge and belief.

November 1, 1988

Revised December 13, 1988

George T. Dunham
George T. Dunham, Surveyor

