
#44-61

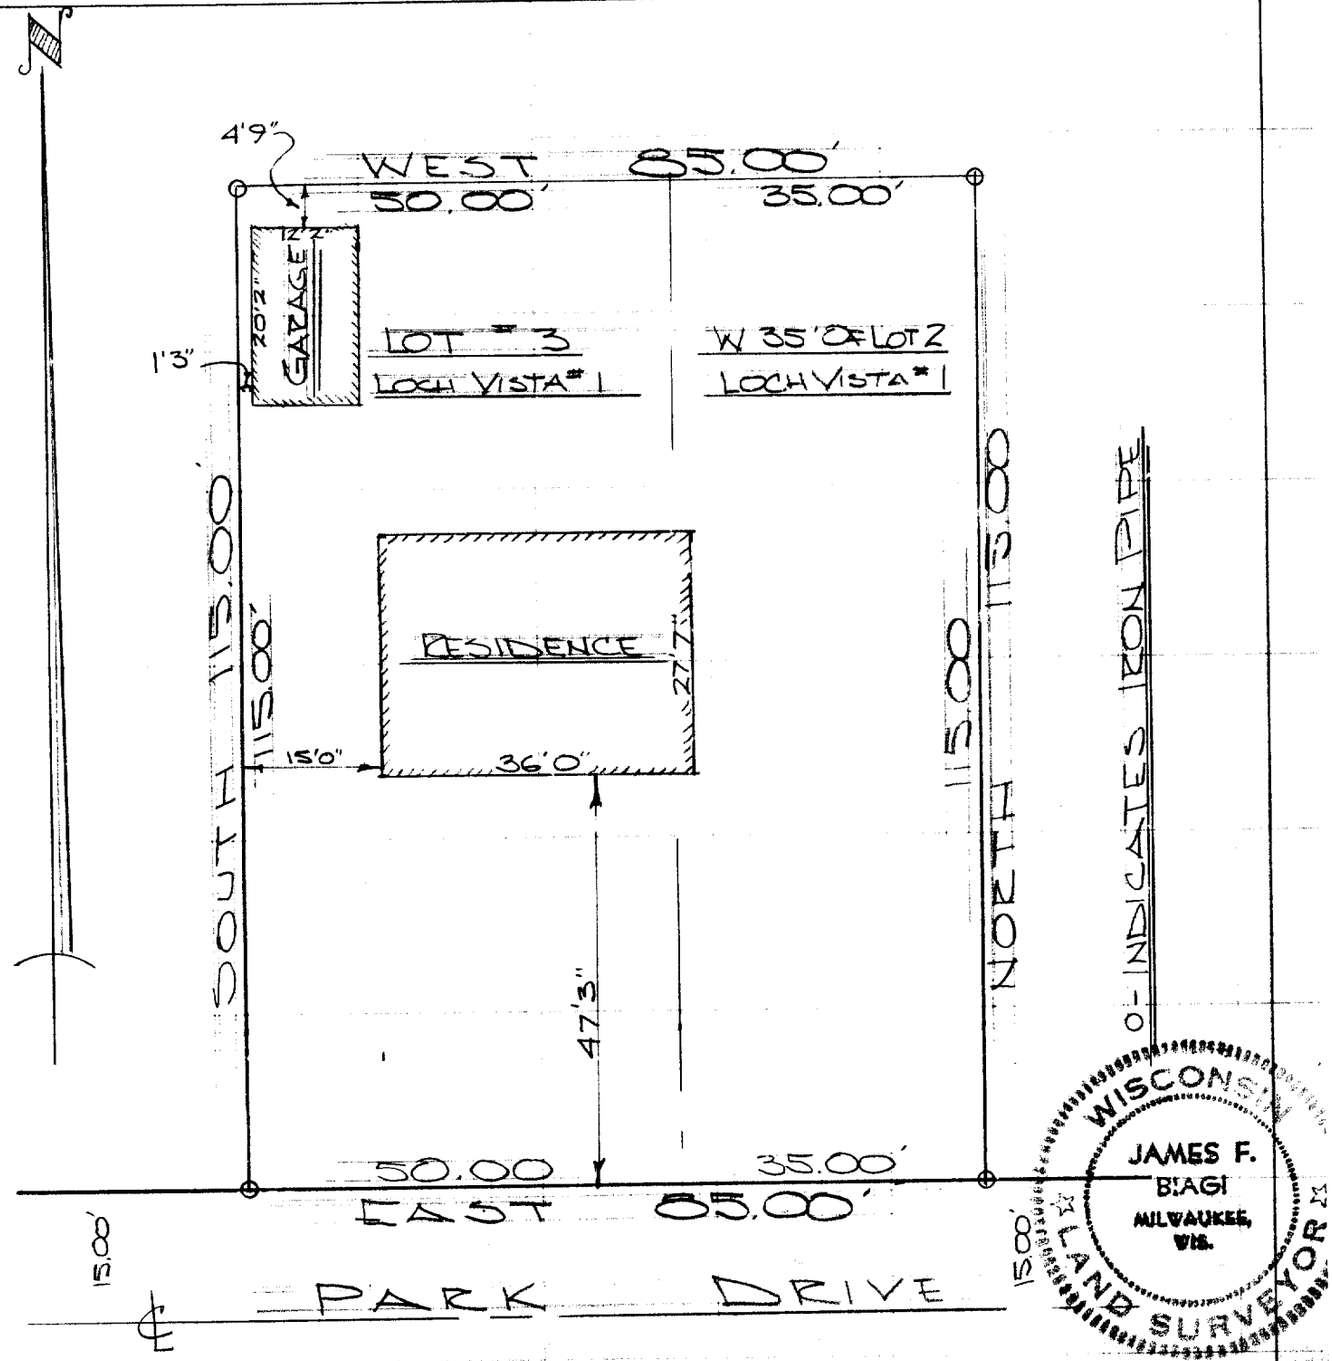

DESCRIPTION Lot 3 and the West 35.00 feet of Lot 2, in Loch Vista Club Subdivision No. 1, being in the Village of Williams Bay, Walworth County, Wisconsin.

CERTIFICATE: I, hereby certify that I have surveyed the above mentioned property and that the hereon portrayed is an accurate survey and a true representation thereof and correctly shows the exterior boundary lines and the location of the buildings and the other improvements thereof.

June 26, 1967.

James F. Biagi, RLS 272

WLV - 2

11-78