


DUNHAM SURVEYING, S.C.
SURVEYING & SUBDIVIDING
DELAVER, WISCONSIN 53115

Cross at Lot Corner located 0.5' southeasterly
of the northwesterly side of the 2nd concrete
step.

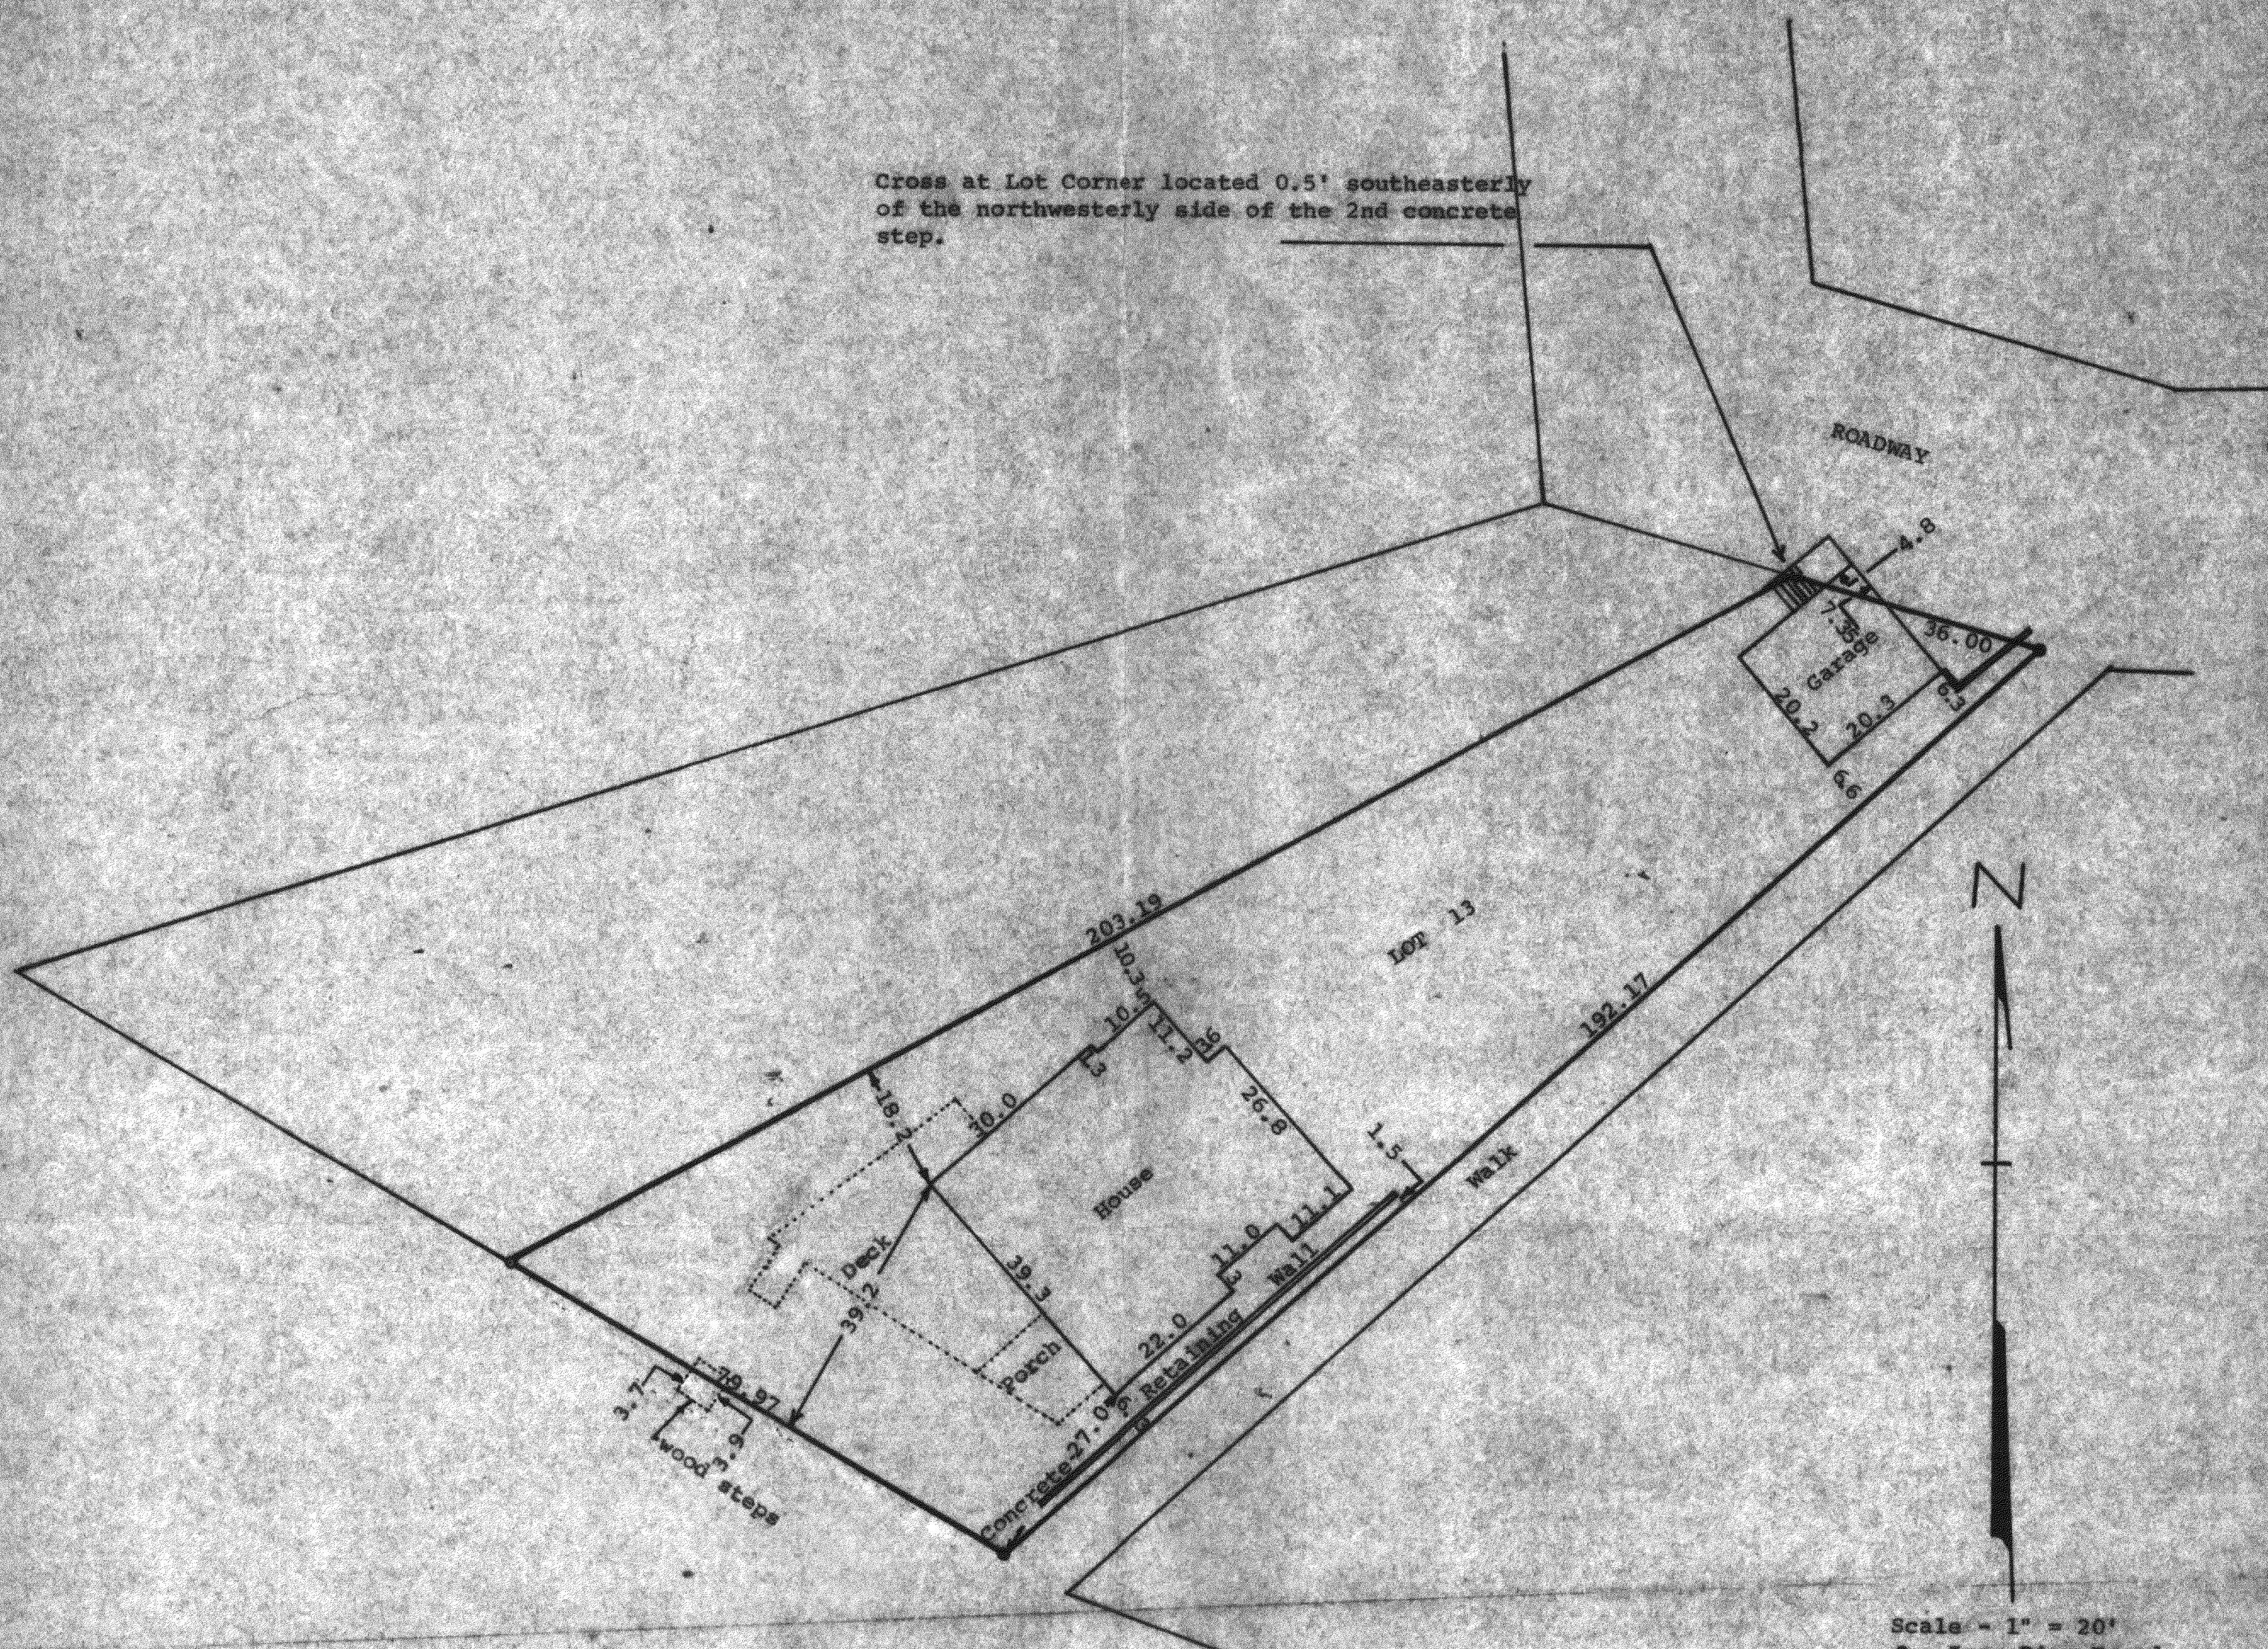

Scale - 1" = 20'
o = Iron Pipe Found
x = Cross in Concrete Found
• = Concrete Monument Found

STATE OF WISCONSIN) SS
COUNTY OF WALWORTH)

I, George T. Dunham, Surveyor, certify that I have surveyed the
property described as follows:

Lot 13 in the First Addition to Cedar Point Park, located in the
Village of Williams Bay, Walworth County, Wisconsin.

and the above map is a true representation thereof and shows the size and
location of the property, its exterior boundaries, the location and
dimensions of all structures thereon, fences, apparent easements and
roadways and visible encroachments, if any.

This survey is made for the exclusive use of the present owners of the
property, and also those who purchase, mortgage, or guarantee the title
thereto within one (1) year from date hereof; and as to them I warrant the
accuracy of said survey and map.

November 29, 1978

Updated and recertified to this
17th day of October, 1990

George T. Dunham
George T. Dunham, Surveyor

