


DUNHAM SURVEYING, S.C.
SURVEYING & SUBDIVIDING
DELAVER, WISCONSIN 53115



PARKWAY

GARFIELD

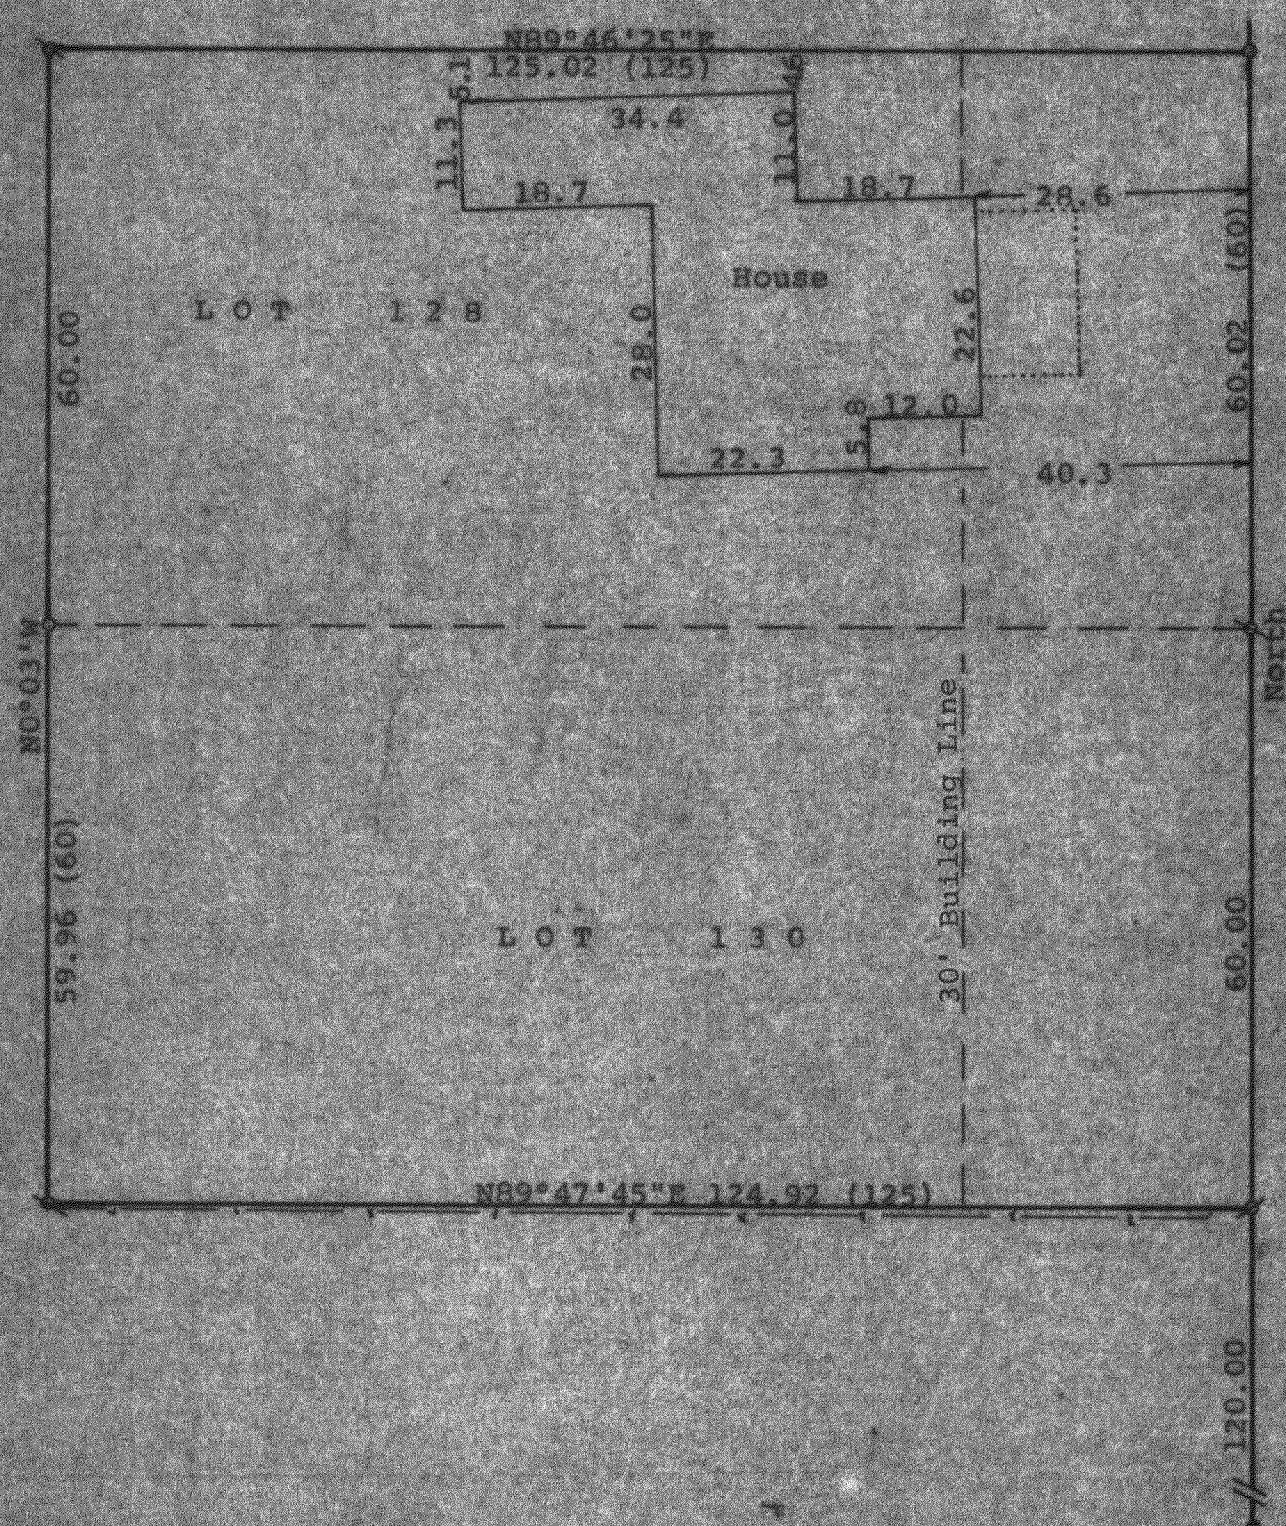

Scale - 1" = 20'
 ● = Concrete Monument Found
 ○ = 1" Iron Pipe Found laying down and reset
 ○ = 1" Iron Pipe Found
 ○ = 3/4" Iron Pipe Found
 --- = Fence Line
 Bearings referenced to the west line of Garfield Parkway with the assumed bearing of North.
 Survey ordered by:
 Tom Stelling
 P.O. Box 506
 Burlington, WI 53105

STATE OF WISCONSIN)
COUNTY OF WALWORTH)



I, George T. Dunham, Surveyor, certify that I have surveyed the property described as follows:

Lots 128 and 130 in Cedar Point Park in the Village of Williams Bay, Walworth County, Wisconsin.

and that the plat shown hereon is a correct representation thereof and shows the size and location of the property, its exterior boundaries, the location of all visible structures and dimensions of all principal buildings thereon, boundary fences, apparent easements, roadways and visible encroachments, if any, and that I have surveyed the property hereon described, according to the official records, to the best of my knowledge and belief.

September 13, 1991

George T. Dunham
George T. Dunham, Surveyor

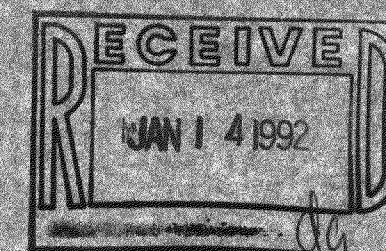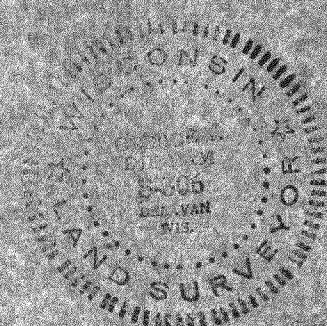

wcp-101
wcp-103

011-894